TACO BELL


DRIVE THRU RESTAURANT LIVE MAS MEDIUM54



- A. ALL WORK SHALL CONFORM TO THE 2006 EDITION OF THE INTERNATIONAL BUILDING CODE, AND ALL OTHER APPLICABLE CODES, STANDARDS, AND REGULATIONS OF THE CITY OF ROCHESTER HILLS AND COUNTY OF
- B. IT IS INTENDED THAT A COMPLETE OCCUPIABLE BUILDING PROJECT IS PROVIDED
- C. THE GENERAL CONDITIONS OF THE CONTRACT FOR CONSTRUCTION (A.I.A. A201 LATEST EDITION) ARE A PART
- D. NOT USED.
- E. NOT USED.
- F. DO NOT SCALE THESE DRAWINGS. VERIFY ALL DIMENSIONS AND CONDITIONS IN THE FIELD. ANY DISCREPANCIES IN THESE DRAWINGS SHALL BE BROUGHT TO THE ATTENTION OF THE ARCHITECT PRIOR TO
- G. ALL PROPOSED SUBSTITUTIONS SHALL BE APPROVED BY THE YUM BRANDS CONSTRUCTION MANAGER, IN
- H. RETAIN THE PROJECT GEOTECHNICAL ENGINEER TO PROVIDE OBSERVATION AND TESTING SERVICES DURING THE GRADING (INCLUDING UTILITY TRENCHES) AND FOUNDATION PHASE OF CONSTRUCTION AS RECOMMENDED IN THE GEOTECHNICAL REPORT. ALL TESTING AND INSPECTION REPORTS, INCLUDING FINAL SUMMATION LETTER, SHALL BE SUBMITTED TO THE BUILDING DEPARTMENT AND OWNER. G.C. SHALL CERTIFY PAD ELEVATION PRIOR TO START OF FOUNDATION WORK.
- SUBMIT PAY FEES AND OBTAIN ALL PERMITS ASSOCIATED WITH THE PROJECT EXCEPT GENERAL BUILDING PERMIT. THIS INCLUDES, BUT IS NOT LIMITED TO ELECTRICAL, MECHANICAL, PLUMBING, FIRE SPRINKLER, HOOD ANSUL, OR OTHER RELATED FIRE PERMITS, ENCROACHMENT PERMIT, ETC. YUM BRANDS WILL PAY FOR "CONNECTION FEES" ASSOCIATED WITH UTILITY PERMITS. PAY FOR TEMPORARY FACILITIES FEES AS REQUIRED TO COMPLETE THE WORK IN A TIMELY MANNER.
- J. PROVIDE EACH SUBCONTRACTOR WITH A COMPLETE AGENCY-PERMITTED DRAWING SET AT TIME OF
- K. ALL ABBREVIATIONS INCLUDED FOLLOW INDUSTRY STANDARDS. CONTACT ARCHITECT IF ANY ABBREVIATIONS

PROJECT GENERAL NOTES

- . GC SHALL SUPPLY AND INSTALL ALL ASPECTS OF THE PROJECT DESCRIBED IN THIS DRAWING SET UNLESS OTHERWISE NOTED. SEE SCOPE OF WORK FOR EXCEPTIONS.
- M. GRAPHIC AND WRITTEN INFORMATION ON DRAWINGS SHALL BE COORDINATED WITH ALL TRADES PRIOR TO INSTALLATION.

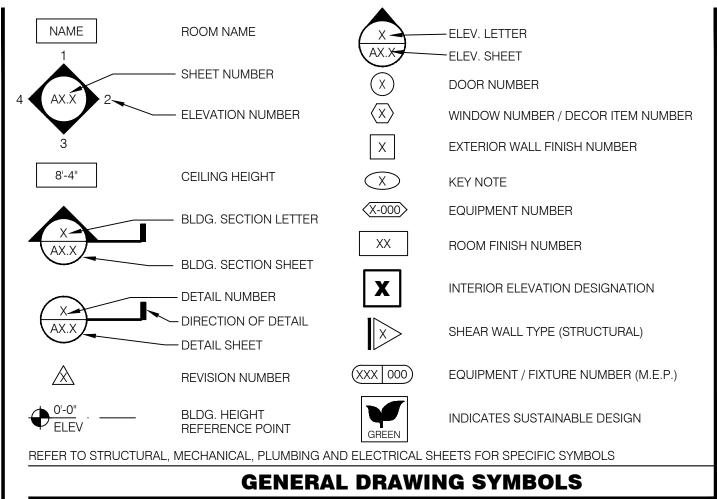



VICINITY MAP

WATER **ROADS** City of Rochester Hills - Department of Public Services Oakland County Road Commission 1000 Rochester Hills Dr. 2420 Pontiac Lake Rd. Rochester Hills, MI 48309 Waterford Township, MI 48328 Contact: Paul Davis Contact: Danette Brewer Phone: (248) 656-4640 Phone: (248) 858-4836 GAS TRASH Republic Services DTE Energy P.O. Box 740786 Contact Edith Cincinnati, OH 45274-0786 Phone: (734) 641-3555 Contact: Mark cetnor Phone: (248) 427-2200 **ELECTRIC HEALTH DEPARTMENT** Oakland County Health Department 17227 Seven Mile Rd. W 27725 Greenfield Rd. Detroit, MI 48235 Southfield, MI 48076 Phone: (800) 388-0178 Contact: Josh Nelson - Plan Checker Phone: (248) 424-7095 UTILITY CONTACTS

LEGAL JURISDICTION: CITY OF ROCHESTER HILLS

TYPE CONSTRUCTION: TYPE VB NON-SPRINKLERED

ACTUAL BUILDING AREA: 2,159 S.F.

ACTUAL BUILDING HEIGHT: 22'-1"

BUILDING OCCUPANT LOAD - SEATING: 54

PHONE LINES: 25 PAIR CABLE IN 2" CONDUIT

WIND SPEED: 90 M.P.H. / EXPOSURE B

ELECTRIC SERVICE: 600 AMPS / 3 PHASE / 120-208 VOLT

ALLOWABLE BUILDING AREA (PER MBC TABLE 503): 6,000 S.F.

ALLOWABLE BUILDING HEIGHT (PER MBC TABLE 503): 1 STORY (40'-0")

DESIGN CRITERIA

LEGAL DESCRIPTION

19100 Von Karman Avenue, Suite 600

19100 Von Karman Avenue, Suite 600

19100 Von Karman Avenue, Suite 600

CIVIL ENGINEER

31080 SW Regency Pkwy, Ste2

STRUCTURAL ENGINEER

MECH. / ELEC. ENGINEER

ARCHITECT

Contact: Deanna Hinkle Phone: (949) 753-7676

WD PARTNERS

Irvine, CA 92612

WD PARTNERS

Irvine, CA 92612 Contact: Alan Woo

Irvine, CA 92612 Contact: Yasser Zaki

Phone: (949) 753-7676

Bentonville, AR 72712

Contact: Charles Ashley

Phone: (479) 273-9472

PROJECT DIRECTORY

TELEPHONE

Phone: (855) 424-7148

Phone: (949) 753-7676

OCCUPANCY: A2

GAS: 689,900 BTUH

EARTHQUAKE ZONE: B

ROOF LIVE LOAD: 25 P.S.F

REFER TO CIVIL DRAWINGS.

SEWER

1000 Rochester Hills Dr.

Rochester Hills, MI 48309 Contact: Paul Davis Phone: (248) 656-4640

City of Rochester Hills - Department of Public Services

REVISION / DATE BUILDING CODE: 2012 Michigan Building Code, 2012 Michigan Mechanical Code, 2012 Michigan Plumbing Code, 2011 NEC (State of Michigan Electrical Code), 2012 IFC, 2012 MBC-Chp13 & MUEC 2009, and 2009 Michigan Food Law TITLE/SITE T1.0 TITLE SHEET CIVIL/LANDSCAPE SEE CIVIL COVER INDEX SHEET CS QUEUING: 11 (1 OCCUPANT PER 5 SF NET OF QUEUING AREA) **ARCHITECTURAL** A1.0 FLOOR PLAN A2.0 EQUIPMENT AND SEATING PLAN EXTERIOR ELEVATIONS EXTERIOR ELEVATIONS A6.5 SITE DETAILS PROJECT SUMMARY

19100 VON KARMAN AVE. SUITE 600 **IRVINE**, CA 92612 949.753.7676 T

WDPARTNERS.COM

$\overline{\mathbb{A}}$	11.19.2014
<u> </u>	12.19.2014
\triangle	
CONTRACT DATE:	10.03.2014
	40 MEDIUM 45 4

TACO BELL



CITY FILE #14-015


TITLE SHEET

SHEET INDEX

BUILDING TYPE: LIVE MAS MEDIUM54

SITE NUMBER: STORE NUMBER: 427918

2234-2248 CROOKS RD. ROCHESTER HILLS, MI 48309

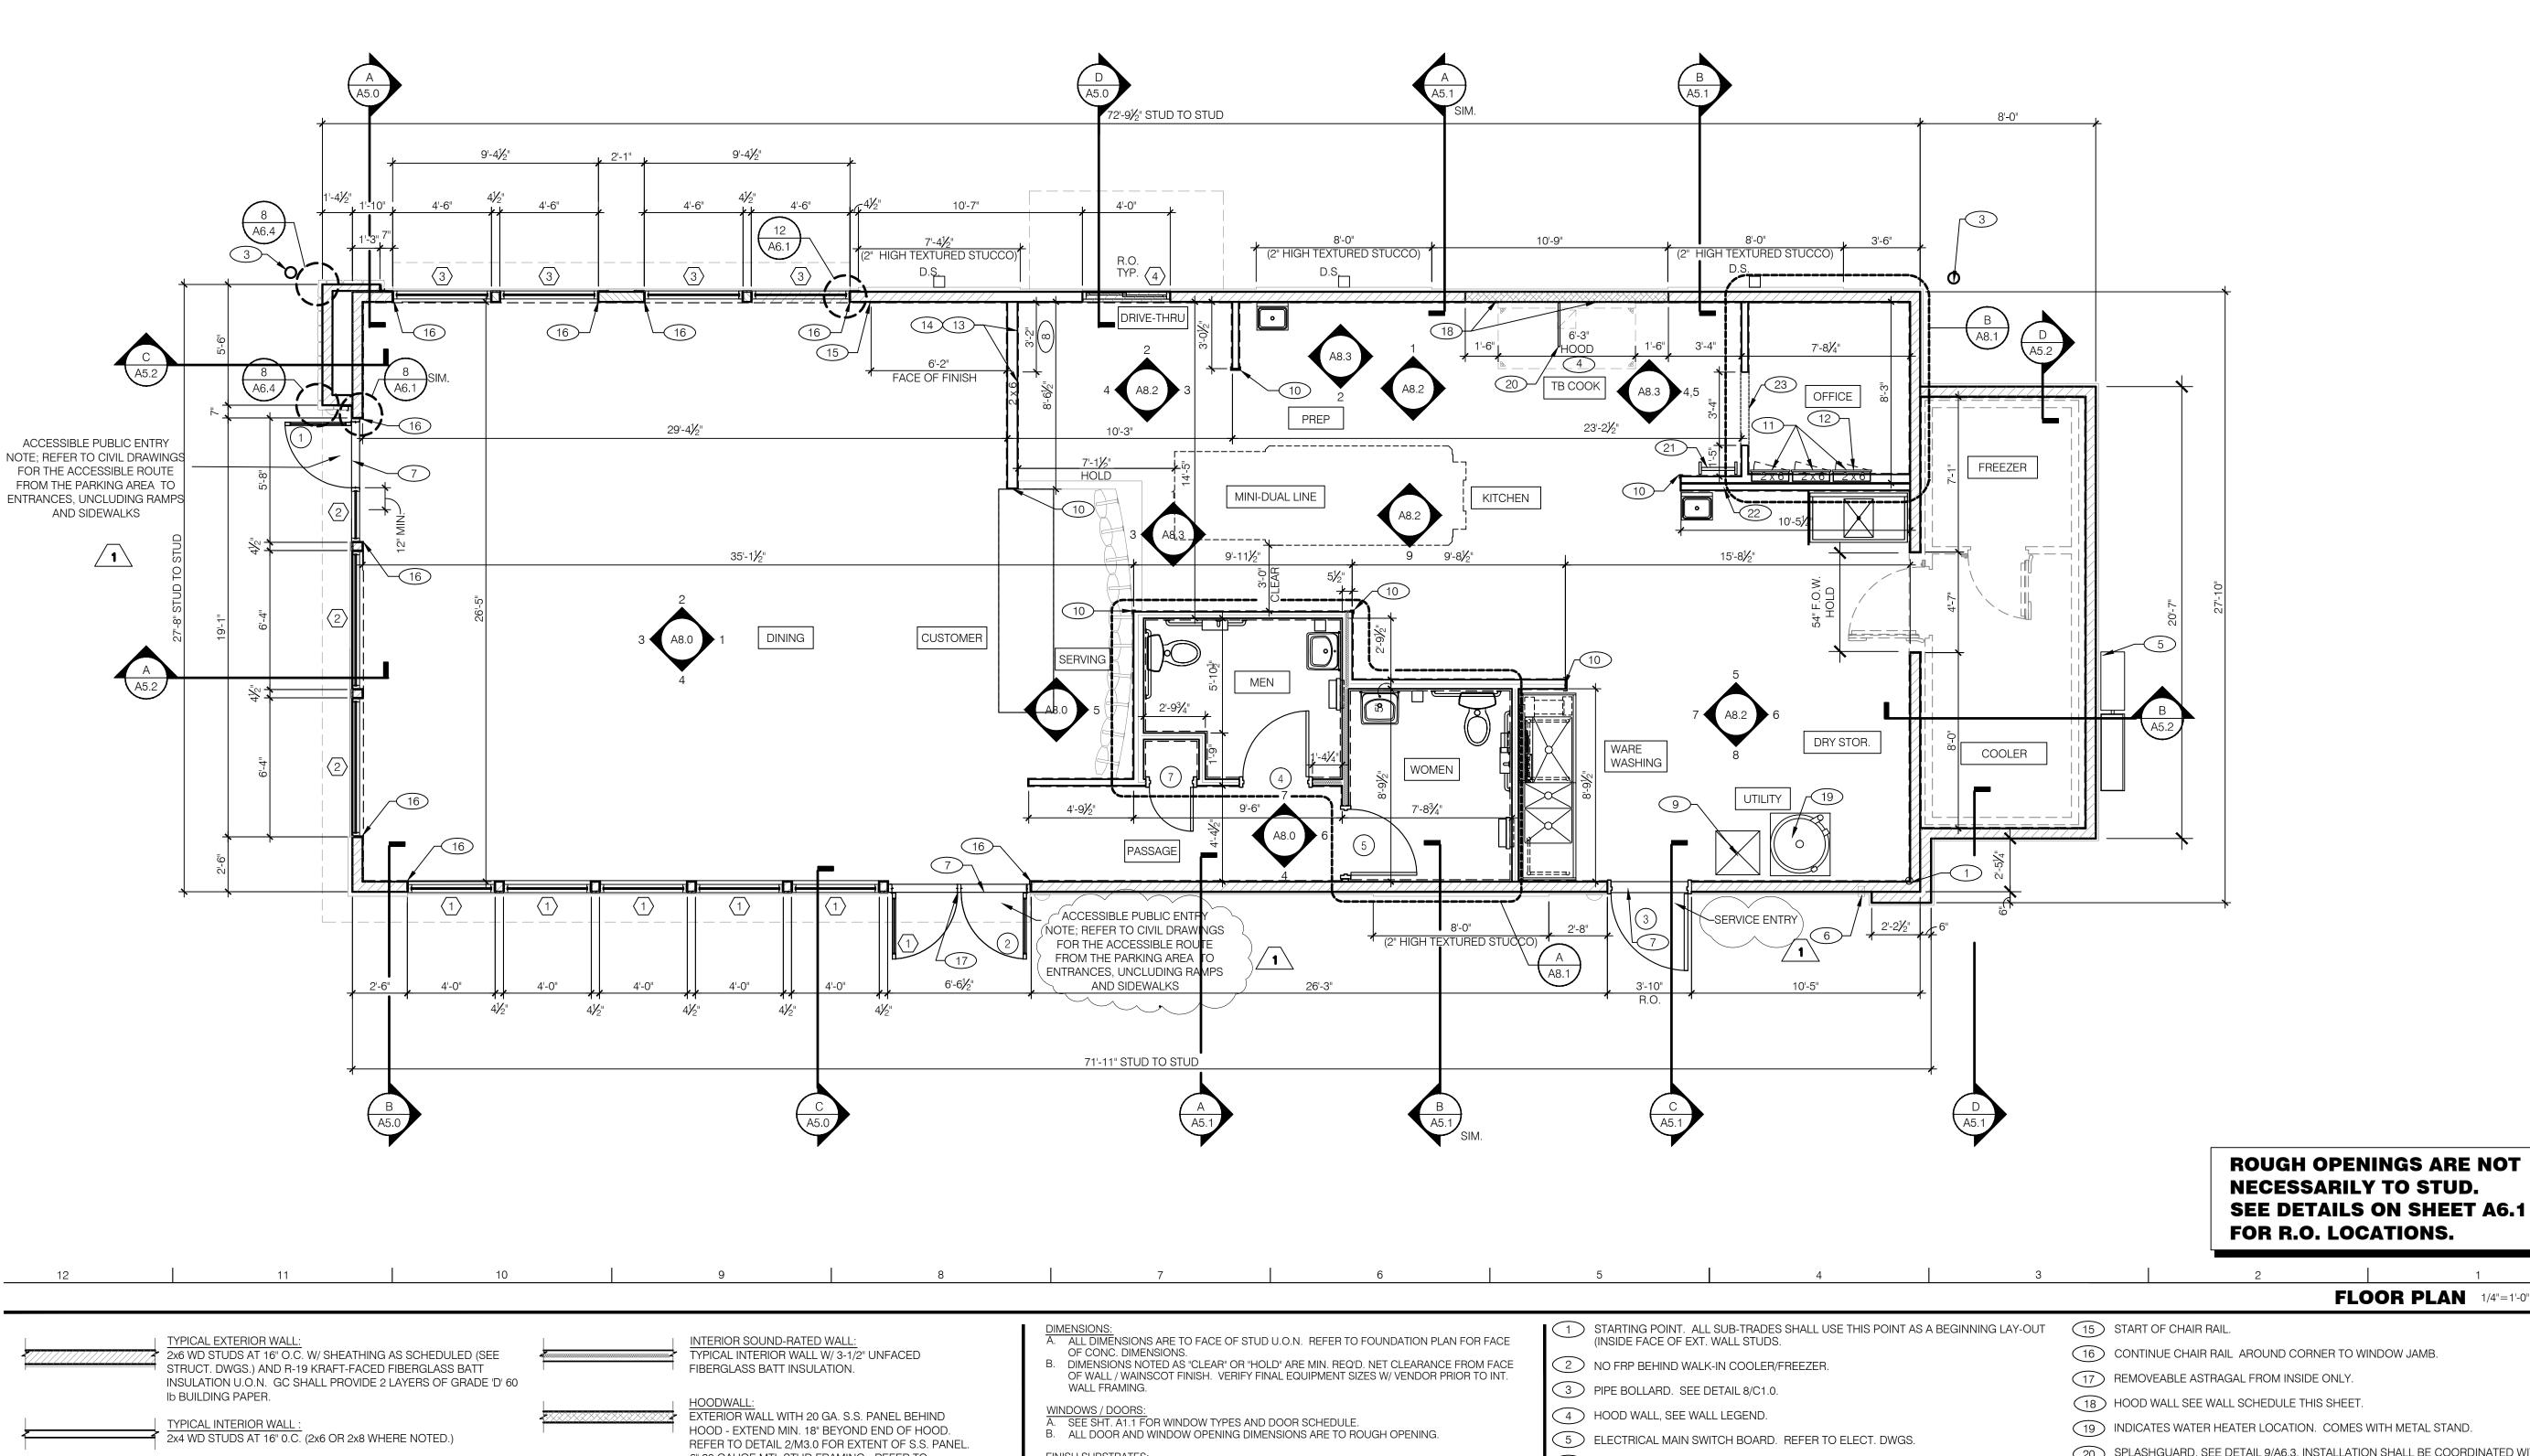

FLOOR PLAN 1/4"=1'-0" A

6" 20 GAUGE MTL STUD FRAMING - REFER TO STRUCTURAL FOR EXTENT.

---- DASHED LINE INDICATES INTERIOR SUBSTRATE LOCATION.

WALL LEGEND

1/2" GYPSUM WALLBOARD FROM T.O. CURB/SLAB TO 6" ABOVE CEILING HEIGHT U.O.N. SEE 6 & 16 / A6.3. (NOTE: THE CEMENT BOARD SPECIFICATION IS DESIGNED

TO ALLOW THE G.C. FLEXIBLITY.) - KITCHEN WALLS AND DINING ROOM CLOSET

1/2" CEMENT WALLBOARD FROM T.O. SLAB WITH 1/2" CDX PLYWOOD W/FRP SURFACE FINISH TO 6" ABOVE CEILING HEIGHT U.O.N. IF DOUBLE SIDED SHEAR WALL PLYWD IS SPECIFIED THE PLYWOOD SHALL SHALL BE CONTINUOUS FROM SILL PLATE TO TOP PLATE. SEE 4, 11 & 20 / A6.3.

5/8" CEMENT WALLBOARD FROM T.O. SLAB OR T.O. CONCRETE CURB TO 48" A.F.F. WITH 5/8" HI-IMPACT BRAND XP WALLBOARD, TYPE X CORE FROM T.O. CEMENT BOARD TO 6" ABOVE CEILING HEIGHT U.O.N.. NO SUBSTITUTIONS ALLOWED. FINISH AS SCHEDULED. SEE 11 (SIM), 12 /A6.3. - ALL OTHER FRAME WALL CONDITIONS:

1/2" CEMENT WALLBOARD FROM T.O. SLAB OR T.O. CONCRETE CURB TO 48" A.F.F., WITH 1/2" GYPSUM WALLBOARD FROM T.O. CEMENT BOARD TO 6" ABOVE CEILING

HEIGHT U.O.N. FINISH AS SCHEDULED.

A. PROVIDE 1/2" THICK CEMENTITIOUS BD. FROM FLOOR SLAB TO 12" A.F.F. MIN. IN LIEU OF GYP. BD. AT ALL WALLS EXCEPT SHEARWALL SURFACES, U.O.N.

B. ALL JOINTS, GAPS OR SPACES LEADING TO ALL HOLLOW OR INACCESSIBLE SPACES SHALL

BE SEALED WITH "NSF INTERNATIONAL" APPROVED SEALANTS. C. ALL BACK OF HOUSE AND OFFICE WALLS SHALL HAVE 1/2" CDX PLYWOOD SUBSTRATE,

A. SEE A2.0 FOR SEATING PLAN AND DETAILS.

B. SEE A7.0 FOR FLOOR FINISHES.

SEE A8.0 - A8.3 FOR WALL FINISHES. D. SEE A7.1 FOR CEILING FINISHES.

A. PROVIDE THREE FIRE EXTINGUISHERS - (2) 10 lb. BC and (1) 10 lb. ABC - TO COMPLY WITH LOCAL FIRE CODE. LOCATE PER DIRECTIÓN OF FIRE MARSHALL OR LOCAL AUTHORIZING

DRAWINGS ARE BASED UPON WOOD FRAMING. UTILIZATION OF METAL STUDS ON NON-BEARING INTERIOR PARTITIONS, BULKHEADS AND SOFFITS IS ACCEPTABLE.

PREVENT DAMAGE TO THE FINISH, PER 9/A6.2. D. ALL PENETRATIONS THROUGH HIGH TEXTURED STUCCO SHALL BE SEALED USING MFR'S. APPROVED METHOD.

C. ALL ATTACHMENTS MADE THROUGH HIGH TEXTURED STUCCO SHALL BE BUSHED TO

FLOOR PLAN NOTES D 6 CO2 FILL BOX LOCATION.

7 TILE TO METAL THRESHOLD.

8 KEEP CLEAR FOR UTILITIES & SYRUP LINES. SEE DETAIL 14 & 19/A6.4 FOR STUD

LAYOUT REQUIREMENTS.

9 MOP SINK. REFER TO SHEET A2.0 & A2.1.

S.S. CORNER GUARD / WALL CAP, TYP. ALL CORNERS IN BACK-OF-HOUSE FROM REAR

WALL TO THE KITCHEN SIDE OF THE SERVICE COUNTER. SEE DETAIL 19/A6.3.

11) ELECT. PANELS RECESSED IN 2x6 WALL.

12 LIGHTING CONTROL PANEL SURFACE MOUNTED. REFER TO ELECT. DWGS.

13 SYRUP LINE CHASE (ABOVE). SEE DETAIL 19/A6.4.

6"x6" HORIZONTAL OPENING FOR SYRUP TUBES. COORDINATE WALL PENETRATION WITH COUNTER INSTALLER. SEAL CHASE TO COUNTER. SEE 11/A6.4.

20 SPLASHGUARD. SEE DETAIL 9/A6.3. INSTALLATION SHALL BE COORDINATED WITH

INSTALLATION OF MOP SINK.

22) ADD SECOND 2X4 WALL ON KITCHEN SIDE.

KEY NOTES

21 ROOF LADDER. SEE 7/A6.0.

CASED OPENING, REFER TO DETAIL 6/A6.4. DOOR OPTIONAL, REFER TO DOOR SCHEDULE ON A1.1 (DOOR #6).

CITY FILE #14-015

CONTRACT DATE:

PLAN VERSION:

SITE NUMBER: STORE NUMBER:

BUILDING TYPE: LIVE MAS MEDIUM54

TACO BELL

2234-2248 CROOKS RD.

ROCHESTER HILLS, MI 48309

11.19.2014

JUNE 2014

427918

NO CHANGES 12.19.2014

19100 VON KARMAN AVE.


SUITE 600

IRVINE, CA 92612

WDPARTNERS.COM

949.753.7676 T

FLOOR PLAN

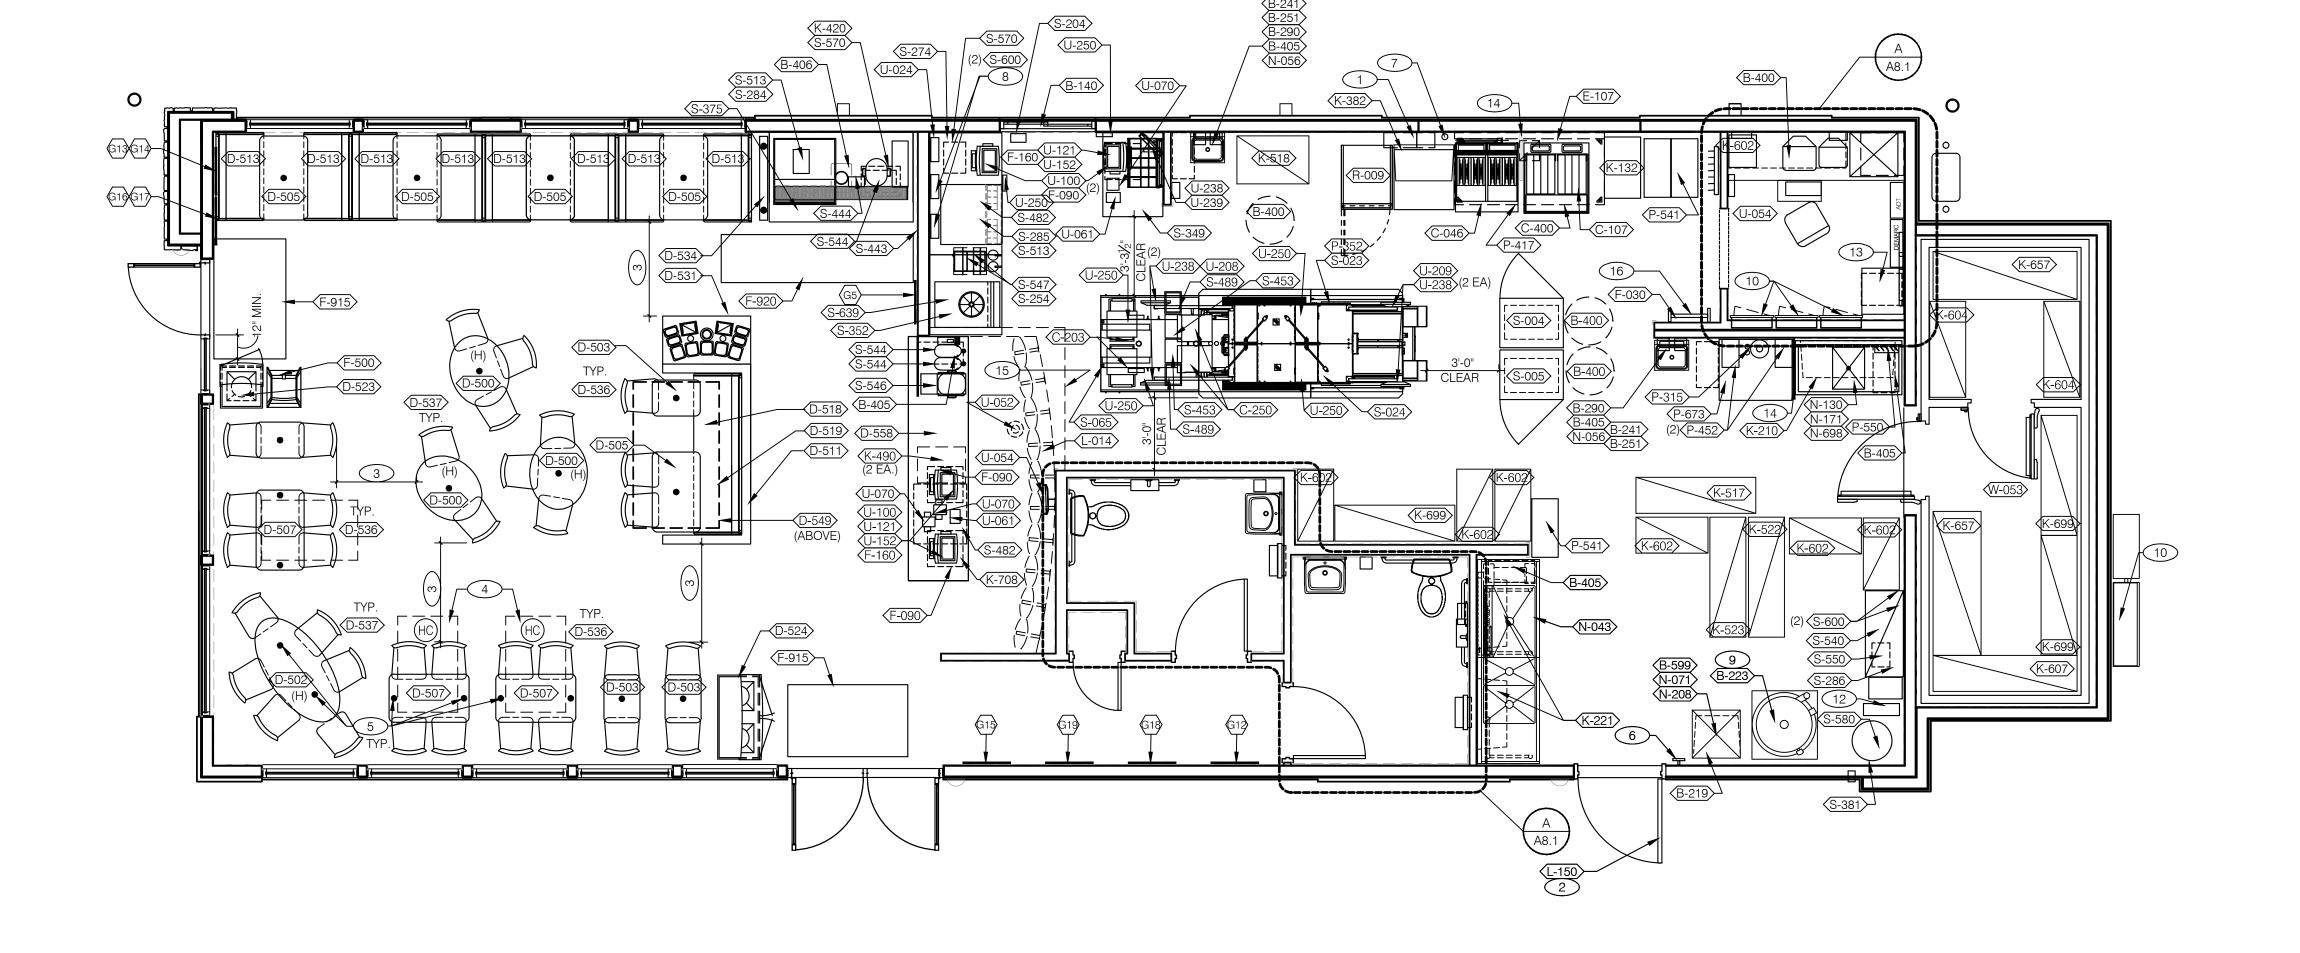

⊕500 3 TABLE - OVAL - BAR HEIGHT - 24" X 30" - CORE DRILL BASE ⊕534 1 SCREEN WALL ⊕502 1 TABLE - OVAL - BAR HEIGHT - 30" X 60" - CORE DRILL BASE ⊕536 21 FORMED WOOD SHELL DINING CHAIR ⊕503 4 TABLE - RECTANGLE - STD HEIGHT - 18" X 24" - CORE DRILL BASE ⊕537 14 FORMED WOOD SHELL DINING CHAIR ⊕505 5 TABLE - RECTANGLE - STD HEIGHT - 24" X 40" - CORE DRILL BASE ⊕539 1 SOFFIT BY DISTRIBUTOR. ⊕510 1 DIVIDER WALL - 90" LONG ⊕510 H SOFFIT BY DISTRIBUTOR. ⊕513 8 OPEN BACK BENCH SETTEE - 42" ⊕513 H BACKLESS BENCH SETTEE - 42" ⊕523 1 SINGLE TRASH RECEPTACLE ⊕523 H DOUBLE TRASH RECEPTACLE ⊕523 ⊕533 1 SERVICE COUNTER - 127" ⊕533 H CONDIMENT COUNTER - SQAURE CORNERS	SYM.	QTY.	ITEM	SYM.	QTY.	
①-503 4 TABLE - RECTANGLE - STD HEIGHT - 18" X 24" - CORE DRILL BASE ①-537 14 FORMED WOOD SHELL DINING CHAIR ①-503 5 TABLE - RECTANGLE - STD HEIGHT - 24" X 40" - CORE DRILL BASE ①-549 1 SOFFIT BY DISTRIBUTOR. ①-507 3 TABLE - RECTANGLE - STD HEIGHT - 24" X 40" - CORE DRILL BASE (ADA) □-549 1 SOFFIT BY DISTRIBUTOR. ①-511 1 DIVIDER WALL - 90" LONG □-513 8 OPEN BACK BENCH SETTEE - 42" ①-513 1 BACKLESS BENCH SETTEE - 38" □-519 1 BACKLESS BENCH SETTEE - 42" ①-519 1 BACKLESS BENCH SETTEE - 42" □-523 1 SINGLE TRASH RECEPTACLE ①-522 1 DOUBLE TRASH RECEPTACLE □-558 1 SERVICE COUNTER - 127"	(D-500)	3	TABLE - OVAL - BAR HEIGHT - 24" X 30" - CORE DRILL BASE	(D-534)	1	SCREEN WALL
①-503 5 TABLE - RECTANGLE - STD HEIGHT - 24" X 40" - CORE DRILL BASE (○-549) 1 SOFFIT BY DISTRIBUTOR. ②-500 3 TABLE - RECTANGLE - STD HEIGHT - 24" X 40" - CORE DRILL BASE (ADA) (□-511) 1 DIVIDER WALL - 90" LONG (□-513) 8 OPEN BACK BENCH SETTEE - 42" (□-518) 1 BACKLESS BENCH SETTEE - 38" (□-519) 1 BACKLESS BENCH SETTEE - 42" (□-523) 1 SINGLE TRASH RECEPTACLE (□-524) 1 DOUBLE TRASH RECEPTACLE (□-558) 1 SERVICE COUNTER - 127" (□-558) 1 SERVICE COUNTER - 127" (□-558) 1 SERVICE COUNTER - 127" (□-549) 1 SOFFIT BY DISTRIBUTOR.	(D-502)	1	TABLE - OVAL - BAR HEIGHT - 30" X 60" - CORE DRILL BASE	(D-536)	21	FORMED WOOD SHELL DINING CHAIR
①-507 3 TABLE - RECTANGLE - STD HEIGHT - 24" X 40" - CORE DRILL BASE (ADA) ①-511 1 DIVIDER WALL - 90" LONG ①-513 8 OPEN BACK BENCH SETTEE - 42" ①-518 1 BACKLESS BENCH SETTEE - 38" ①-519 1 BACKLESS BENCH SETTEE - 42" ①-523 1 SINGLE TRASH RECEPTACLE ①-524 1 DOUBLE TRASH RECEPTACLE ①-558 1 SERVICE COUNTER - 127"	(D-503)	4	TABLE - RECTANGLE - STD HEIGHT - 18" X 24" - CORE DRILL BASE	(D-537)	14	FORMED WOOD SHELL DINING CHAIR
①-511 1 DIVIDER WALL - 90" LONG ②-513 8 OPEN BACK BENCH SETTEE - 42" ②-518 1 BACKLESS BENCH SETTEE - 38" ③-519 1 BACKLESS BENCH SETTEE - 42" ③-523 1 SINGLE TRASH RECEPTACLE ①-524 1 DOUBLE TRASH RECEPTACLE ①-558 1 SERVICE COUNTER - 127"	(D-505)	5	TABLE - RECTANGLE - STD HEIGHT - 24" X 40" - CORE DRILL BASE	(D-549)	1	SOFFIT BY DISTRIBUTOR.
①-513 8 OPEN BACK BENCH SETTEE - 42" ②-518 1 BACKLESS BENCH SETTEE - 38" ②-519 1 BACKLESS BENCH SETTEE - 42" ②-523 1 SINGLE TRASH RECEPTACLE ③-524 1 DOUBLE TRASH RECEPTACLE ③-558 1 SERVICE COUNTER - 127"	(D-507)	3	TABLE - RECTANGLE - STD HEIGHT - 24" X 40" - CORE DRILL BASE (ADA)			
⊕-518 1 BACKLESS BENCH SETTEE - 38" ⊕-519 1 BACKLESS BENCH SETTEE - 42" ⊕-523 1 SINGLE TRASH RECEPTACLE ⊕-524 1 DOUBLE TRASH RECEPTACLE ⊕-558 1 SERVICE COUNTER - 127"	(D-511)	1	DIVIDER WALL - 90" LONG			
(D-519) 1 BACKLESS BENCH SETTEE - 42" (D-523) 1 SINGLE TRASH RECEPTACLE (D-524) 1 DOUBLE TRASH RECEPTACLE (D-558) 1 SERVICE COUNTER - 127"	(D-513)	8	OPEN BACK BENCH SETTEE - 42"			
(D-523) 1 SINGLE TRASH RECEPTACLE (D-524) 1 DOUBLE TRASH RECEPTACLE (D-558) 1 SERVICE COUNTER - 127"	(D-518)	1	BACKLESS BENCH SETTEE - 38"			
(□-524) 1 DOUBLE TRASH RECEPTACLE (□-558) 1 SERVICE COUNTER - 127"	(D-519)	1	BACKLESS BENCH SETTEE - 42"			
(D-558) 1 SERVICE COUNTER - 127"	(D-523)	1	SINGLE TRASH RECEPTACLE			
	(D-524)	1	DOUBLE TRASH RECEPTACLE			
(D-531) 1 CONDIMENT COUNTER - SQAURE CORNERS	(D-558)	1	SERVICE COUNTER - 127"			
	(D-531)	1	CONDIMENT COUNTER - SQAURE CORNERS			

SEATING PACKAGE - BY SEATING VENDOR U.O.N. (TOTAL SEATS = 54)

⟨X⟩	QTY.	ITEM	REMARKS				
(G12)	1	TASTE EXPLOSION 1 OF 4	SEE A8.0 FOR LOCATION				
G15	1	TASTE EXPLOSION 2 OF 4	SEE A8.0 FOR LOCATION				
G18	1	TASTE EXPLOSION 3 OF 4	SEE A8.0 FOR LOCATION				
(G19)	1	TASTE EXPLOSION 4 OF 4	SEE A8.0 FOR LOCATION				
(G13)	1	VOLCANO TARGET	SEE A8.0 FOR LOCATION				
(G14)	1	NYC TACO TAXI	SEE A8.0 FOR LOCATION				
(G16)	1	TACO NIGHT TIME	SEE A8.0 FOR LOCATION				
(G1)	1	TACO BEACH BELL	SEE A8.0 FOR LOCATION				
(G5)	1	NUTRITION BOARD	SEE A8.0 FOR LOCATION				
	I	l					
	ARTWORK SCHEDULE D						

DECOR

1. REFER TO SC SHEETS FOR SCOPE OF WORK RESPONSIBILITIES.

2. (H) - SYMBOL DENOTES A HIGH TABLE OR DINING COUNTER WITH STOOLS.

SHELVING QUANTITIES REQUIRED

3. HC)- SYMBOL DENOTES A HANDICAP ACCESSIBLE TABLE.

GENERAL NOTES

STORAGE TYPE	LINEAR FT.
DRY STORAGE	40
COLD STORAGE	21
FROZEN STORAGE	14

EQUIPMENT/SEATING PLAN 1/4"=1'-0" A 1 HOOD FIRE SUPPRESSION SYSTEM (ANSUL R-102 OR EQUAL).

2 SEE SHEET A1.1 FOR SECURITY DOOR PACKAGE.

3 MAINTAIN 36" MIN CLEAR AISLE EGRESS PATHS TO EXIT DOORS.

4 30" x 48" CLEAR FLOOR SPACE FOR HANDICAP ACCESS.

DOT INDICATES CORE DRILL LOCATION. CORE DRILL LAYOUT TO BE PROVIDED BY THE SEATING VENDOR. SEE DETAIL 7/A6.3 AND SCOPE OF WORK. CHANGE CORE DRILL BITS TO MATCH DECOR BASE SIZE TO MAINTAIN 3 /8" MAX GROUT LINE AROUND BASE

6 PULL STATION @ 3'-8" A.F.F.

7 GAS LINE DOWN TO EQUIPMENT.

8 COORDINATE LOCATION OF HORIZ PVC SYRUP CHASE THROUGH WALL TO COUNTER.

9 6" HIGH WATER HEATER PLATFORM.

10 SWITCHGEAR / ELECTRIC PANELS.

11 NOT USED.

12 8' LADDER.

13 BRINKS SAFE.

14 SPLASH GUARD. 15 ALERT LIGHT BOX FOR 3-COMP POWER SOAK.

16 ROOF LADDER.

C2

KEYNOTES

19100 VON KARMAN AVE. SUITE 600 IRVINE, CA 92612 949.753.7676 T

WDPARTNERS.COM

$\overline{\mathbb{A}}$		11.19.2014
No	O CHANGES	12.19.2014
\triangle		
$\overline{\triangle}$		
$\overline{\triangle}$		
\triangle		
$\overline{\triangle}$		
$\overline{\triangle}$		
$\overline{\triangle}$		
\triangle		
CONTRACT DA	TE:	10.03.2014
BUILDING TYPE	E:LIVE MAS I	MEDIUM54

SITE NUMBER: STORE NUMBER:

TACO BELL

PLAN VERSION:

2234-2248 CROOKS RD. ROCHESTER HILLS, MI 48309




CITY FILE #14-015

EQUIPMENT AND **SEATING PLAN**


В


NOTE: ALL SIGNS MUST MEET CHAPTER 134 OF THE CITY CODE OF ORDINANCES AND BE APPROVED UNDER A SEPARATE PERMIT ISSUED BY THE BUILDING DEPARTMENT.

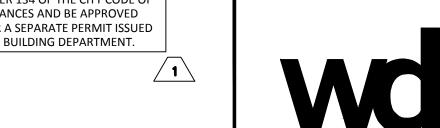

19100 VON KARMAN AVE. SUITE 600 **IRVINE, CA 92612** 949.753.7676 T

WDPARTNERS.COM

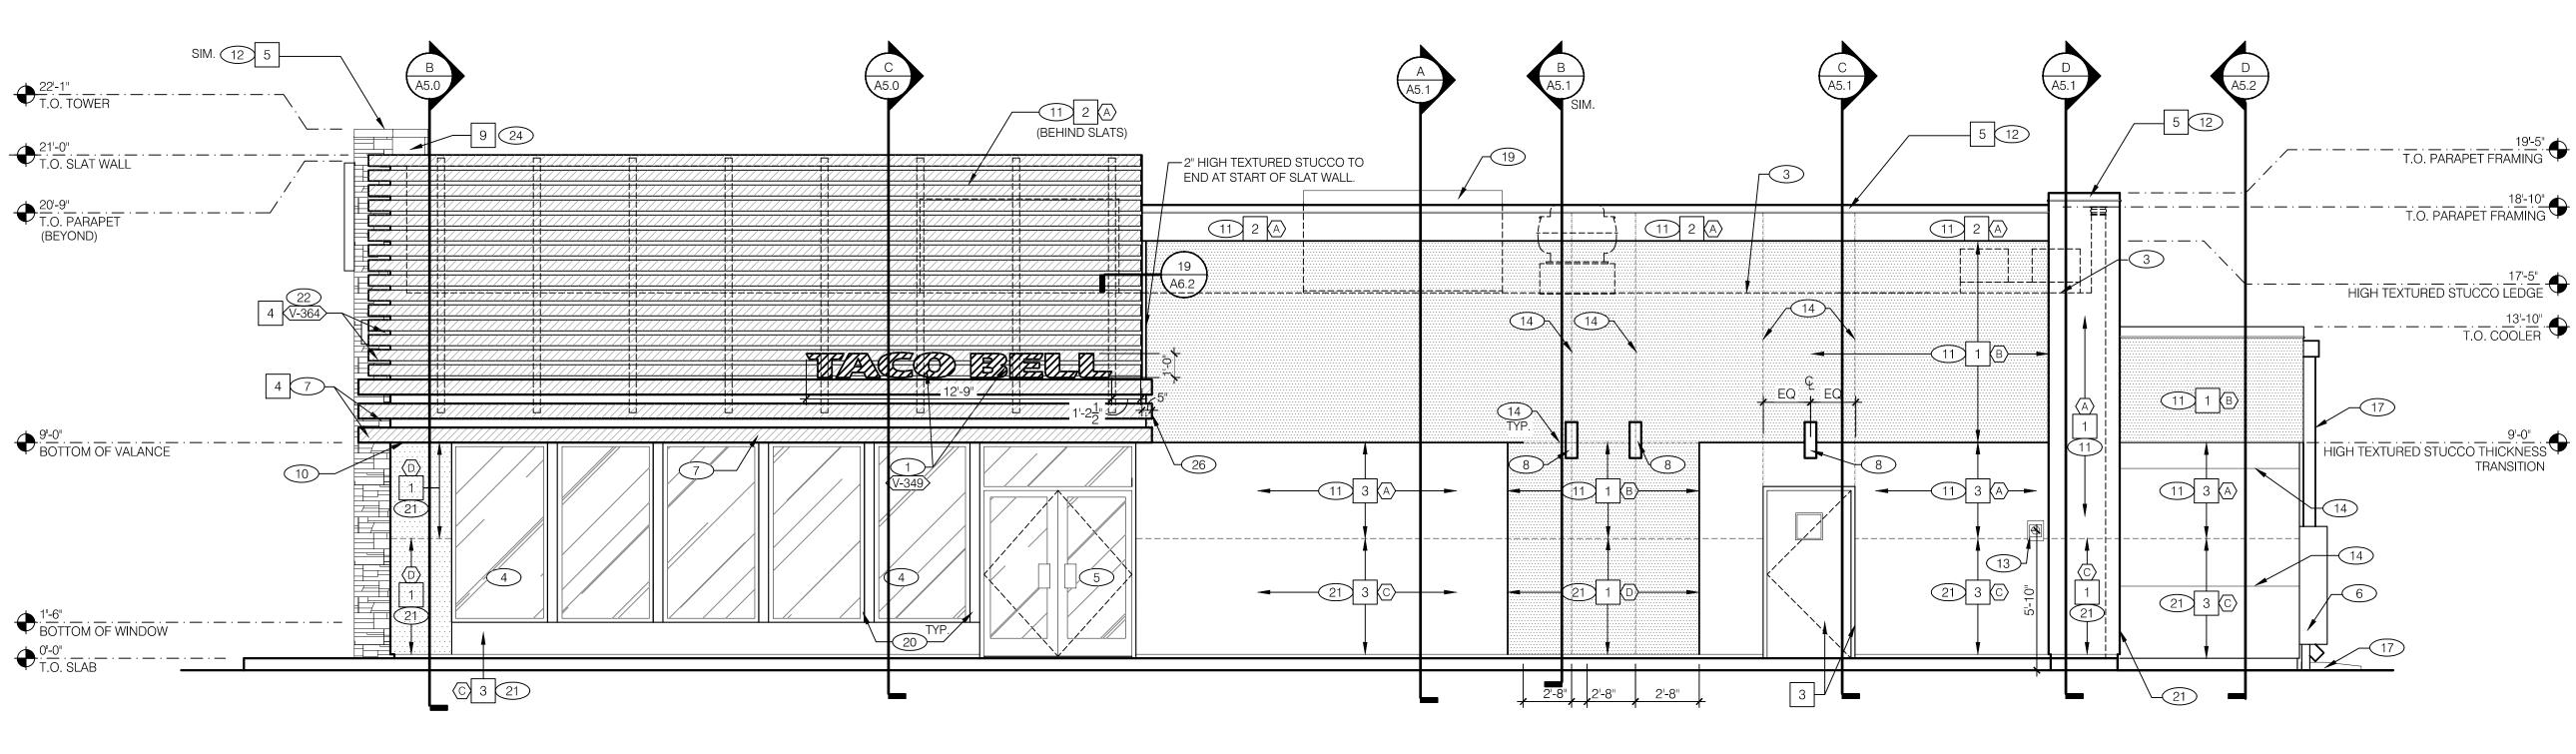

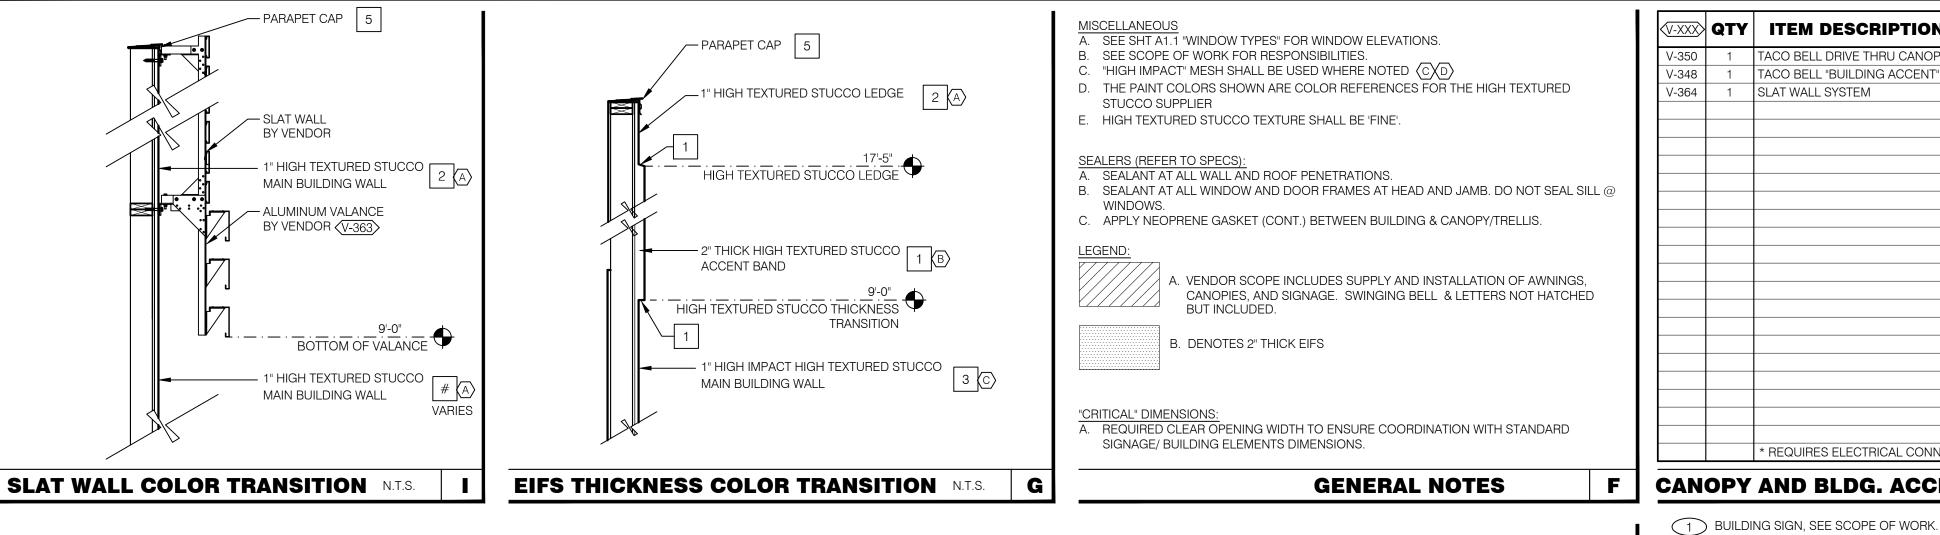

<u>DURO-LAST:</u> LEE COBB, 800-434-3876 (PHONE)

EXTERIOR FINISH SCHEDULE

ALTERNATE MFR. | ALTERNATE COLOR | CONTACT INFORMATION

(V-XXX)	QTY	ITEM DESCRIPTION	ELEC
V-350	1	TACO BELL DRIVE THRU CANOPY	X
V-348	1	TACO BELL "BUILDING ACCENT" SHADING & LED	Х
V-364	1	SLAT WALL SYSTEM LAMPING.	
		* REQUIRES ELECTRICAL CONNECTION. SEE ELECTRICAL PLANS.	

(A) (B) (C)	BASE THICKNESS - 1" THICK HIGH TEXTURED STUCCO BASE THICKNESS - 2" THICK HIGH TEXTURED STUCCO BASE THICKNESS -1" THICK HIGH TEXTURED STUCCO WITH HIGH IMPACT
D	MESH (ONLY WHERE NOTED). SEE DETAIL 2/A6.2. BASE THICKNESS -2" THICK HIGH TEXTURED STUCCO WITH HIGH IMPACT MESH (ONLY WHERE NOTED). SEE DETAIL 2/A6.2.
	E.I.F.S. THICKNESS N.T.S. B

RIGHT SIDE ELEVATION 1/4"=1'-0"

⟨V-XXX⟩	QTY	ITEM DESCRIPTION	ELEC
1/ 0 / 0		TAGO DELL LETTERO COLLIGIA MUNTE ELAT FACER	
V-349	3	TACO BELL LETTERS 12" HIGH, WHITE, FLAT FACED	X
V-322	1 1	TACO BELL 'BELL' SIGN 4'-10 1/2"W x 4'-6 1/4"H	X
		LED	
	'	LAMPING.	

(16) WALL SHALL BE FINISHED PRIOR TO INSTALLATION OF SWITCHGEAR.

21 HIGH IMPACT HIGH TEXTURED STUCCO WHERE SHOWN ON ELEVATIONS.

25 IF THE DURO LAST PARAPET CAP TRIM IS USED IT SHALL NOT BE PAINTED.

20 BREAK METAL COVER OVER WOOD STUDS TO MATCH STOREFRONT. SEE 3,4 & 7/A6.1

KEY NOTES

SCUPPER, COLLECTOR, AND VERTICAL DOWNSPOUT 6" MIN.

19 RTU BEYOND. PAINT TO MATCH MAIN BUILDING COLOR.

DUROLAST SINGLE MEMBRANE ROOFING OR EQUAL.

26 RETURN ALUMINUM LOUVERS BACK TO FACE OF BUILDING.

PAINT TO MATCH ADJACENT WALL.

TOP EXTENT AT 5'-0". SEE 2/A6.2.

22 ALUMINUM SLAT WALL BY VENDOR.

15 GAS SERVICE.

23 BOLLARD

18 OVERFLOW SCUPPER.

SIGN SCHEDULE N.T.	S.	C	T4001	DEL 1
0.01.001.001.0		_	STORE NUMBER:	427918
		-	SITE NUMBER:	310501
ING.		+ 1	PLAN VERSION:	JUNE 2014
GN 4'-10 1/2"W x 4'-6 1/4"H		X	BUILDING TYPE: LIVE	MAS MEDIUM54
12" HIGH, WHITE, FLAT FACED		X	CONTRACT DATE:	10.03.2014
RIPTION	ELE		$\overline{\triangle}$	
			$\frac{\triangle}{\wedge}$	
			\triangle	
I.F.S. THICKNESS N.T.S	S	В	\triangle	
			\triangle	
GREEN			$\frac{\triangle}{\triangle}$	
TH TEXTURED STUCCO WITH HIGH IMPACT N TAIL 2/A6.2.	ИESH		NO CHA	NGES 12.19.2014
SEE DETAIL 2/A0.2.			<u>/1\</u>	11.19.2014

TACO BELL

2234-2248 CROOKS RD. ROCHESTER HILLS, MI 48309



EXTERIOR ELEVATIONS

D

1	MAIN BUILDING COLOR	SHERWIN WILLIAMS	SW 6122 "CAMEL BACK"	LOTUSAN	NA08-0011	SHERWIN WILLIAMS: BRAD HARRINGTON, 216-341-5558 X115 (PHONE), BRAD.E.HARRINGTON@SHERWIN.COM
2	WALL COLOR BEHIND SCREEN WALL	SHERWIN WILLIAMS	SW 6831 "CLEMATIS"			HIGH TEXTURED STUCCO CONTACT:
3	ACCENT COLOR	SHERWIN WILLIAMS	SW 2823 "ROOKWOOD CLAY"	LOTUSAN	NA08-0010	STO CORP.: TIM SALERNO, 800-628-2738 X6502 (PHONE), 321-978-0267 (FAX), TSALERNO@STOCORP.COM OWNER REPRESENTATIVE WILL IDENTIFY IF LOTUSAN PAINT WILL BE USED.
4	SLAT WALL AND VALANCE COLOR	VENDOR	SW 7034 "STATUS BRONZE" (EQUAL)			
5	PARAPET CAP COLOR	27 DUROLAST	MEDIUM BRONZE (FACTORY FINISH)	SHERWIN WILLIAMS	SW 7069 "IRON ORE"	DURO-LAST: LEE COBB, 800-434-3876 (PHONE)
6	STONE WALL	BORAL - VERSETTA STONE	TIGHT CUT - " PLUM CREEK"	OWENS CORNING	IDAHO DRY STACK, CARMEL MOUNTAIN CULTURED STONE VENEER	VERSETTA STONE WALL: GENE GUETZOW, 262-215-8373 (PHONE) ALTERNATE: OWENS CORNING: KATHY MANNON, 866-315-5081 (PHONE), KATHY.MANNON@OWENSCORNING.COM
7	STOREFRONT WINDOWS	TBD	" DARK BRONZE"			
8	PIPE BOLLARDS	STREET SMART	YELLOW - 1/4" THCIK PLASTIC COVER ((US.POSTMAN.COM) OR E	EQUAL	

THE COLOR SHALL BE FACTORY COLORED "TAN." EQUAL ALTERNATE ALLOWED.

MANUFACTURER

DUROLAST

COLOR

SYMBOL

9 PARAPET BACK ROOFING

AREA

12 PARAPET COPING. IF DURO-LAST EDGE TRIM IS USED. USE THE DURO-LAST

PRE-FINISHED EDGE TRIM. SEE DETAIL 2/A6.0.

AWAY FROM BUILDING 1:12.

7 ARCHITECTURAL ALUMINUM VALANCE BY VENDOR.

8 LIGHT SCONCE. ALIGN BOTTOM OF FIXTURE'S MOUNTING BRACKET WITH

(10) 2" HIGH TEXTURED STUCCO TO TERMINATE AT TOP OF WINDOW HEIGHT.

CHANGE IN HIGH TEXTURED STUCCO THICKNESS (CENTER OF BRACKET

PROVIDE 1" HIGH TEXTURED STUCCO ABOVE THAT POINT. SLOPE TRANSITION

2 DRIVE THRU WINDOW. SEE SHEET A1.0 AND A1.1.

6 SWITCH GEAR. PAINT TO MATCH WALL.

REFER TO GRADING & SITE PLAN.

3 ROOF BEYOND.

5 DOUBLE DOOR.

4 STOREFRONT TYPICAL.

11) HIGH TEXTURED STUCCO (TYP). SEE 2 & 4/A6.2.

9 ASSUME D/T LANE SURFACE IS 6" BELOW THE FINISH FLOOR.


(13) CO2 FILLER VALVE & COVER. SEE DETAIL 5/A6.2 SIM.


14 HIGH TEXTURED STUCCO REVEAL JOINT.


NOTE: ALL SIGNS MUST MEET CHAPTER 134 OF THE CITY CODE OF ORDINANCES AND BE APPROVED UNDER A SEPARATE PERMIT ISSUED BY THE BUILDING DEPARTMENT.


RIGHT SIDE ELEVATION 1/4"=1'-0"

REAR ELEVATION 1/4" = 1'-0" B

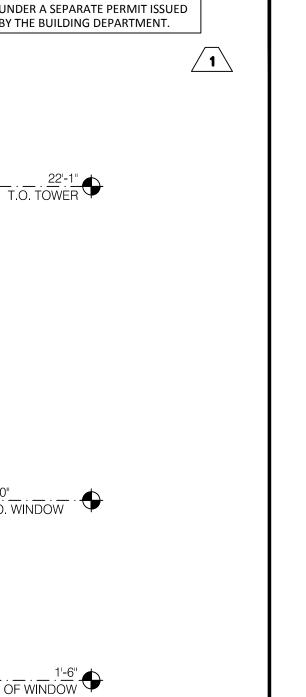

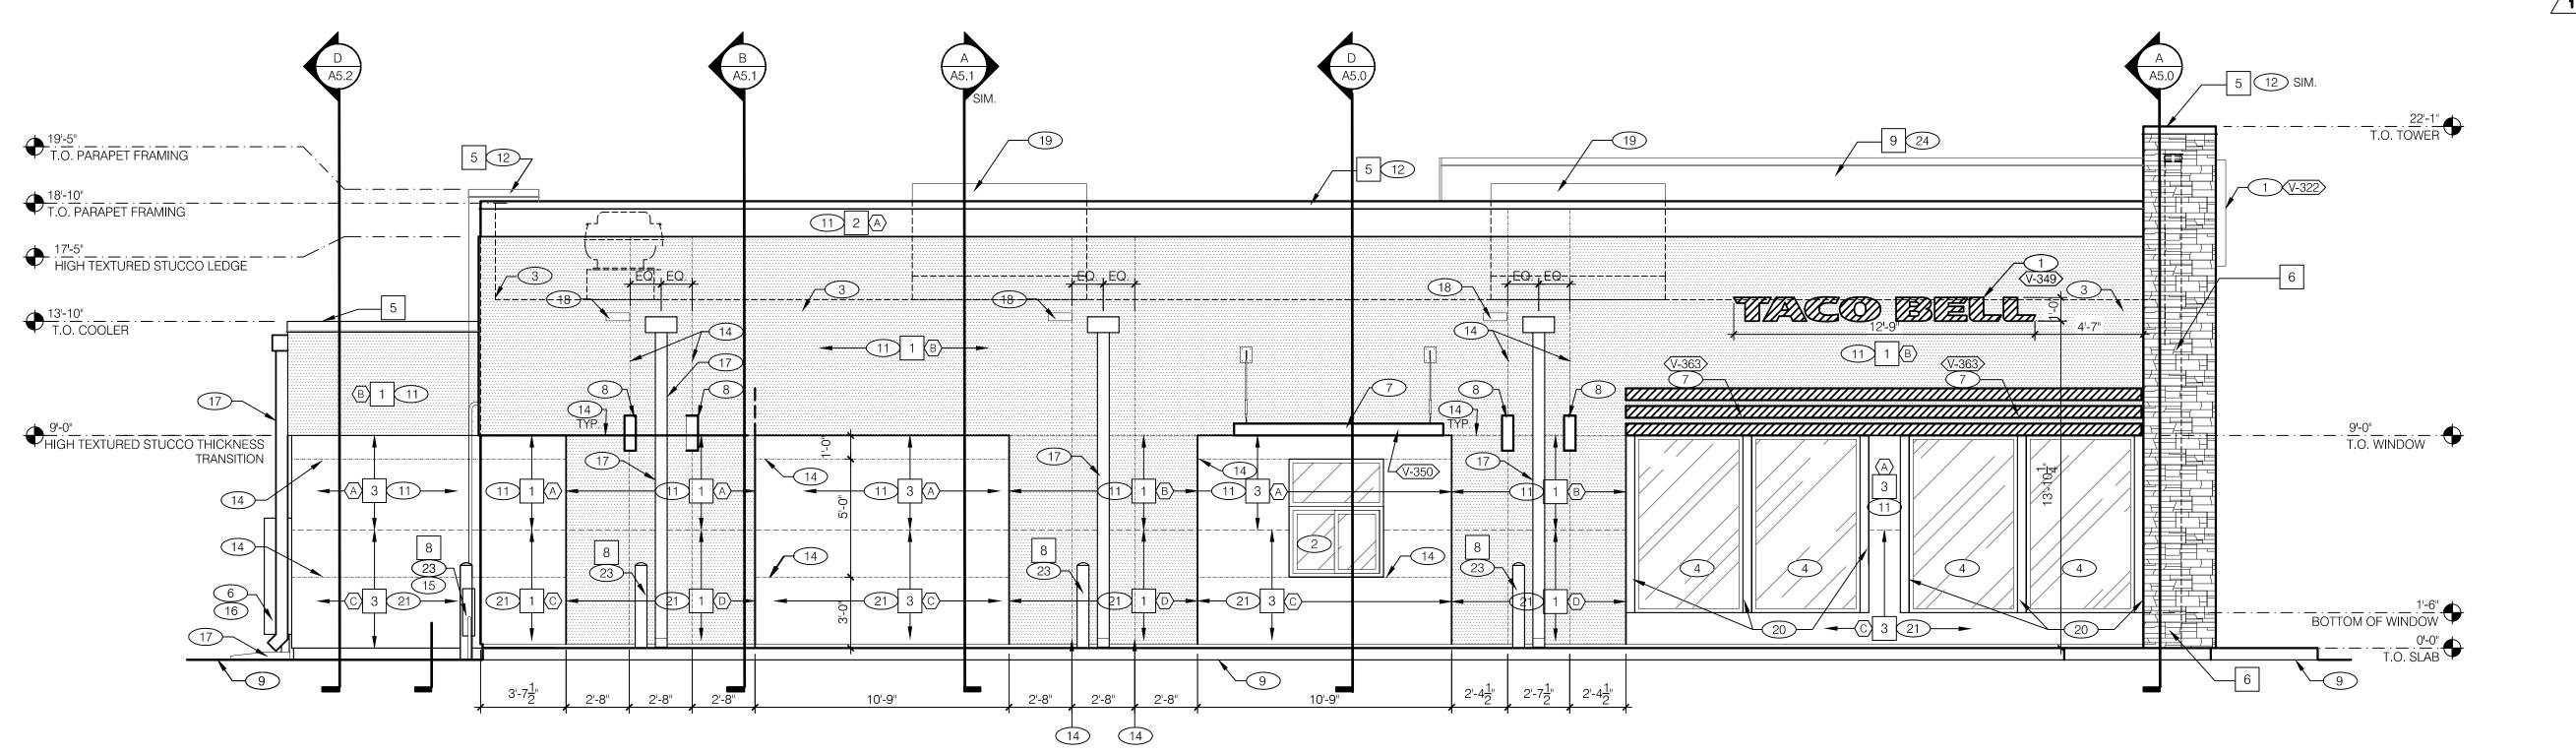

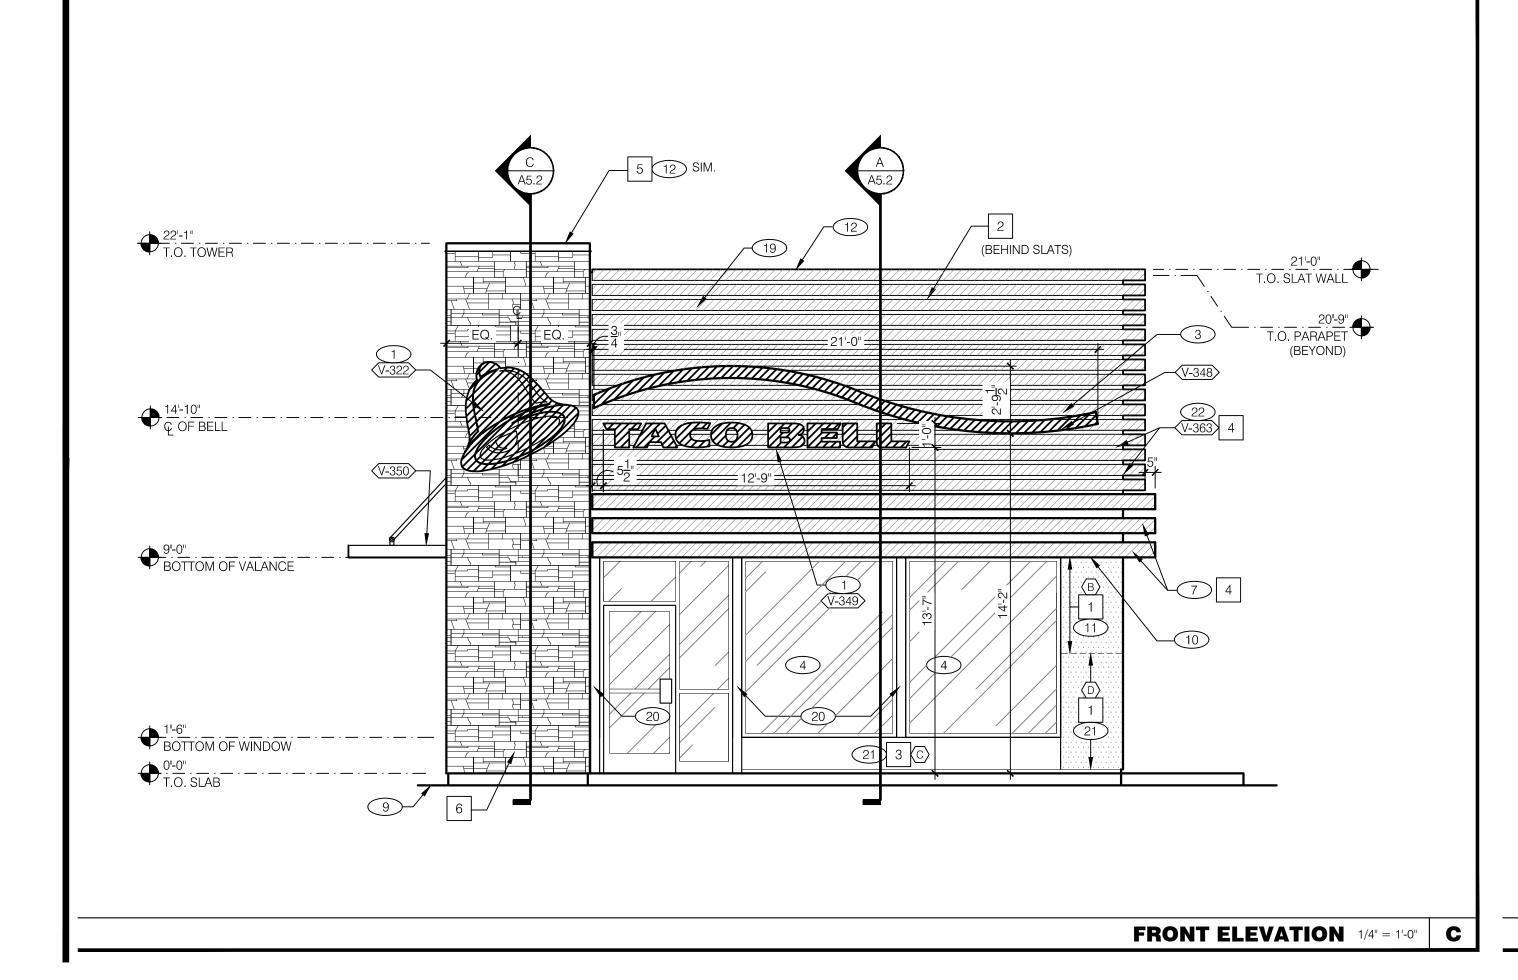

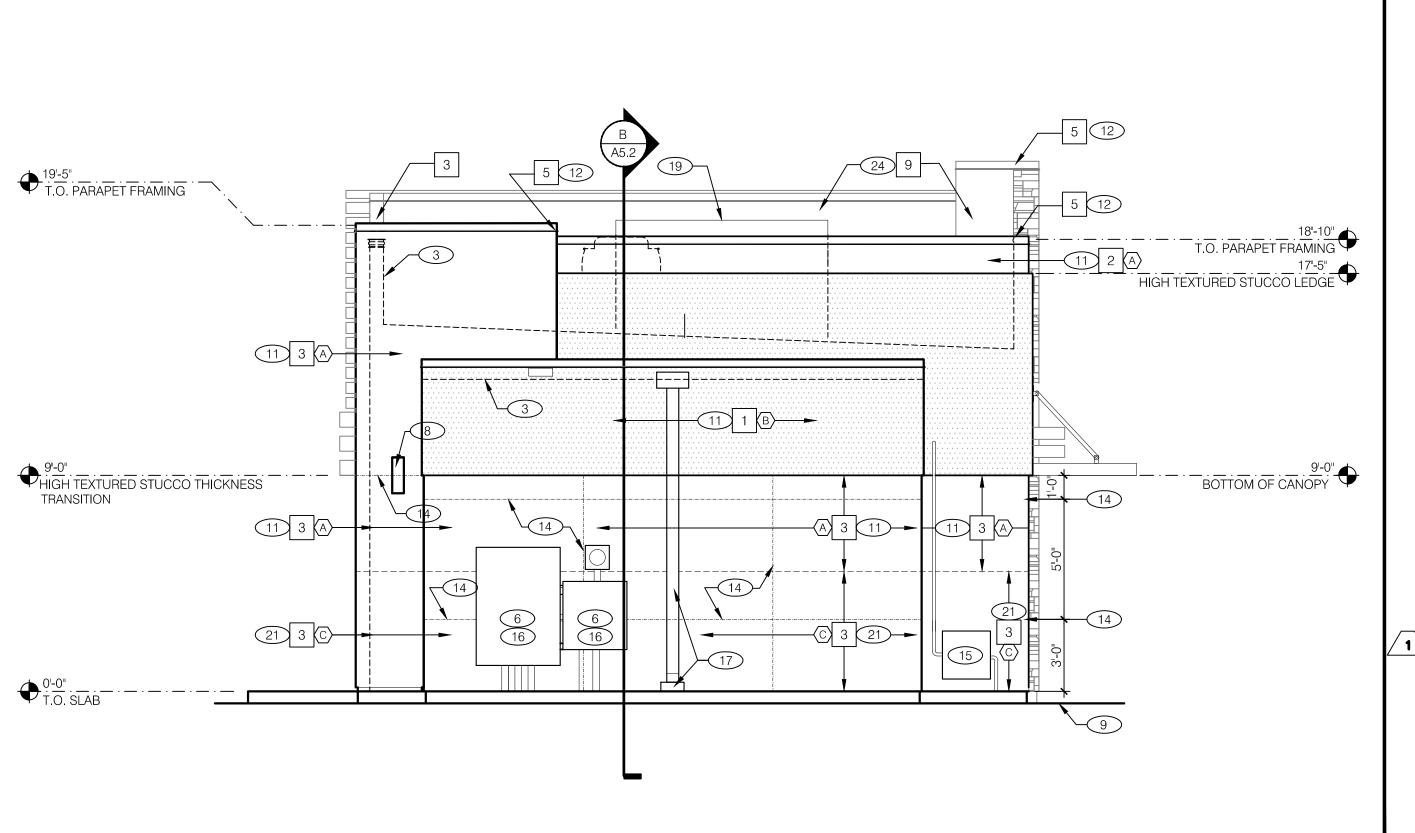

11.19.2014 NO CHANGES 12.19.2014

19100 VON KARMAN AVE.

SUITE 600

IRVINE, CA 92612

WDPARTNERS.COM

949.753.7676 T


TACO BELL

STORE NUMBER:

2234-2248 CROOKS RD. ROCHESTER HILLS, MI 48309



CITY FILE #14-015 **EXTERIOR ELEVATIONS**

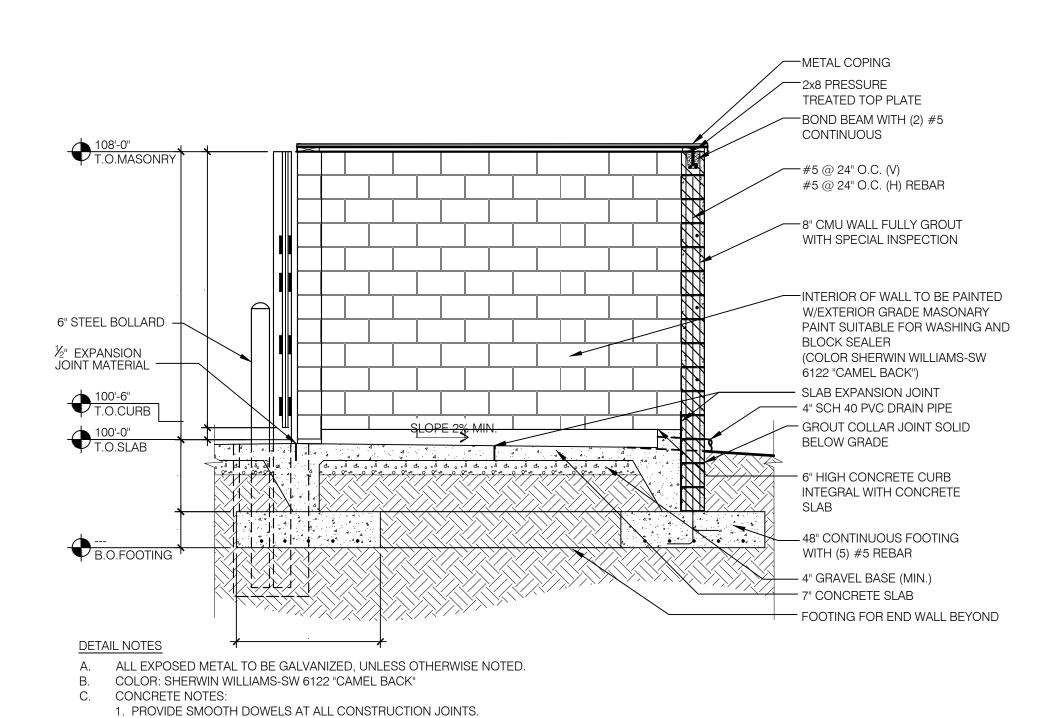


2. POURED CONCRETE WITH AIR ENTRAINMENT OF 5%, 28 DAY

COMPRESSIVE STRENGTH OF 3,000 PSI.

SECTION 3/8"=1'-0" 14

CMU PAINTED — HASP, PROVIDED BY GATE COPE ANGLE BRACING, GRIND WELDS SMOOTH. PROVIDE ALL REQ'D HARDWARE. PAINT ALL EXPOSED AND 2-FINISH COATS, COLOR TO MATCH EXTERIOR FINISH OF TRASH ENCLOSURE. STEEL BOLLARD, L △ _ _ _ _ PAINT SAFETY YELLOW, TYP. ——— ++++ * * * *

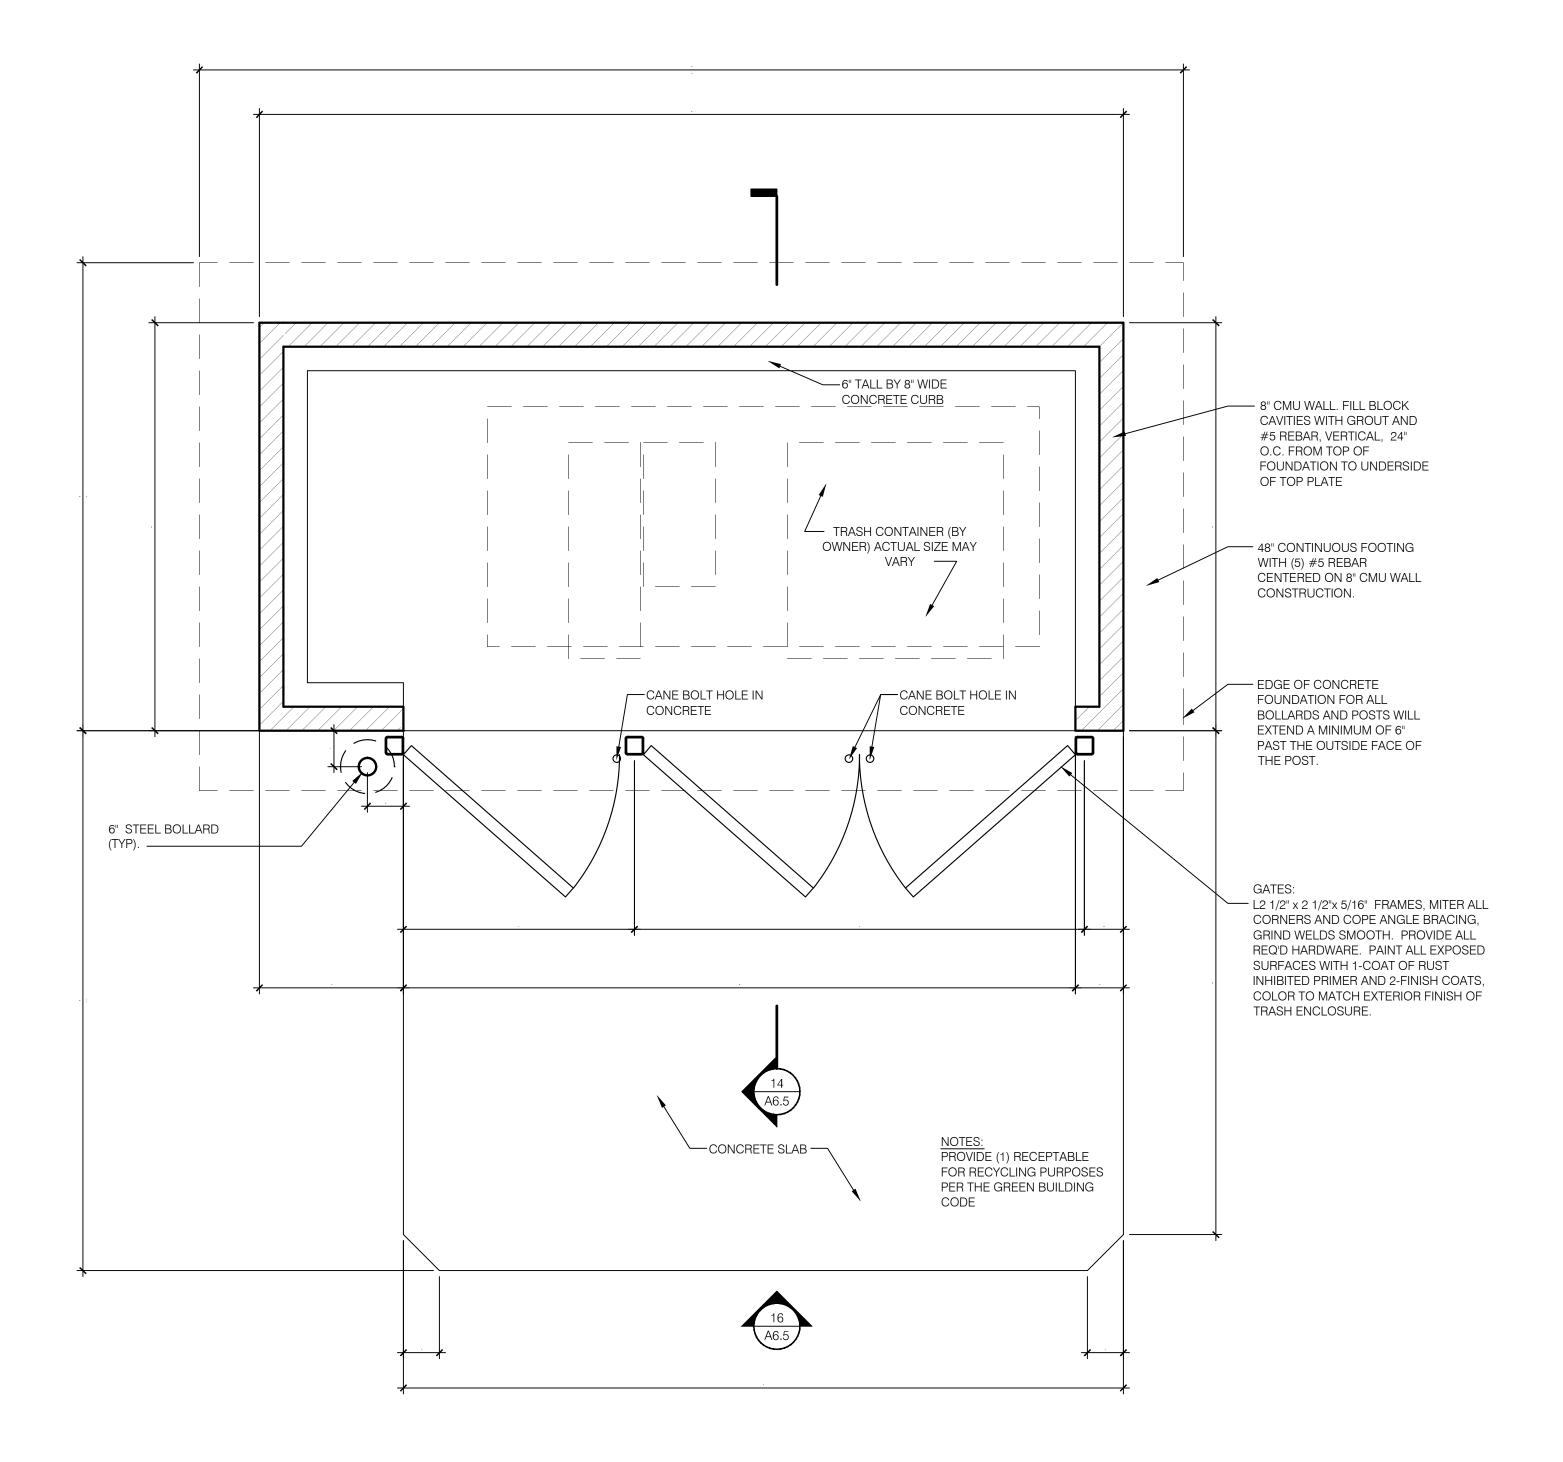



19100 VON KARMAN AVE. SUITE 600 IRVINE, CA 92612 949.753.7676 T

WDPARTNERS.COM

11.19.2014 NO CHANGES 12.19.2014 CONTRACT DATE: BUILDING TYPE:LIVE MAS MEDIUM54

TACO BELL

JUNE 2014

427918

PLAN VERSION:

SITE NUMBER:

STORE NUMBER:

2234-2248 CROOKS RD. ROCHESTER HILLS, MI 48309



CITY FILE #14-015

SITE **DETAILS**

ELEVATION 3/8"=1'-0" 16

TRASH ENCLOSURE PLAN 3/8"=1'-0" 3