

CAMDEN CROSSING


9.36 ACRE DEVELOPMENT
CITY OF ROCHESTER HILLS, OAKLAND COUNTY, MICHIGAN

PRELIMINARY SITE PLAN

Site Plan Review		
Reviewed for compliance to the City Ordinance, Building and Fire Codes		
Department	Reviewer	Approved
Planning	Kristen Kapelanski 248-841-2772 KapelanskiK@RochesterHills.org	Yes
Building	Mark Artinian 248-841-2446 ArtinianM@RochesterHills.org	Yes
Engineering	Jason Boughton 248-841-2490 BoughtonJ@RochesterHills.org	Yes
Traffic	Lt. Ann Echols 248-841-2701 EcholsA@RochesterHills.org	Yes
Nat. Resources	Matt Einheuser 248-841-2551 EinheuserM@RochesterHills.org	Yes
Fire	Lt. Ann Echols 248-841-2701 EcholsA@RochesterHills.org	Yes

City of Rochester Hills
Planning & Economic Development

Conditions and mark-ups noted throughout the plan set must be addressed prior to final approval.

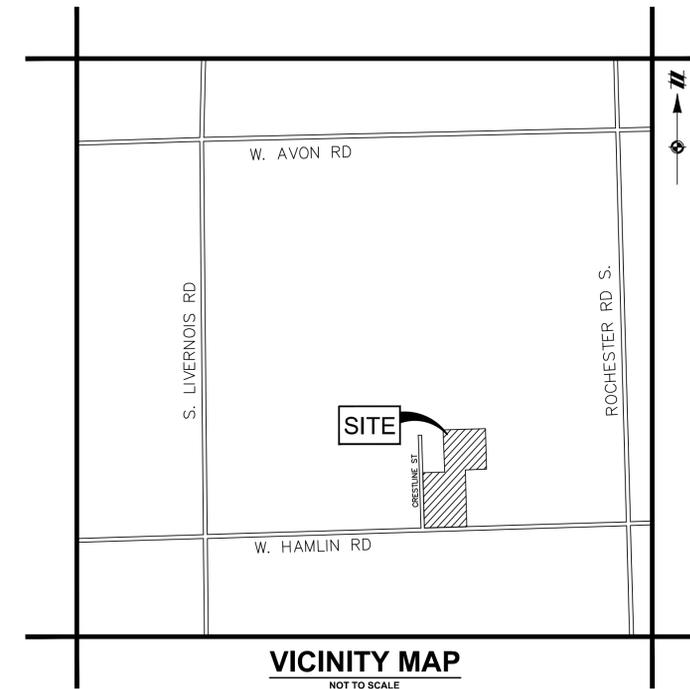

DEVELOPMENT TEAM

DEVELOPER

M2J1, LLC
14955 TECHNOLOGY DRIVE
SHELBY TOWNSHIP, MI 48315
PHONE: (586) 421-5729
CONTACT: JIM POLYZOIS

LANDSCAPE ARCHITECT

NUNEZ DESIGN, INC.
249 PARK STREET
TROY, MI 48063
PHONE: (248) 224-5933
CONTACT: RALPH NUNEZ

CIVIL ENGINEER

ATWELL, LLC
TWO TOWNE SQUARE, SUITE 700
SOUTHFIELD, MI 48076
PHONE: (248) 447-2000
CONTACT: ERIC LORD, P.E.

SURVEYOR

REICHERT
140 FLUMERFELT LANE
ROCHESTER, MI 48306
PHONE: (248) 651-0592
CONTACT: GEORGE REICHERT

Minimum site area using the MR Overlay is 10 acres. The Planning Commission may modify this requirement if another standard is more reasonable due to existing site or neighborhood conditions or because the site cannot physically comply with one or more of the requirements. In determining whether the modification is warranted, the Planning Commission shall consider the findings for approving a conditional use listed in Section 138-2.302 of the Zoning Ordinance.

Per a phone conversation with John Ackerman of Atwell, LLC on 6/29/2020, the Design Professional intends to use the 2015 Michigan Residential Code for all new structures.

Colored renderings must be provided prior to the Planning Commission meeting.

LEGAL DESCRIPTION

15-22-451-029 LOT 15 EXCEPT THE NORTH 420.00 FT. OF "HAMLIN PLACE FARMS" A SUBDIVISION OF PART OF THE S.E. 1/4 OF SEC. 22 AND PART OF THE S.W. 1/4 OF SEC. 23, T.3N., R.11E., CITY OF ROCHESTER HILLS, OAKLAND COUNTY, MICHIGAN AS RECORDED IN L.15 OF PLATS, P.34, OAKLAND COUNTY RECORDS.

15-22-451-002 LOT 14 OF "HAMLIN PLACE FARMS" A SUBDIVISION OF PART OF THE S.E. 1/4 OF SEC. 22 AND PART OF THE S.W. 1/4 OF SEC. 23, T.3N., R.11E., CITY OF ROCHESTER HILLS, OAKLAND COUNTY, MICHIGAN AS RECORDED IN L.15 OF PLATS, P.34, OAKLAND COUNTY RECORDS.

PART OF 15-22-451-022 THE NORTH 404.00 FT. OF LOT 13 OF "HAMLIN PLACE FARMS" A SUBDIVISION OF PART OF THE S.E. 1/4 OF SEC. 22 AND PART OF THE S.W. 1/4 OF SEC. 23, T.3N., R.11E., CITY OF ROCHESTER HILLS, OAKLAND COUNTY, MICHIGAN AS RECORDED IN L.15 OF PLATS, P.34, OAKLAND COUNTY RECORDS.

SITE DATA

THE CURRENT ZONING CLASSIFICATION IS R-3 WITH MIXED RESIDENTIAL OVERLAY
GROSS AREA: 9.36 AC. NET AREA: 9.36 AC.

UNIT DENSITY
AREA=9.36 AC
UNITS=26 SINGLE FAMILY DETACHED CONDOMINIUMS
COVERAGE=26/9.36=2.69 UNITS PER ACRE

SETBACKS
PERIMETER
FRONT (STREET): 30'
FRONT (OTHER): 35'
SIDE: 15'
REAR: 60'
INTERIOR
FRONT: 20'
SIDE: 5'/15' TOTAL
REAR: 35'


SIDEWALK PROVIDED
ROADS ARE TO BE PRIVATE

SHEET INDEX

C-01	COVER SHEET
C-02	SITE LAYOUT PLAN
C-03	GRADING PLAN
C-04	UTILITY PLAN
C-05	OVERALL DRAINAGE AREA PLAN
C-06	FIRE PROTECTION PLAN
C-07	DETAIL SHEET
C-08	DETAIL SHEET
C-09	ARCHITECTURAL DRAWINGS
C-10	ARCHITECTURAL DRAWINGS
C-11	ARCHITECTURAL DRAWINGS

ADDITIONAL SHEETS:

- G -1.0 COVER
- T - 1.0 TREE PROTECTION PLAN
- LA - 1.0 LANDSCAPE CONCEPT & REQUIREMENTS
- LA - 1.1 LANDSCAPE PLANTING PLAN
- LA - 1.2 PATHWAY SIGHTLINE, CLEAR ZONE & PLANTING SETBACKS
- LA - 1.3 CAMDEN CROSSING PARKETTE
- LA - 1.4 AMENITIES
- LA - 1.5 SEEDING PLAN
- LA - 2.0 LANDSCAPE PLANTING DETAILS & NOTES
- LA - 2.1 ADDITIONAL SPECS
- IR - 1.0 IRRIGATION PLAN
- TOPOGRAPHICAL SURVEY

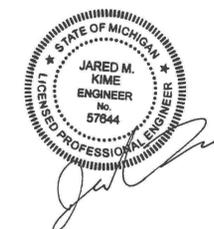

CITY FILE #19-031
SECTION #22

NOT FOR CONSTRUCTION



Know what's below.

Call before you dig.

THE LOCATIONS OF EXISTING UNDERGROUND UTILITIES ARE SHOWN IN AN APPROXIMATE WAY ONLY AND HAVE NOT BEEN INDEPENDENTLY VERIFIED BY THE OWNER OR ITS REPRESENTATIVE. THE CONTRACTOR SHALL DETERMINE THE EXACT LOCATION OF ALL EXISTING UTILITIES BEFORE COMMENCING WORK, AND AGREES TO BE FULLY RESPONSIBLE FOR ANY AND ALL DAMAGES WHICH MIGHT BE OCCASIONED BY THE CONTRACTOR'S FAILURE TO EXACTLY LOCATE AND PRESERVE ANY AND ALL UNDERGROUND UTILITIES.

NOTICE: CONSTRUCTION SITE SAFETY IS THE SOLE RESPONSIBILITY OF THE CONTRACTOR. NEITHER THE OWNER NOR THE ENGINEER SHALL BE EXPECTED TO ASSUME ANY RESPONSIBILITY FOR SAFETY OF THE WORK, OF PERSONS ENGAGED IN THE WORK, OF ANY NEARBY STRUCTURES, OR OF ANY OTHER PERSONS.

COPYRIGHT © 2021 ATWELL, LLC. NO REPRODUCTION SHALL BE MADE WITHOUT THE PRIOR WRITTEN CONSENT OF ATWELL, LLC.



SECTION 22
TOWN 3 NORTH, RANGE 11 EAST
CITY OF ROCHESTER HILLS
OAKLAND COUNTY, MICHIGAN

M2J1, LLC
CAMDEN CROSSING
PRELIMINARY SITE PLAN
COVER SHEET

DATE
AUG. 16, 2019

2020-06-15 PER CITY
2021-01-21 PER CITY
2021-07-02 PER CITY
2021-08-23 PER CITY

REVISIONS

NA NA NA
N/A

DRAWN BY: KS

CHECKED BY: JA

P.M.: J. ACKERMAN

JOB #: 18001982

FILE CODE: -

SHEET NO. C-01

The applicant should not remove any trees until the Land Improvement Permit process has been initiated

The applicant needs to submit a Land Improvement Permit (LIP) application with engineer's estimate, fee and construction plans to proceed with the construction plan review process.



LEGEND

	PROPERTY LINE
	PR. SPLIT RAIL FENCE
	PR. BUILDING SETBACK
	PR. CURB AND GUTTER
	PR. ASPHALT
	PROPOSED CONCRETE
	PR. ACCESS PATH
	EX. WETLAND

UNIT LEGEND

- TYPE A: 43'x57' - UNITS 1-9
- TYPE B: 39'x60' - UNITS 10-26



Know what's below.
Call before you dig.

THE LOCATIONS OF EXISTING UNDERGROUND UTILITIES ARE SHOWN IN AN APPROXIMATE WAY ONLY AND HAVE NOT BEEN INDEPENDENTLY VERIFIED BY THE OWNER OR ITS REPRESENTATIVE. THE CONTRACTOR SHALL DETERMINE THE EXACT LOCATION OF ALL EXISTING UTILITIES BEFORE COMMENCING WORK, AND AGREES TO BE FULLY RESPONSIBLE FOR ANY AND ALL DAMAGES WHICH MIGHT BE OCCASIONED BY THE CONTRACTOR'S FAILURE TO EXACTLY LOCATE AND PRESERVE ANY AND ALL UNDERGROUND UTILITIES.

NOTICE: CONSTRUCTION SITE SAFETY IS THE SOLE RESPONSIBILITY OF THE CONTRACTOR. NEITHER THE OWNER NOR THE ENGINEER SHALL BE EXPECTED TO ASSUME ANY RESPONSIBILITY FOR SAFETY OF THE WORK OF PERSONS ENGAGED IN THE WORK, OR ANY NEARBY STRUCTURES, OR OF ANY OTHER PERSONS.

COPYRIGHT © 2021 ATWELL, LLC. NO REPRODUCTION SHALL BE MADE WITHOUT THE PRIOR WRITTEN CONSENT OF ATWELL, LLC.


ATWELL
866.850.4200 www.atwell-group.com
TOWNE SQUARE, SUITE 700
TWO SOUTHFIELD, MI 48076
248.447.2000

NOTES

- THE DEVELOPER IS PROPOSING A 26 UNIT SITE CONDOMINIUM.
- ALL SIGNAGE WILL BE IN CONFORMANCE WITH THE CITY OF ROCHESTER HILLS REQUIREMENTS. A SEPARATE SIGN PERMIT MUST BE OBTAINED FROM THE BUILDING DEPARTMENT.
- DETECTABLE WARNING SURFACES SHALL BE PROVIDED AT THE SIDEWALK APPROACHES TO THE ROADWAYS.
- BUILDING CONSTRUCTION TYPE WILL BE WOOD FRAME.
- CITY SHALL FURNISH AND PLACE ALL PERMANENT ROW STREET SIGNS WITH MONIES PAID BY DEVELOPER.
- THE PROPOSED PRIVATE ROADS ARE NOT BEING CONSTRUCTED TO THE CITY'S PUBLIC ROAD STANDARDS, AND THEREFORE, CANNOT BE TRANSFERRED AS PUBLIC ROADS IN THE FUTURE.

35 ft. interior rear setback required. The Planning Commission may modify this requirement if another standard is more reasonable due to existing site or neighborhood conditions or because the site cannot physically comply with one or more of the requirements. In determining whether a modification is warranted, the Planning Commission shall consider the findings for approving a conditional use listed in Section 138-2.302 of the Zoning Ordinance.

Provide curb ramps and detectable warnings at each sidewalk interface with the road.

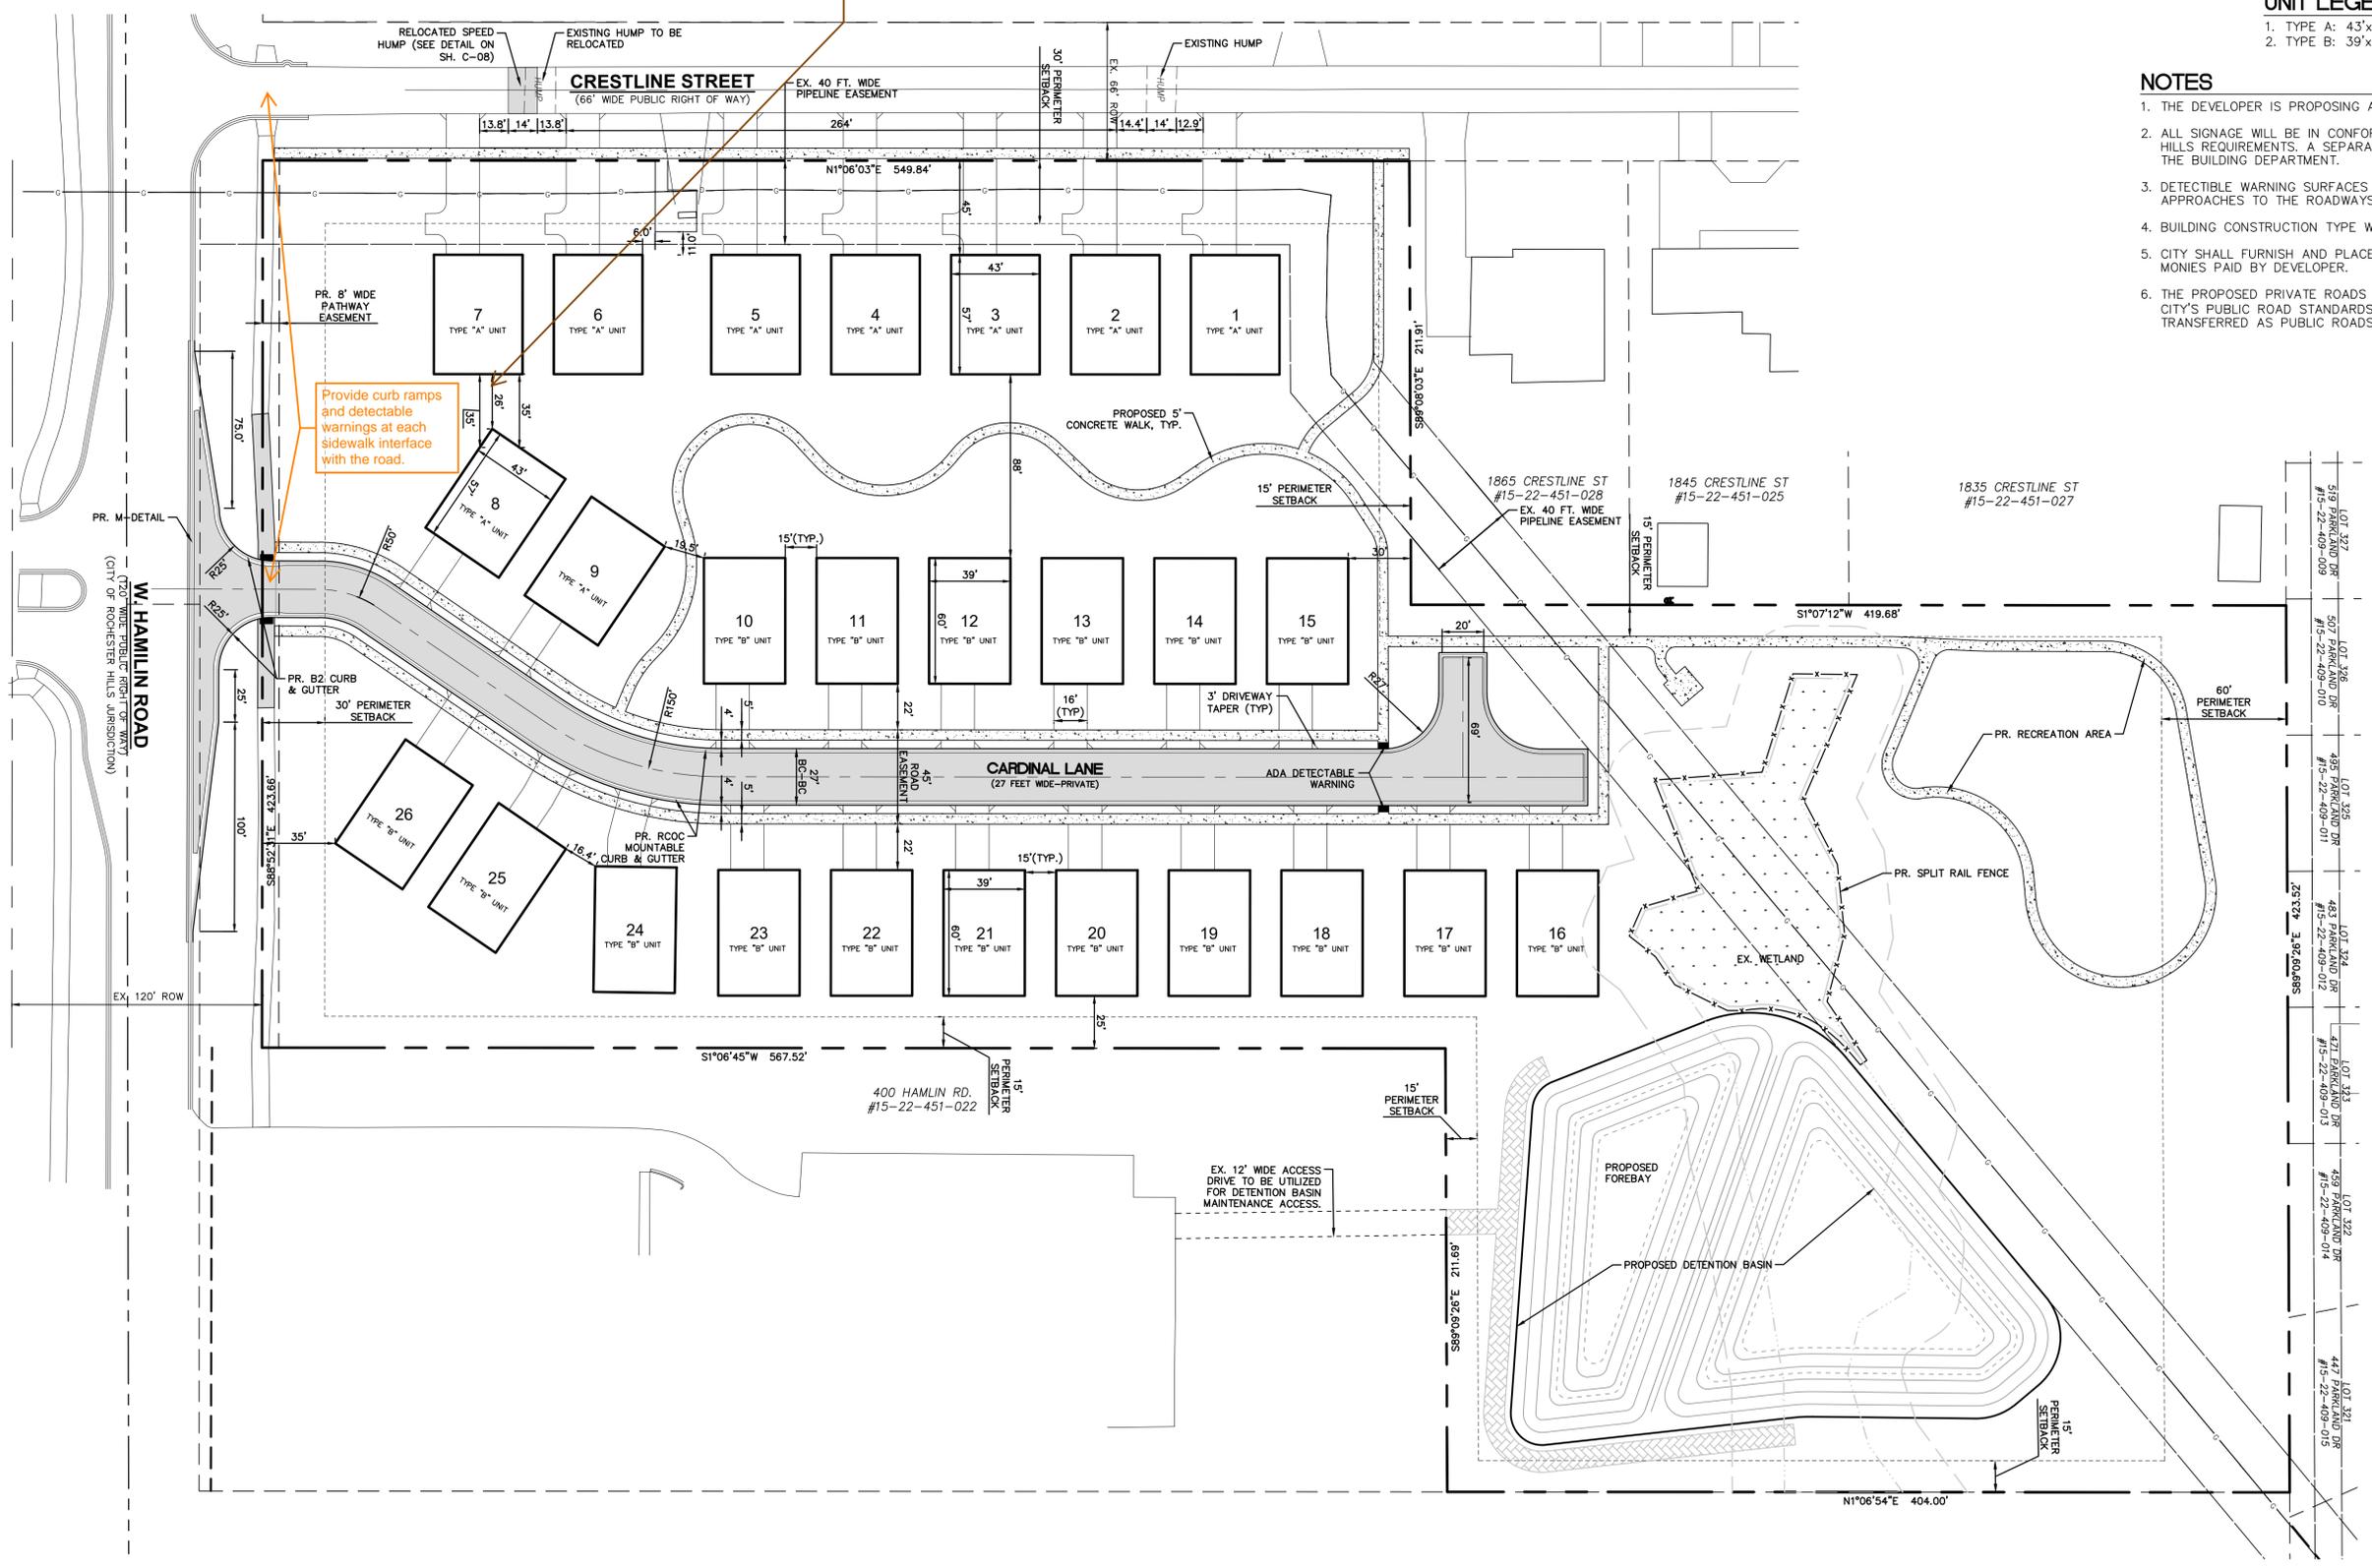

107 322	519 PARKLAND DR #15-22-409-009	107 326	485 PARKLAND DR #15-22-409-011	107 324	483 PARKLAND DR #15-22-409-012	107 328	489 PARKLAND DR #15-22-409-014	107 321	447 PARKLAND DR #15-22-409-015
107 327	507 PARKLAND DR #15-22-409-010	107 325	487 PARKLAND DR #15-22-409-010	107 323	481 PARKLAND DR #15-22-409-013	107 327	487 PARKLAND DR #15-22-409-014	107 320	445 PARKLAND DR #15-22-409-015
26.322 3.96700885		26.322 3.96700885		26.322 3.96700885		26.322 3.96700885		26.322 3.96700885	

SECTION 22
TOWN 3 NORTH, RANGE 11 EAST
CITY OF ROCHESTER HILLS
OAKLAND COUNTY, MICHIGAN

M2JI, LLC
CAMDEN CROSSING
PRELIMINARY SITE PLAN
SITE LAYOUT PLAN

DATE	AUG. 16, 2019
2020-06-15	PER CITY
2021-01-21	PER CITY
2021-07-02	PER CITY
2021-08-23	PER CITY

REVISIONS	
0	
1	
2	
SCALE: 1" = 40 FEET
DRAWN BY: KS
CHECKED BY: JA
P.M.: JACKERMAN
JOB #: 18001982
FILE CODE: -
SHEET NO. C-02

CITY FILE #19-031
SECTION #22

NOT FOR CONSTRUCTION



Know what's below.
Call before you dig.

THE LOCATIONS OF EXISTING UNDERGROUND UTILITIES ARE SHOWN IN AN APPROXIMATE WAY ONLY AND HAVE NOT BEEN INDEPENDENTLY VERIFIED BY THE OWNER OR ITS REPRESENTATIVE. THE CONTRACTOR SHALL DETERMINE THE EXACT LOCATION OF ALL EXISTING UTILITIES BEFORE COMMENCING WORK AND AGREE TO BE FULLY RESPONSIBLE FOR ANY AND ALL DAMAGES WHICH MIGHT BE OCCASIONED BY THE CONTRACTOR'S FAILURE TO EXACTLY LOCATE AND PRESERVE ANY AND ALL UNDERGROUND UTILITIES.

NOTICE: CONSTRUCTION SITE SAFETY IS THE SOLE RESPONSIBILITY OF THE CONTRACTOR. NEITHER THE OWNER NOR THE ENGINEER SHALL BE EXPECTED TO ASSUME ANY RESPONSIBILITY FOR SAFETY OF THE WORK OF PERSONS ENGAGED IN THE WORK OF ANY NEARBY STRUCTURES OR OF ANY OTHER PERSONS.

COPYRIGHT © 2021 ATWELL, LLC. NO REPRODUCTION SHALL BE MADE WITHOUT THE PRIOR WRITTEN CONSENT OF ATWELL, LLC.

ATWELL
866.850.4200 www.atwell-group.com
TWO TOWNE SQUARE, SUITE 700
SOUTHFIELD, MI 48076
248.447.2000



SECTION 22
TOWN 3 NORTH, RANGE 11 EAST
CITY OF ROCHESTER HILLS
OAKLAND COUNTY, MICHIGAN

M2/J, LLC
CAMDEN CROSSING
PRELIMINARY SITE PLAN
GRADING PLAN

DATE: AUG. 16, 2019
2020-06-15 PER CITY
2021-01-21 PER CITY
2021-07-02 PER CITY
2021-08-23 PER CITY

REVISIONS table with columns for revision number, description, and date.

SCALE: 1" = 40 FEET
DRAWN BY: KS
CHECKED BY: JA
P.M.: JACKERMAN
JOB #: 18001982
FILE CODE: -
SHEET NO. C-03

LEGEND

- 588 PR. 1' CONTOUR
- 590 PR. 5' CONTOUR
- EX. 1' CONTOUR
- EX. 5' CONTOUR
- PROPERTY LINE
- CENTERLINE OF SWALE
- PR. MOUNTABLE CURB AND GUTTER
- EX. MANHOLE / CATCH BASIN
- PR. MANHOLE / CATCH BASIN
- EX. HYDRANT
- PR. HYDRANT
- EX. GATE VALVE & WELL
- PR. GATE VALVE & WELL
- EX. WATER MAIN MANHOLE
- PR. SANITARY SEWER MANHOLE
- EX. SANITARY SEWER MANHOLE
- PR. EMERGENCY OVERFLOW ROUTE
- EX. WETLAND
- PR. WETLAND IMPACT
- PERMANENT NATURAL FEATURES BUFFER IMPACT
- TEMPORARY NATURAL FEATURES BUFFER IMPACT

SPOT GRADE DESIGNATIONS
FG = FINISH GRADE
DBL = DROP BRICK LEEDGE
WO = WALKOUT
VO = VIEWOUT
RIM = RIM GRADE/FLOW LINE
WO = FG - 8'
VO = FG - 4.5'

NOTES


- FOR ALL TEMPORARY GRADING IMPACTS TO THE NATURAL FEATURE BUFFERS, BMPs WILL BE IMPLEMENTED DURING THE CONSTRUCTION PHASE OF THE PROJECT. ANY TEMPORARY IMPACTED AREA IS TO BE RESTORED TO ORIGINAL GRADE WITH ORIGINAL SOILS OR EQUIVALENT SOILS AND SEEDED WITH A CITY-APPROVED SEED MIX.
- DRIVE SLOPES ARE FROM FINISHED GRADE TO BACK OF WALK. AN ADDITIONAL 4" WILL BE ADDED TO THE FINISHED GRADE ELEVATION TO ESTABLISH GARAGE FLOOR ELEVATION AND AN ADDITIONAL 1.5% FOR DRIVE SLOPES. LOTS 1-7 REFLECT FINAL DRIVE SLOPES TO GARAGE FLOOR (TOP OF 4" SLAB).
- WETLANDS WERE DELINEATED BY M.McCONNELL, ATWELL, LLC, ON 11-27-18. THE ALPHA-NUMERIC WETLAND FLAGGING (A-1 - A-25) IS PROVIDED AS APPLIED IN THE FIELD.
- ROOF DOWNSPOTS FOR LOTS 1-7 SHALL HAVE DRAINAGE DIRECTED TOWARDS REAR YARD ON-SITE CATCH BASINS.

WETLAND SUMMARY

NATURAL FEATURES SETBACK table with columns for feature type and area.

WETLAND IMPACTS table with columns for impact type and area.

NOTE: WETLAND IMPACT QUALIFIES FOR AN EXEMPTION TO THE WETLAND USE PERMIT, PROVIDED THAT:
1. PRIOR WRITTEN NOTICE IS GIVEN TO THE CITY ENGINEER AND WRITTEN CONSENT IS OBTAINED FROM THE CITY MAYOR PRIOR TO WORK COMMENCING.
2. THE WORK IS CONDUCTED USING BEST MANAGEMENT PRACTICES (BMPs) TO ENSURE FLOW AND CIRCULATION PATTERNS AND CHEMICAL AND BIOLOGICAL CHARACTERISTICS OF WETLANDS ARE NOT IMPACTED.
3. SUCH THAT ALL IMPACTS TO THE AQUATIC ENVIRONMENT ARE MINIMIZED.

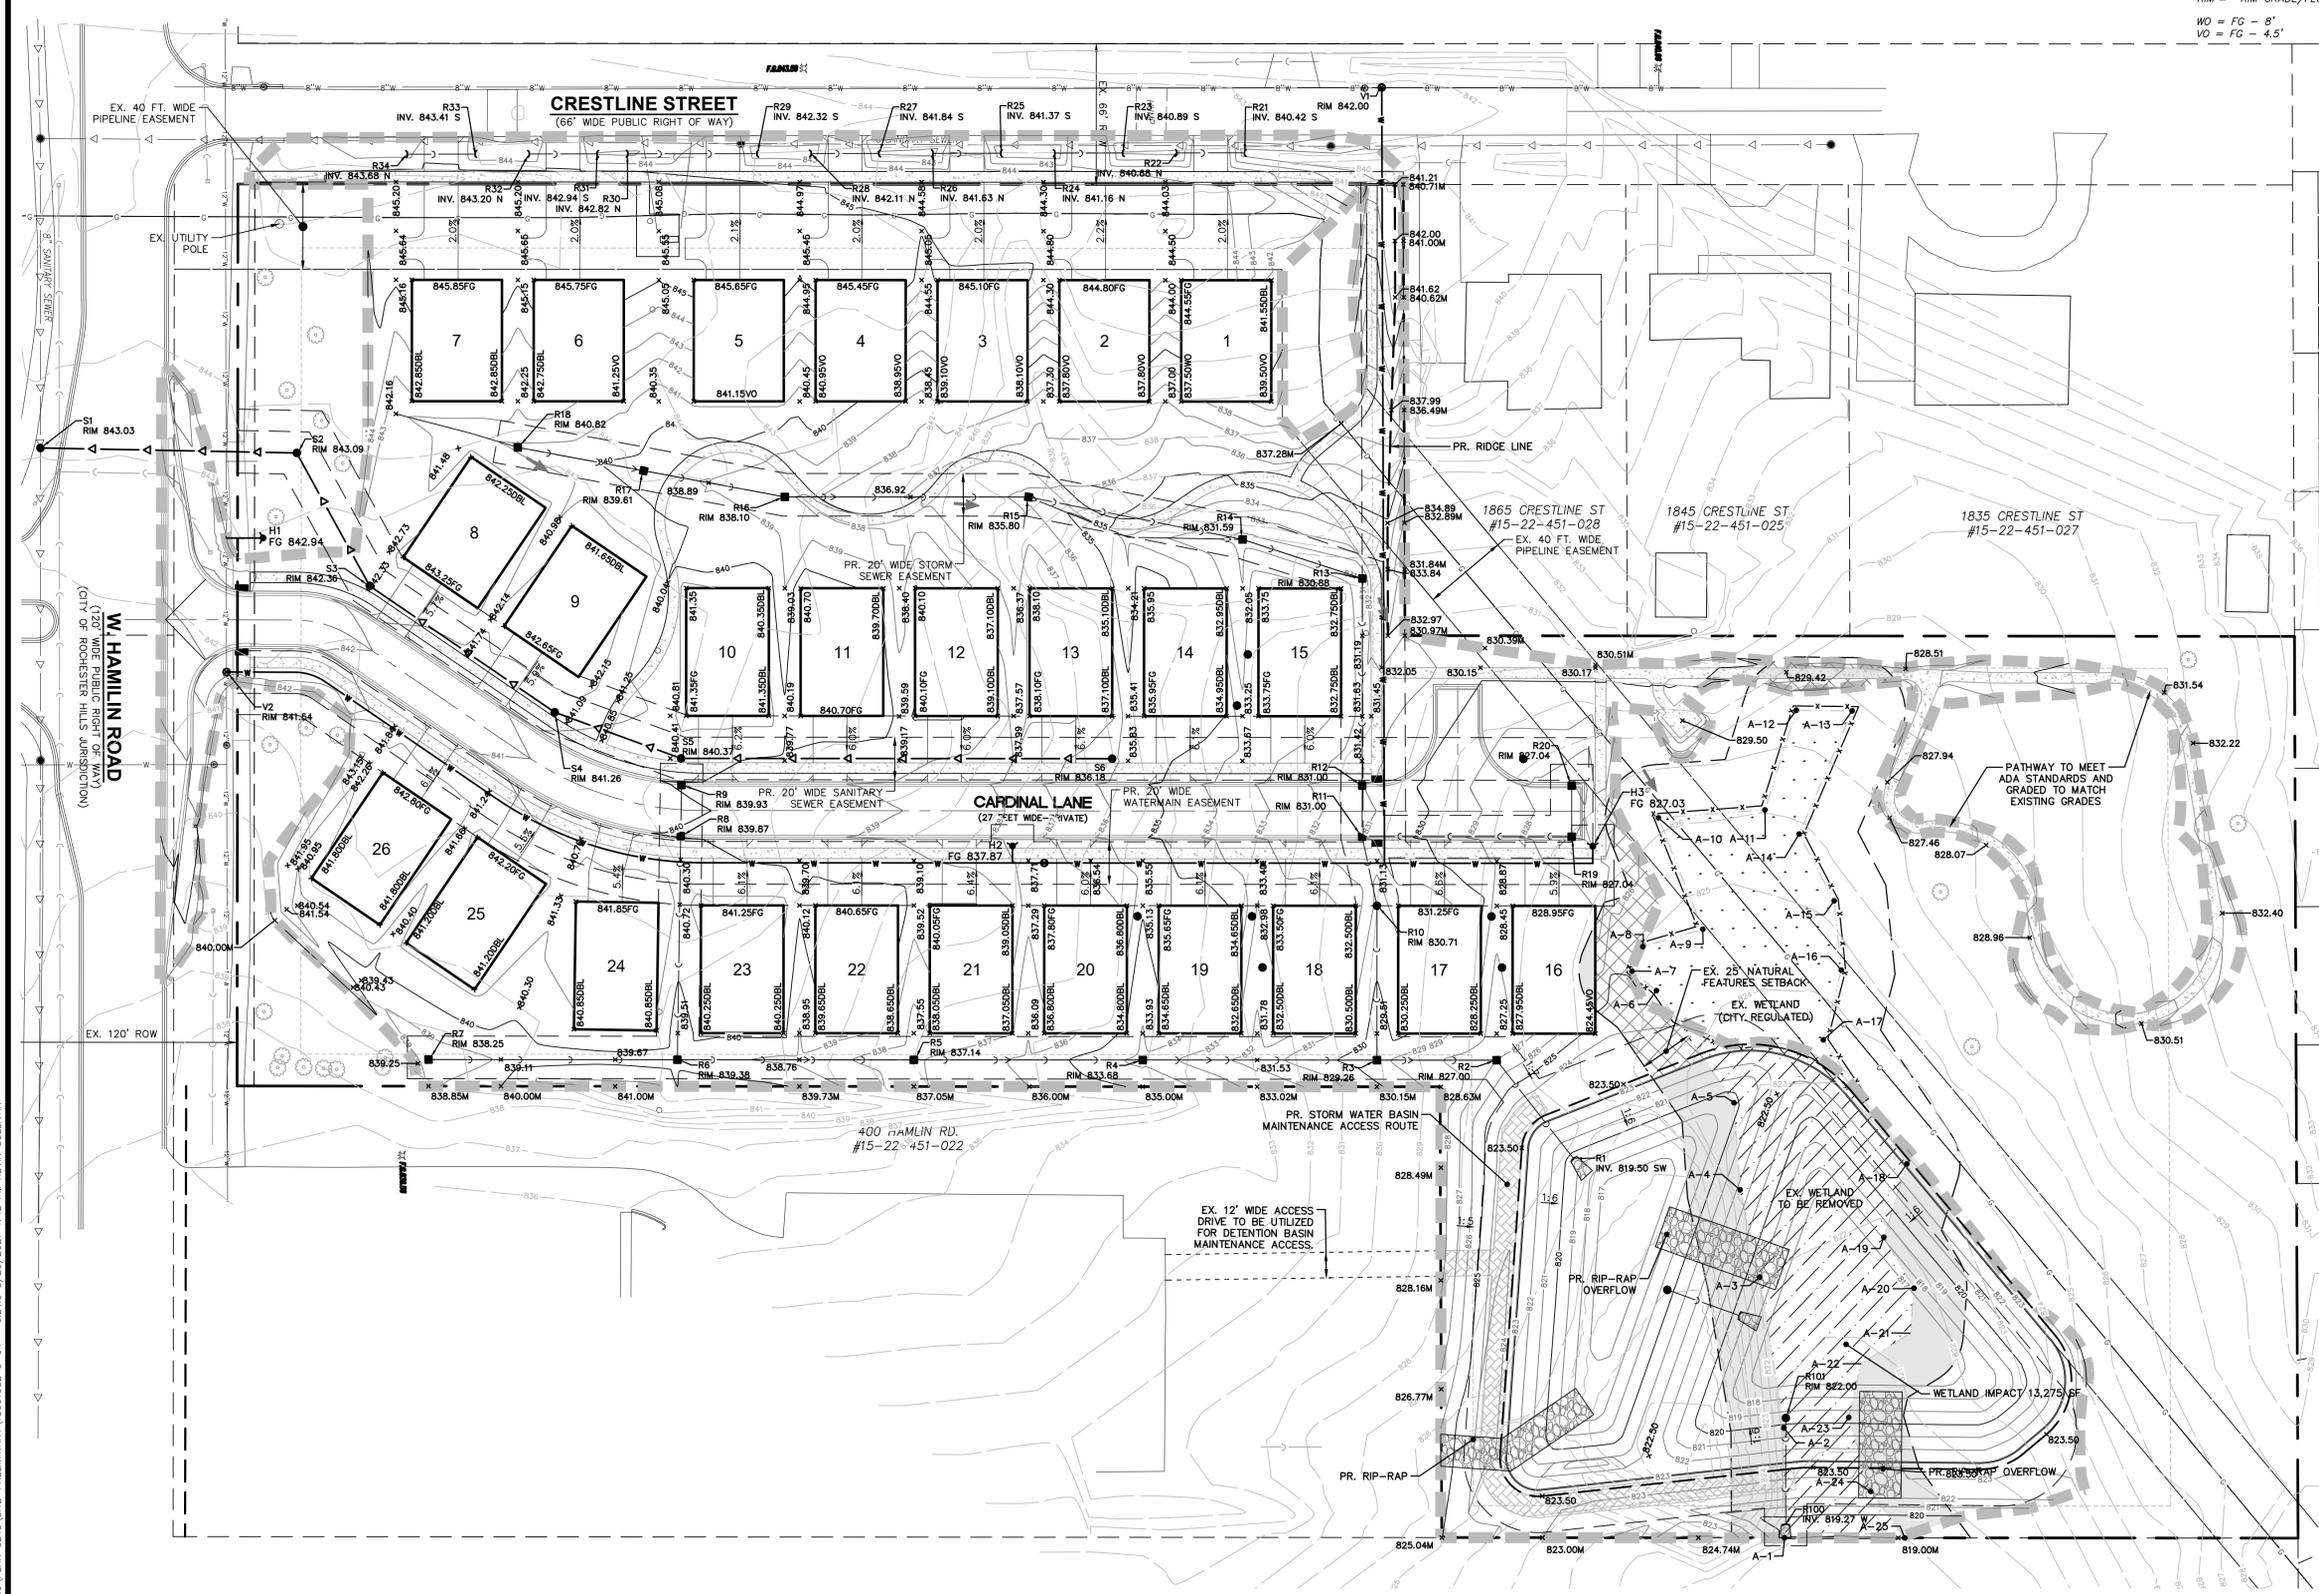

NOT FOR CONSTRUCTION

CITY FILE #19-031
SECTION #22

K:\18001982\DWG\PLAN SETS\SITE-PRELIMINARY\18001982 C-04 - GDWG 8/20/2021 4:42 PM KEVIN SULLIVAN

CAD FILE: 18001982 C-04 - GDWG



Know what's Below.
Call before you dig.

THE LOCATIONS OF EXISTING UNDERGROUND UTILITIES ARE SHOWN IN AN APPROXIMATE WAY ONLY AND HAVE NOT BEEN INDEPENDENTLY VERIFIED BY THE OWNER OR ITS REPRESENTATIVE. THE CONTRACTOR SHALL DETERMINE THE EXACT LOCATION OF ALL EXISTING UTILITIES BEFORE COMMENCING WORK AND AGREES TO BE FULLY RESPONSIBLE FOR ANY AND ALL DAMAGES WHICH MIGHT BE OCCASIONED BY THE CONTRACTOR'S FAILURE TO EXACTLY LOCATE AND PRESERVE ANY AND ALL UNDERGROUND UTILITIES.

NOTICE: CONSTRUCTION SITE SAFETY IS THE SOLE RESPONSIBILITY OF THE CONTRACTOR. NEITHER THE OWNER NOR THE ENGINEER SHALL BE EXPECTED TO ASSUME ANY RESPONSIBILITY FOR SAFETY OF THE WORK OF PERSONS ENGAGED IN THE WORK OF ANY NEARBY STRUCTURES, OR OF ANY OTHER PERSONS.

COPYRIGHT © 2021 ATWELL, LLC. NO REPRODUCTION SHALL BE MADE WITHOUT THE PRIOR WRITTEN CONSENT OF ATWELL, LLC.




SECTION 22
TOWN 3 NORTH, RANGE 11 EAST
CITY OF ROCHESTER HILLS
OAKLAND COUNTY, MICHIGAN

M2J1, LLC
CAMDEN CROSSING
PRELIMINARY SITE PLAN
UTILITY PLAN

DATE: AUG. 16, 2019
2020-06-15 PER CITY
2021-01-21 PER CITY
2021-07-02 PER CITY
2021-08-23 PER CITY

Table with 2 columns: REVISIONS, SCALE: 1" = 40 FEET, DRAWN BY: KS, CHECKED BY: JA, P.M.: JACKERMAN, JOB #: 18001982, FILE CODE: -, SHEET NO. C-04

LEGEND

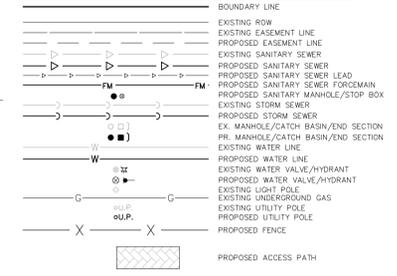

UTILITY NARRATIVE

SANITARY SEWER - PROPOSED GRAVITY SEWER WILL CONNECT TO THE EXISTING 8" SANITARY SEWER ON THE SOUTH SIDE OF HAMLIN RD. PROPOSED UNITS 14-20 WILL BE SERVICED BY GRINDER PUMP AND LOW PRESSURE FORCEMAIN SYSTEM DUE TO SHALLOW EXISTING SEWER ELEVATIONS. PROPOSED UNITS 1-13 AND 21-26 WILL BE SERVICED BY GRAVITY SEWER. GRINDER PUMP LOCATIONS ARE PRELIMINARY AND THE FINAL LOCATION AND DESIGN ARE TO BE DETERMINED DURING DETAILED ENGINEERING AND PLOT PLAN.

WATERMAIN - THE PROPOSED 8" WATERMAIN WILL HAVE A MINIMUM COVER OF 6" AND CONNECT TO EXISTING MAIN ON THE NORTH SIDE OF HAMLIN ROAD AND WILL LOOP INTO THE EXISTING MAIN ON THE WEST SIDE OF CRESTLINE ST.



STORM WATER MANAGEMENT - ON-SITE RUN-OFF WILL BE COLLECTED IN A PROPOSED STORM SEWER SYSTEM AND CONVEYED TO A PROPOSED DETENTION BASIN LOCATED AT THE NORTH EASTERN AREA OF THE SITE. THE NEW BASIN WILL BE SIZED TO ACCOMMODATE THE EXISTING DETENTION PREVIOUSLY PROVIDED FOR THE CHURCH PARCEL AS WELL AS THE 25 YEAR STORM EVENT FOR THE PROPOSED DEVELOPMENT AREA. THE BASIN WILL DISCHARGE TO THE ADJACENT EXISTING WETLAND. THE PRETREATMENT REQUIREMENT WILL BE MET BY PROVIDING A SEDIMENT FOREBAY WITHIN THE BASIN. FRONT YARD DRAINAGE FOR UNITS 1-7 ALONG CRESTLINE STREET WILL BE DIRECTED TO THE ROADSIDE DITCH AND WILL FLOW NORTH, FOLLOWING THE EXISTING DRAINAGE COURSE. ROOF RUN-OFF FOR UNITS 1-7 WILL BE DIRECTED TO THE REAR YARD TO BE CAPTURED IN THE ON-SITE STORMWATER SYSTEM.

SANITARY SEWER BASIS OF DESIGN

Table with 2 columns: Parameter, Value. Includes Total No. of Single Family Lots (26), No. of Users per Lot (2.44), Average Daily Flow (100 G.P.D.), Peaking Factor (4.29), Average Flow (6,400 G.P.D.), Peak Flow (27,468 G.P.D.), Pipe Capacity (8 in. diameter), Manning's Capacity (0.766 C.F.S.), Velocity Flowing Full (2.20 F.P.S.).

Provide a Legal Document verifying this existing access drive can be utilized, the document provided allowed access for the Church to maintain the existing detention pond. An offsite cross access agreement will need to be provided if one doesn't currently exist. If one can not be agreed upon an onsite access drive will be necessary.

EX. 12' WIDE ACCESS DRIVE TO BE UTILIZED FOR DETENTION BASIN MAINTENANCE ACCESS.

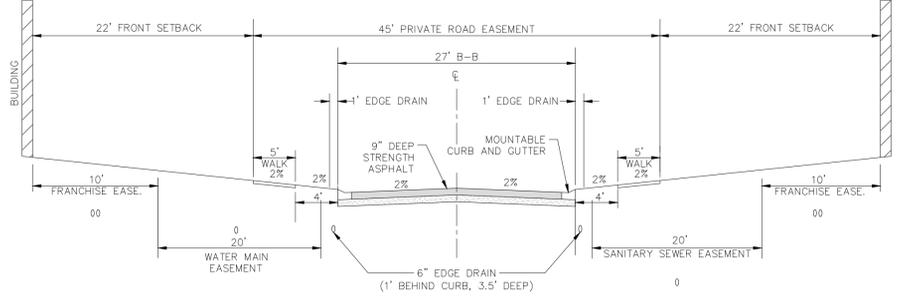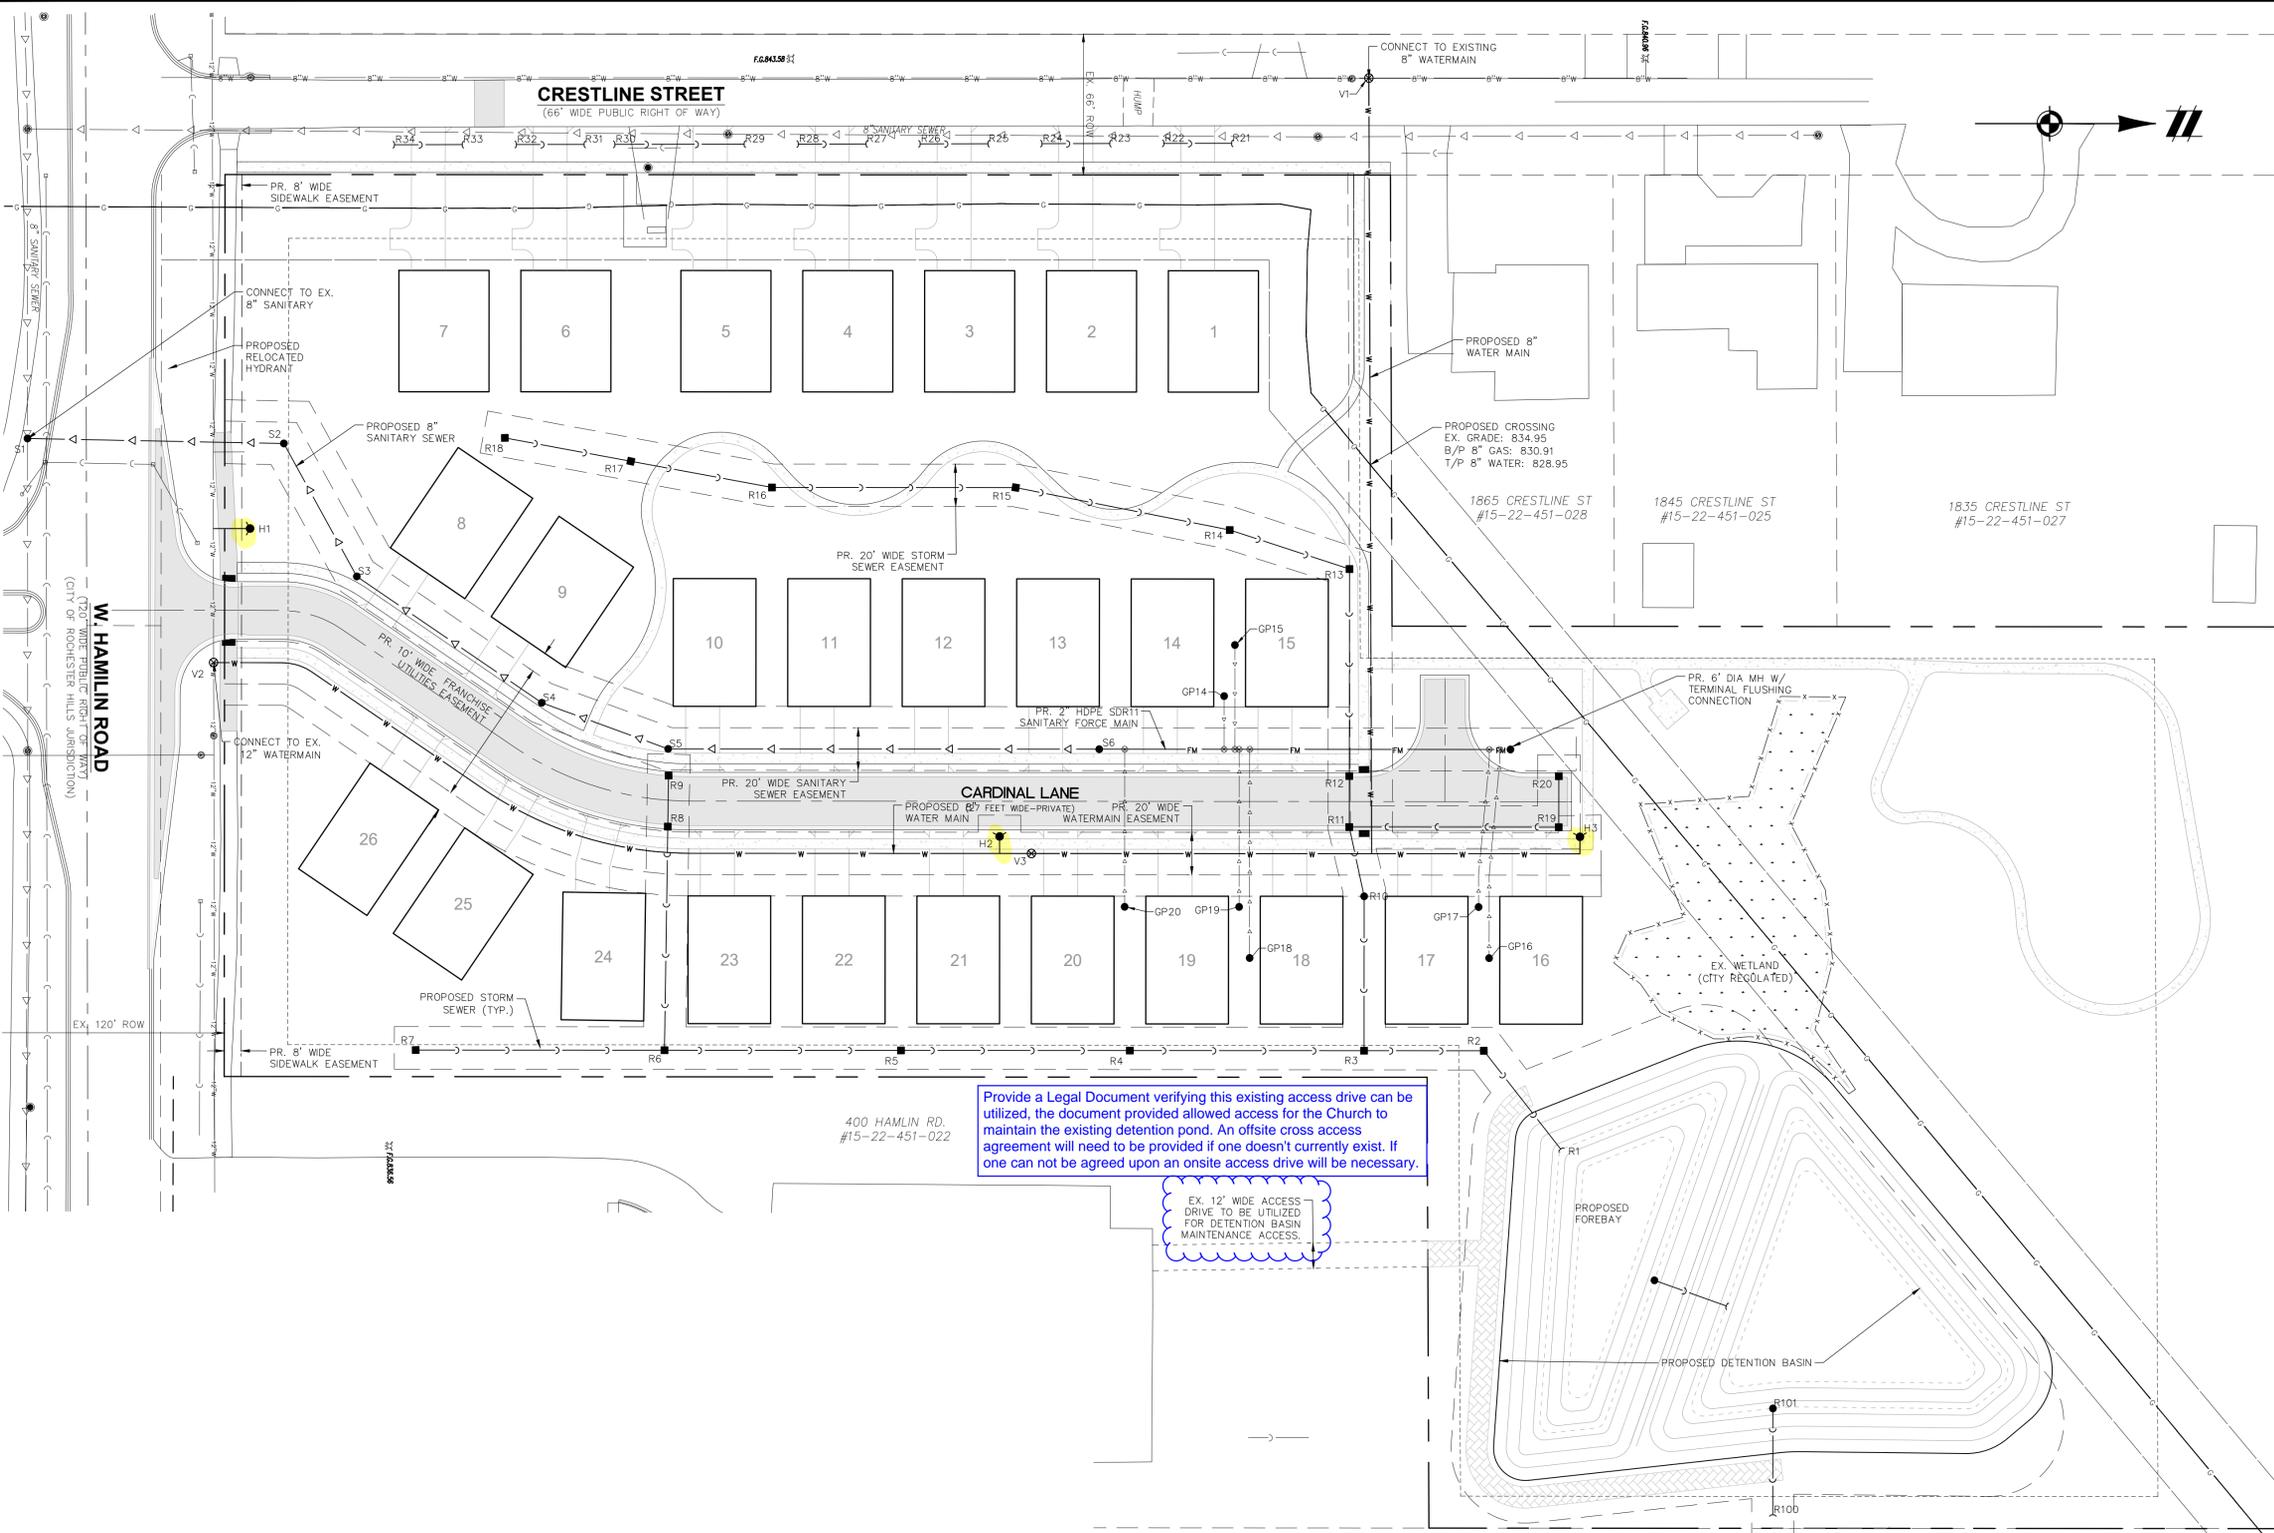

TYPICAL ROAD CORRIDOR
NO SCALE

NOT FOR CONSTRUCTION

K:\18001982\DWG\PLAN_SITES\PRELIMINARY\18001982_C-05 - U.DWG 8/20/2021 4:42 PM KEVIN SULLIVAN

CAD FILE: 18001982_C-05 - U.DWG



Know what's below.

THE LOCATIONS OF EXISTING UNDERGROUND UTILITIES ARE SHOWN IN AN APPROXIMATE WAY ONLY AND HAVE NOT BEEN INDEPENDENTLY VERIFIED BY THE OWNER OR ITS REPRESENTATIVE. THE CONTRACTOR SHALL DETERMINE THE EXACT LOCATION OF ALL EXISTING UTILITIES BEFORE COMMENCING WORK AND AGREES TO BE FULLY RESPONSIBLE FOR ANY AND ALL DAMAGES WHICH MIGHT BE OCCASIONED BY THE CONTRACTOR'S FAILURE TO EXACTLY LOCATE AND PRESERVE ANY AND ALL UNDERGROUND UTILITIES.

NOTICE: CONSTRUCTION SITE SAFETY IS THE SOLE RESPONSIBILITY OF THE CONTRACTOR. NEITHER THE OWNER NOR THE ENGINEER SHALL BE EXPECTED TO ASSUME ANY RESPONSIBILITY FOR SAFETY OF THE WORK OF PERSONS ENGAGED IN THE WORK OF ANY NEARBY STRUCTURES OR OF ANY OTHER PERSONS.

COPYRIGHT © 2021 ATWELL, LLC. NO REPRODUCTION SHALL BE MADE WITHOUT THE PRIOR WRITTEN CONSENT OF ATWELL, LLC.



SECTION 22
TOWN 3 NORTH, RANGE 11 EAST
CITY OF ROCHESTER HILLS
OAKLAND COUNTY, MICHIGAN


M2JI, LLC
CAMDEN CROSSING
PRELIMINARY SITE PLAN
OVERALL DRAINAGE AREA PLAN

DATE: AUG. 16, 2019
2020-06-15 PER CITY
2021-01-21 PER CITY
2021-07-02 PER CITY
2021-08-23 PER CITY

REVISIONS
SCALE: 1" = 40 FEET
DRAWN BY: KS
CHECKED BY: JA
P.M.: JACKERMAN
JOB #: 18001982
FILE CODE: -
SHEET NO. C-05

LEGEND

588	PR. 1' CONTOUR
590	PR. 5' CONTOUR
588	EX. 1' CONTOUR
590	EX. 5' CONTOUR
---	PROPERTY LINE
---	CENTERLINE OF SWALE
---	PROPOSED R.O.W. LINE
---	LIMITS OF GRADING
○	EX. MANHOLE / CATCH BASIN
□	PR. MANHOLE / CATCH BASIN

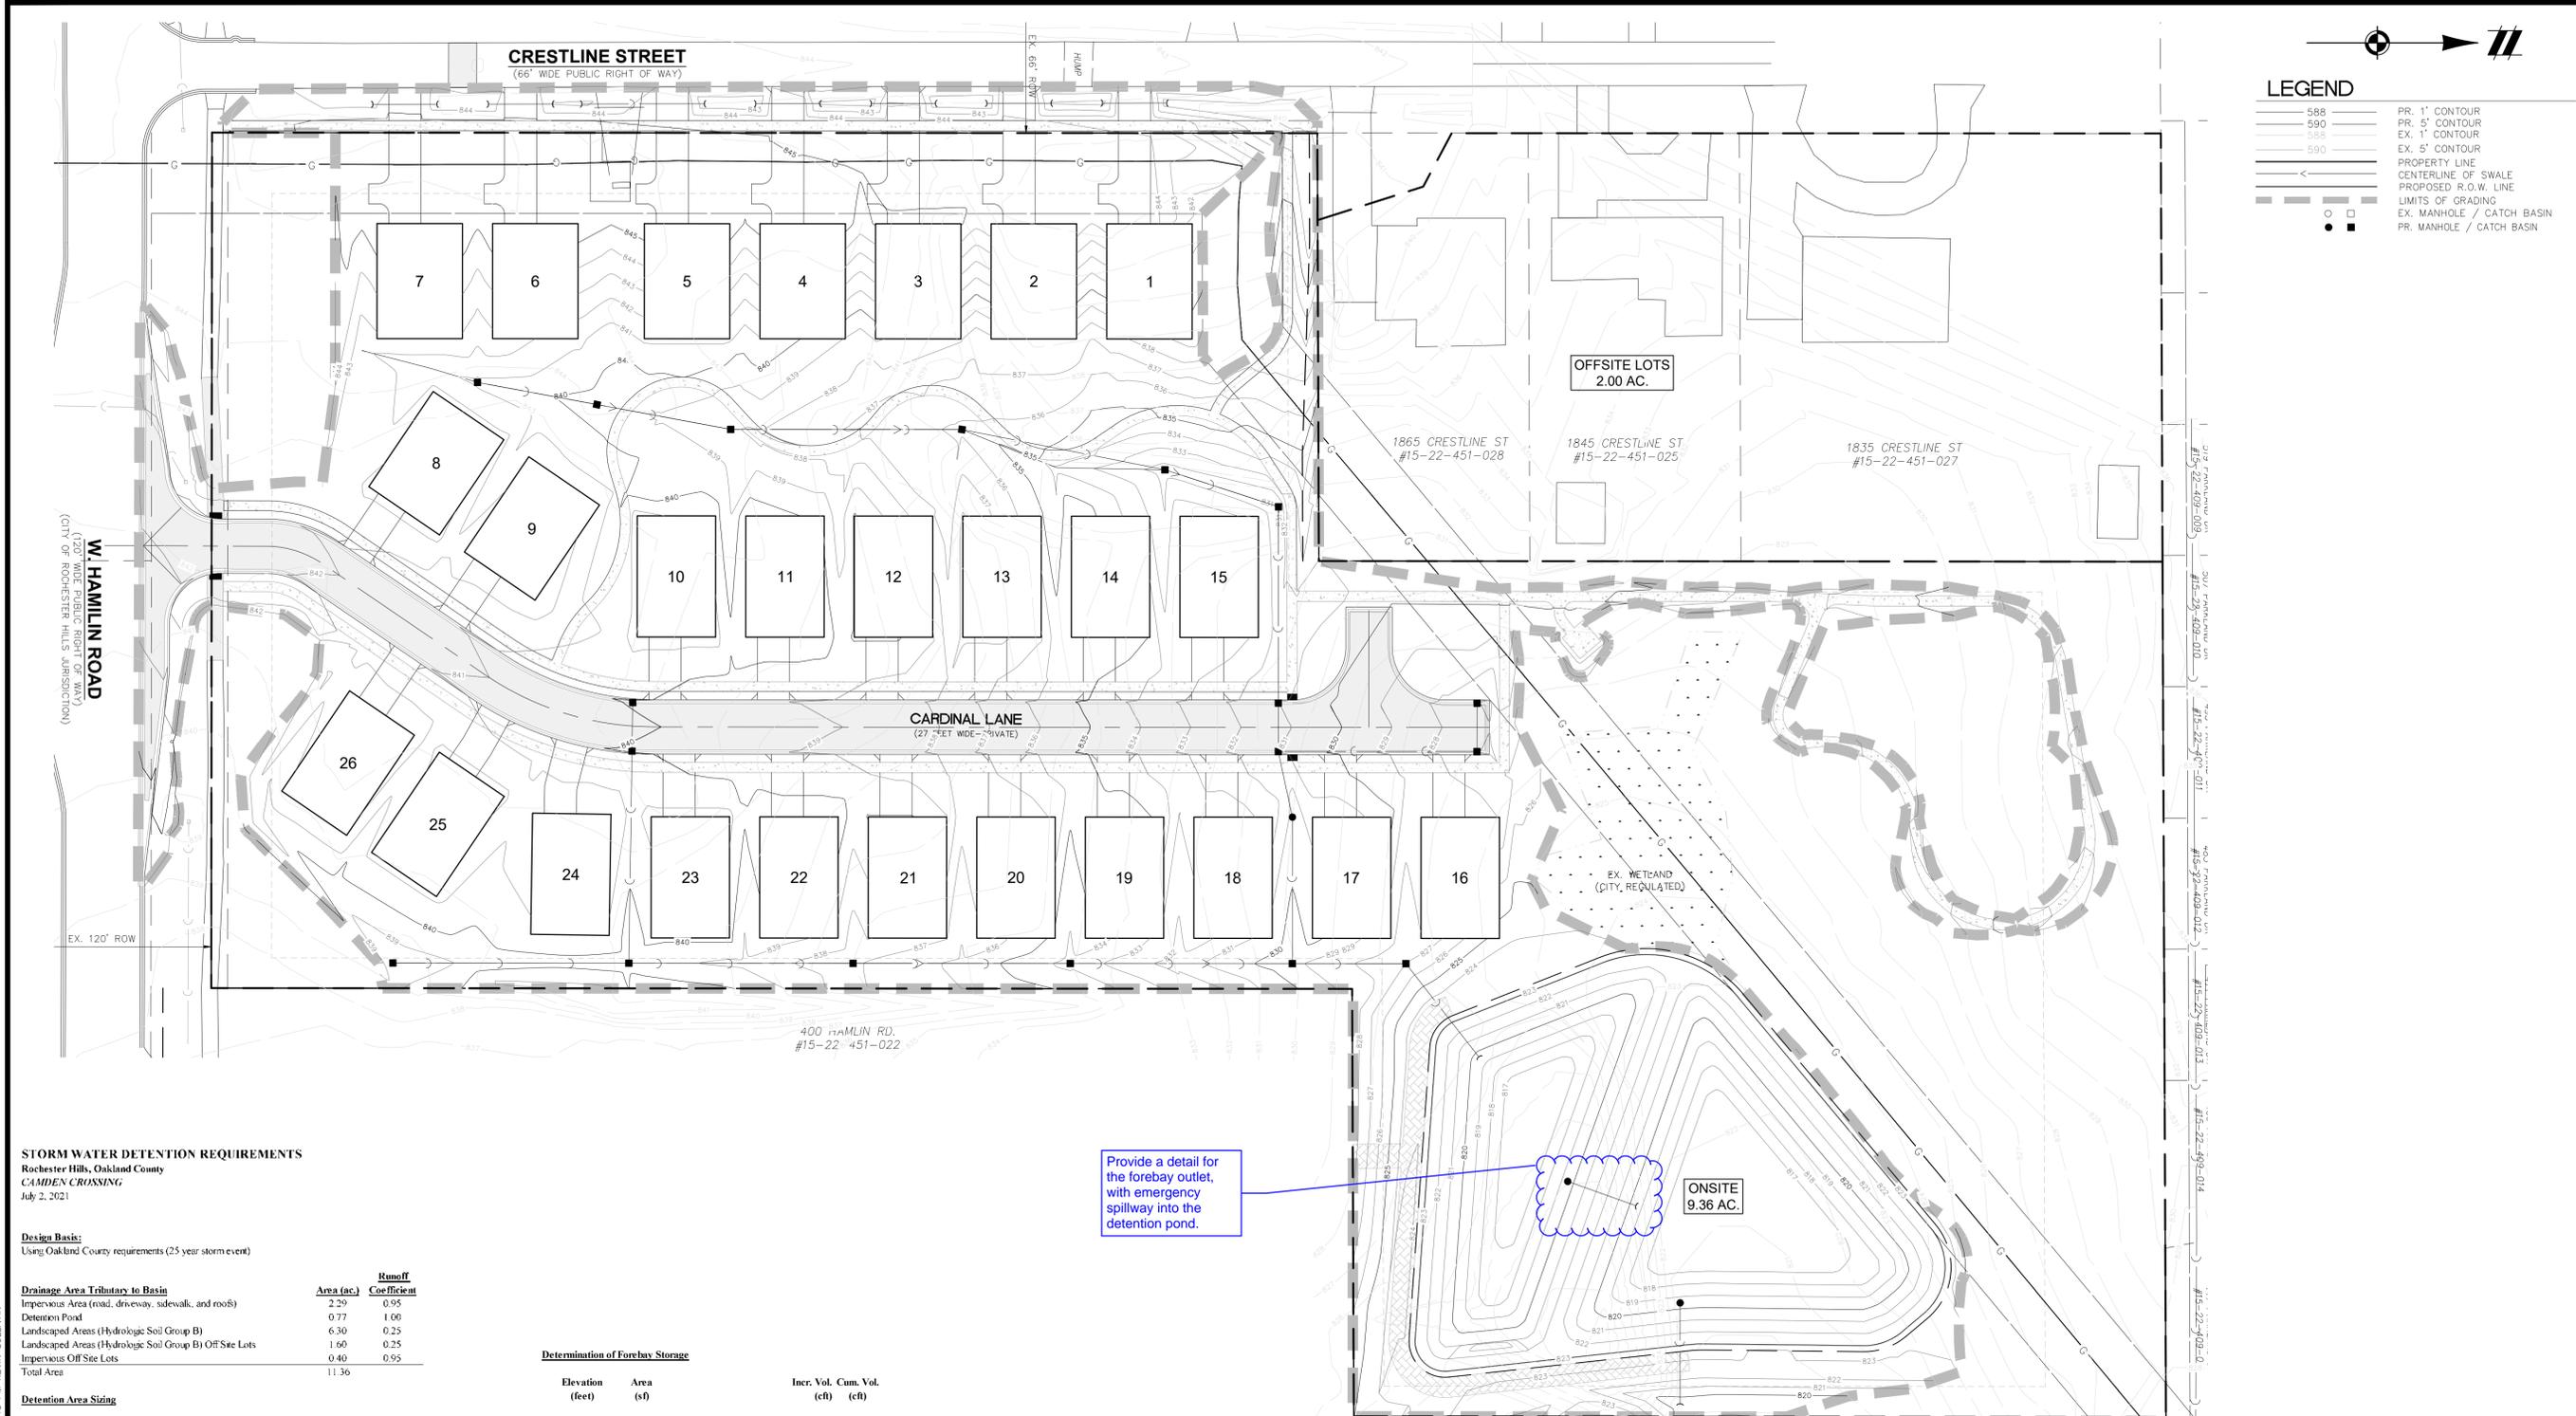

STORM WATER DETENTION REQUIREMENTS
Rochester Hills, Oakland County
CAMDEN CROSSING
July 2, 2021

Design Basis:
Using Oakland County requirements (25 year storm event)

Drainage Area Tributary to Basin	Area (ac.)	Runoff Coefficient
Impervious Area (road, driveway, sidewalk, and roofs)	2.29	0.95
Detention Pond	0.77	1.00
Landscaped Areas (Hydrologic Soil Group B)	6.30	0.25
Landscaped Areas (Hydrologic Soil Group B) Off Site Lots	1.60	0.25
Impervious Off Site Lots	0.40	0.95
Total Area	11.36	

Detention Area Sizing

1) Total Tributary Area	=	11.36
Developed Runoff Coefficient (C)	=	0.47
Allowable Discharge Rate (C _a)	=	0.20 cfs/ac
2) Maximum Allowable Runoff, Q _a = C _a x A	=	2.27 cfs
Maximum Allowable Runoff, Church Parcel Detention Calculations	=	0.70 cfs
Total Maximum Allowable Runoff	=	2.97 cfs
3) Calculate Q _o Q _a / (a * c)	=	0.43 cfs/acre impervious
(max. outflow per acre impervious)		
4) Max. Storage Time, T = +25 sqrt(8062.5*Q _o)	=	112.10 minutes
5) Max. Storage Required, V _s = ((12,900*T) / (T+25)) - 40Q _o T	=	8,624 cfs/acre impervious
6) Total Storage Required, V _t = V _s * a * c	=	45,685 cf
As-Built Volume of Existing Church Basin	=	10,541 cf
(Per As-Built St. Mark Church plans dated 8-19-1999)		
Total Storage Required	=	56,226 cf
7) 1-Year Storm Calculation for Forebay		
Total Storage (V _t = 4,320 x A x C)	=	22,884 cf
8) Sizing of Overflow Weir		
Q = CLH ^{3/2}		
Q (CIA) =	10.62 cfs	
L =	? ft	
H =	0.5 ft	
C =	3.367	
L = Q/(3.367 * H ^{3/2}) =		9 ft

Determination of Forebay Storage

Elevation (feet)	Area (sf)	Incr. Vol. (cf)	Cum. Vol. (cf)
819.5	7,200		
820	8,500	3,925	3,925
821	11,300	9,900	13,825
822	14,400	12,850	26,675
Total Volume =		26,675 cf	

Determination of Storage Provided in Basin (Including Forebay Storage)

Elevation (feet)	Area (sf)	Incr. Vol. (cf)	Cum. Vol. (cf)
819.5	18,600		
820	21,400	10,000	10,000
821	27,300	24,350	34,350
822	33,800	30,550	64,900
Total Volume =		64,900 cf	

Storage & Elevation Summary


Actual 25-Year Storm Elevation	=	821.72
Design 25-Year Storm Elevation	=	822.00 feet
Top of Bank Elevation	=	823.50 feet
Minimum Top of Bank Elevation	=	824.00 feet
Bankfull Volume: V _{bf} = 6,897 x C x A	=	36,535 cf
Bankfull Elevation	=	821.07 feet
Volume Provided	=	64,900 pl
Volume Required	=	56,226 cf

Checking 100-yr Overflow Structure Size (O.S.1)

Size of Outlet Structure	=	4 ft
Percent of Structure that can be used as weir	=	100%
Calculated Length of weir	=	12.56 ft
Area of Tributary to weir	=	11.36 Ac
Composite Runoff Coefficient	=	0.47
Longest time of flow to Basin (Preliminary Assumption)	=	25 min
Flow into Basin: Q CIA	=	18.54 cfs
Volume of Basin	=	56,226 cf
Storage Elevation (O.S.1 Rim Elevation)	=	822.00 ft
Actual Top of Bank Elevation	=	823.50 ft
Time to fill Basin: V/Q	=	50.54 min
Intensity = 275/(T+25)	=	2.74 in/hr
Q Expected = Q _e CIA	=	14.49 cfs

Sizing Overflow Outlet Pipe

Size of pipe	=	18 in
Area (a) =	=	1.77 sf
Pipe Invert	=	819.50 ft
Springline =	=	820.25 ft
Overflow Elev =	=	823.01 ft
Head (h) =	=	4.18 ft
Capacity = 0.62 * a * sqrt(2gh)	=	17.96 cfs
Q Expected (from above)	=	14.49 cfs
Capacity > Q Expected	=	OK

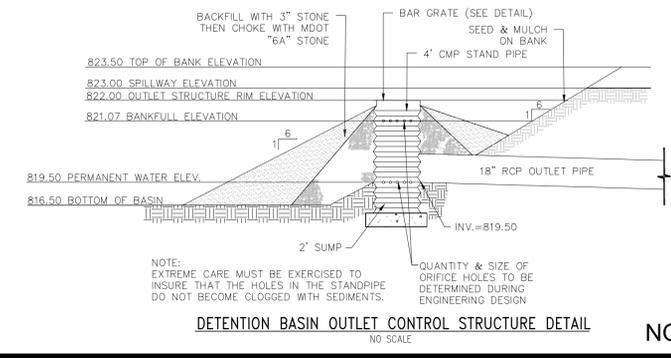



NOTE: EXTREME CARE MUST BE EXERCISED TO INSURE THAT THE HOLES IN THE STANDPIPE DO NOT BECOME CLOGGED WITH SEDIMENTS.

DETENTION BASIN OUTLET CONTROL STRUCTURE DETAIL
NO SCALE

NOT FOR CONSTRUCTION

K:\18001982\DWG\PLAN SETS\SITE-PRELIMINARY\18001982-C-05 - DET.DWG: 8/20/2021 4:43 PM KEVIN SULLIVAN

Construction type V with a maximum of 2,313 sq. ft. per house requires a fire flow of 1,000 GPM and an average fire hydrant spacing of 500 feet. Provide documentation, including calculations that a fire flow of 1,000 GPM can be provided. Flow test information can be obtained by contacting the Rochester Hills Engineering Department at 248-656-4640.

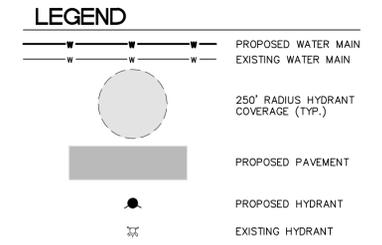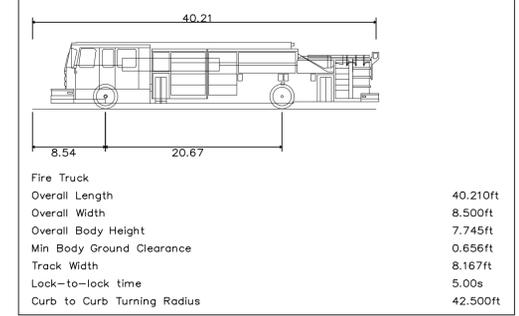


811
Know what's below.
Call before you dig.
THE LOCATIONS OF EXISTING UNDERGROUND UTILITIES ARE SHOWN IN AN APPROXIMATE WAY ONLY AND HAVE NOT BEEN INDEPENDENTLY VERIFIED BY THE OWNER OR ITS REPRESENTATIVE. THE CONTRACTOR SHALL DETERMINE THE EXACT LOCATION OF ALL EXISTING UTILITIES BEFORE COMMENCING WORK, AND AGREES TO BE FULLY RESPONSIBLE FOR ANY AND ALL DAMAGES WHICH MIGHT BE OCCASIONED BY THE CONTRACTOR'S FAILURE TO EXACTLY LOCATE AND PRESERVE ANY AND ALL UNDERGROUND UTILITIES.

NOTICE:
CONSTRUCTION SITE SAFETY IS THE SOLE RESPONSIBILITY OF THE CONTRACTOR. NEITHER THE OWNER NOR THE ENGINEER SHALL BE EXPECTED TO ASSUME ANY RESPONSIBILITY FOR SAFETY OF THE WORK OF PERSONS ENGAGED IN THE WORK OF ANY NEARBY STRUCTURES, OR OF ANY OTHER PERSONS.

COPYRIGHT © 2021 ATWELL, LLC. NO REPRODUCTION SHALL BE MADE WITHOUT THE PRIOR WRITTEN CONSENT OF ATWELL, LLC.

- FIRE DEPARTMENT NOTES:**
- FIRE LANES SHALL BE DESIGNATED BY THE FIRE CODE OFFICIAL, AND SHALL BE CONSPICUOUSLY POSTED ON BOTH SIDES OF THE FIRE LANE, WITH FIRE LANE SIGNS, SPACED NOT MORE THAN 100 FEET APART. FIRE LANE SIGNS SHALL READ "NO STOPPING, STANDING, PARKING, FIRE LANE", AND SHALL CONFORM TO THE MICHIGAN MANUAL OF UNIFORM TRAFFIC CONTROL DEVICES, FIRE PREVENTION ORDINANCE CHAPTER 58, SEC. 503
 - CONSTRUCTION SITES SHALL BE SAFEGUARDED IN ACCORDANCE WITH IFC 2006 CHAPTER 14.
 - OPEN BURNING IS NOT PERMITTED INCLUDING THE BURNING OF TRASH, DEBRIS, OR LAND CLEARING MATERIALS. OPEN BURNING FOR WARMING OF SAND AND/OR WATER FOR THE PREPARATION OF MORTAR SHALL BE WITHIN THE CITY OF ROCHESTER HILLS BURN PERMIT GUIDELINES, FIRE PREVENTION ORDINANCE CHAPTER 58, SEC. 307.6.2 & 307.6.2.3
 - BUILDING CONSTRUCTION TYPE WILL BE WOOD FRAME.
 - THE TYPICAL SQUARE FOOTAGE OF EACH UNIT IS AS FOLLOWS:
TYPE A = 1,826 SF
TYPE B = 2,313 SF OR 2,120 SF

ATWELL
866.850.4200 www.atwell-group.com
TWO TOWNE SQUARE, SUITE 700
SOUTHFIELD, MI 48076
248.447.2600

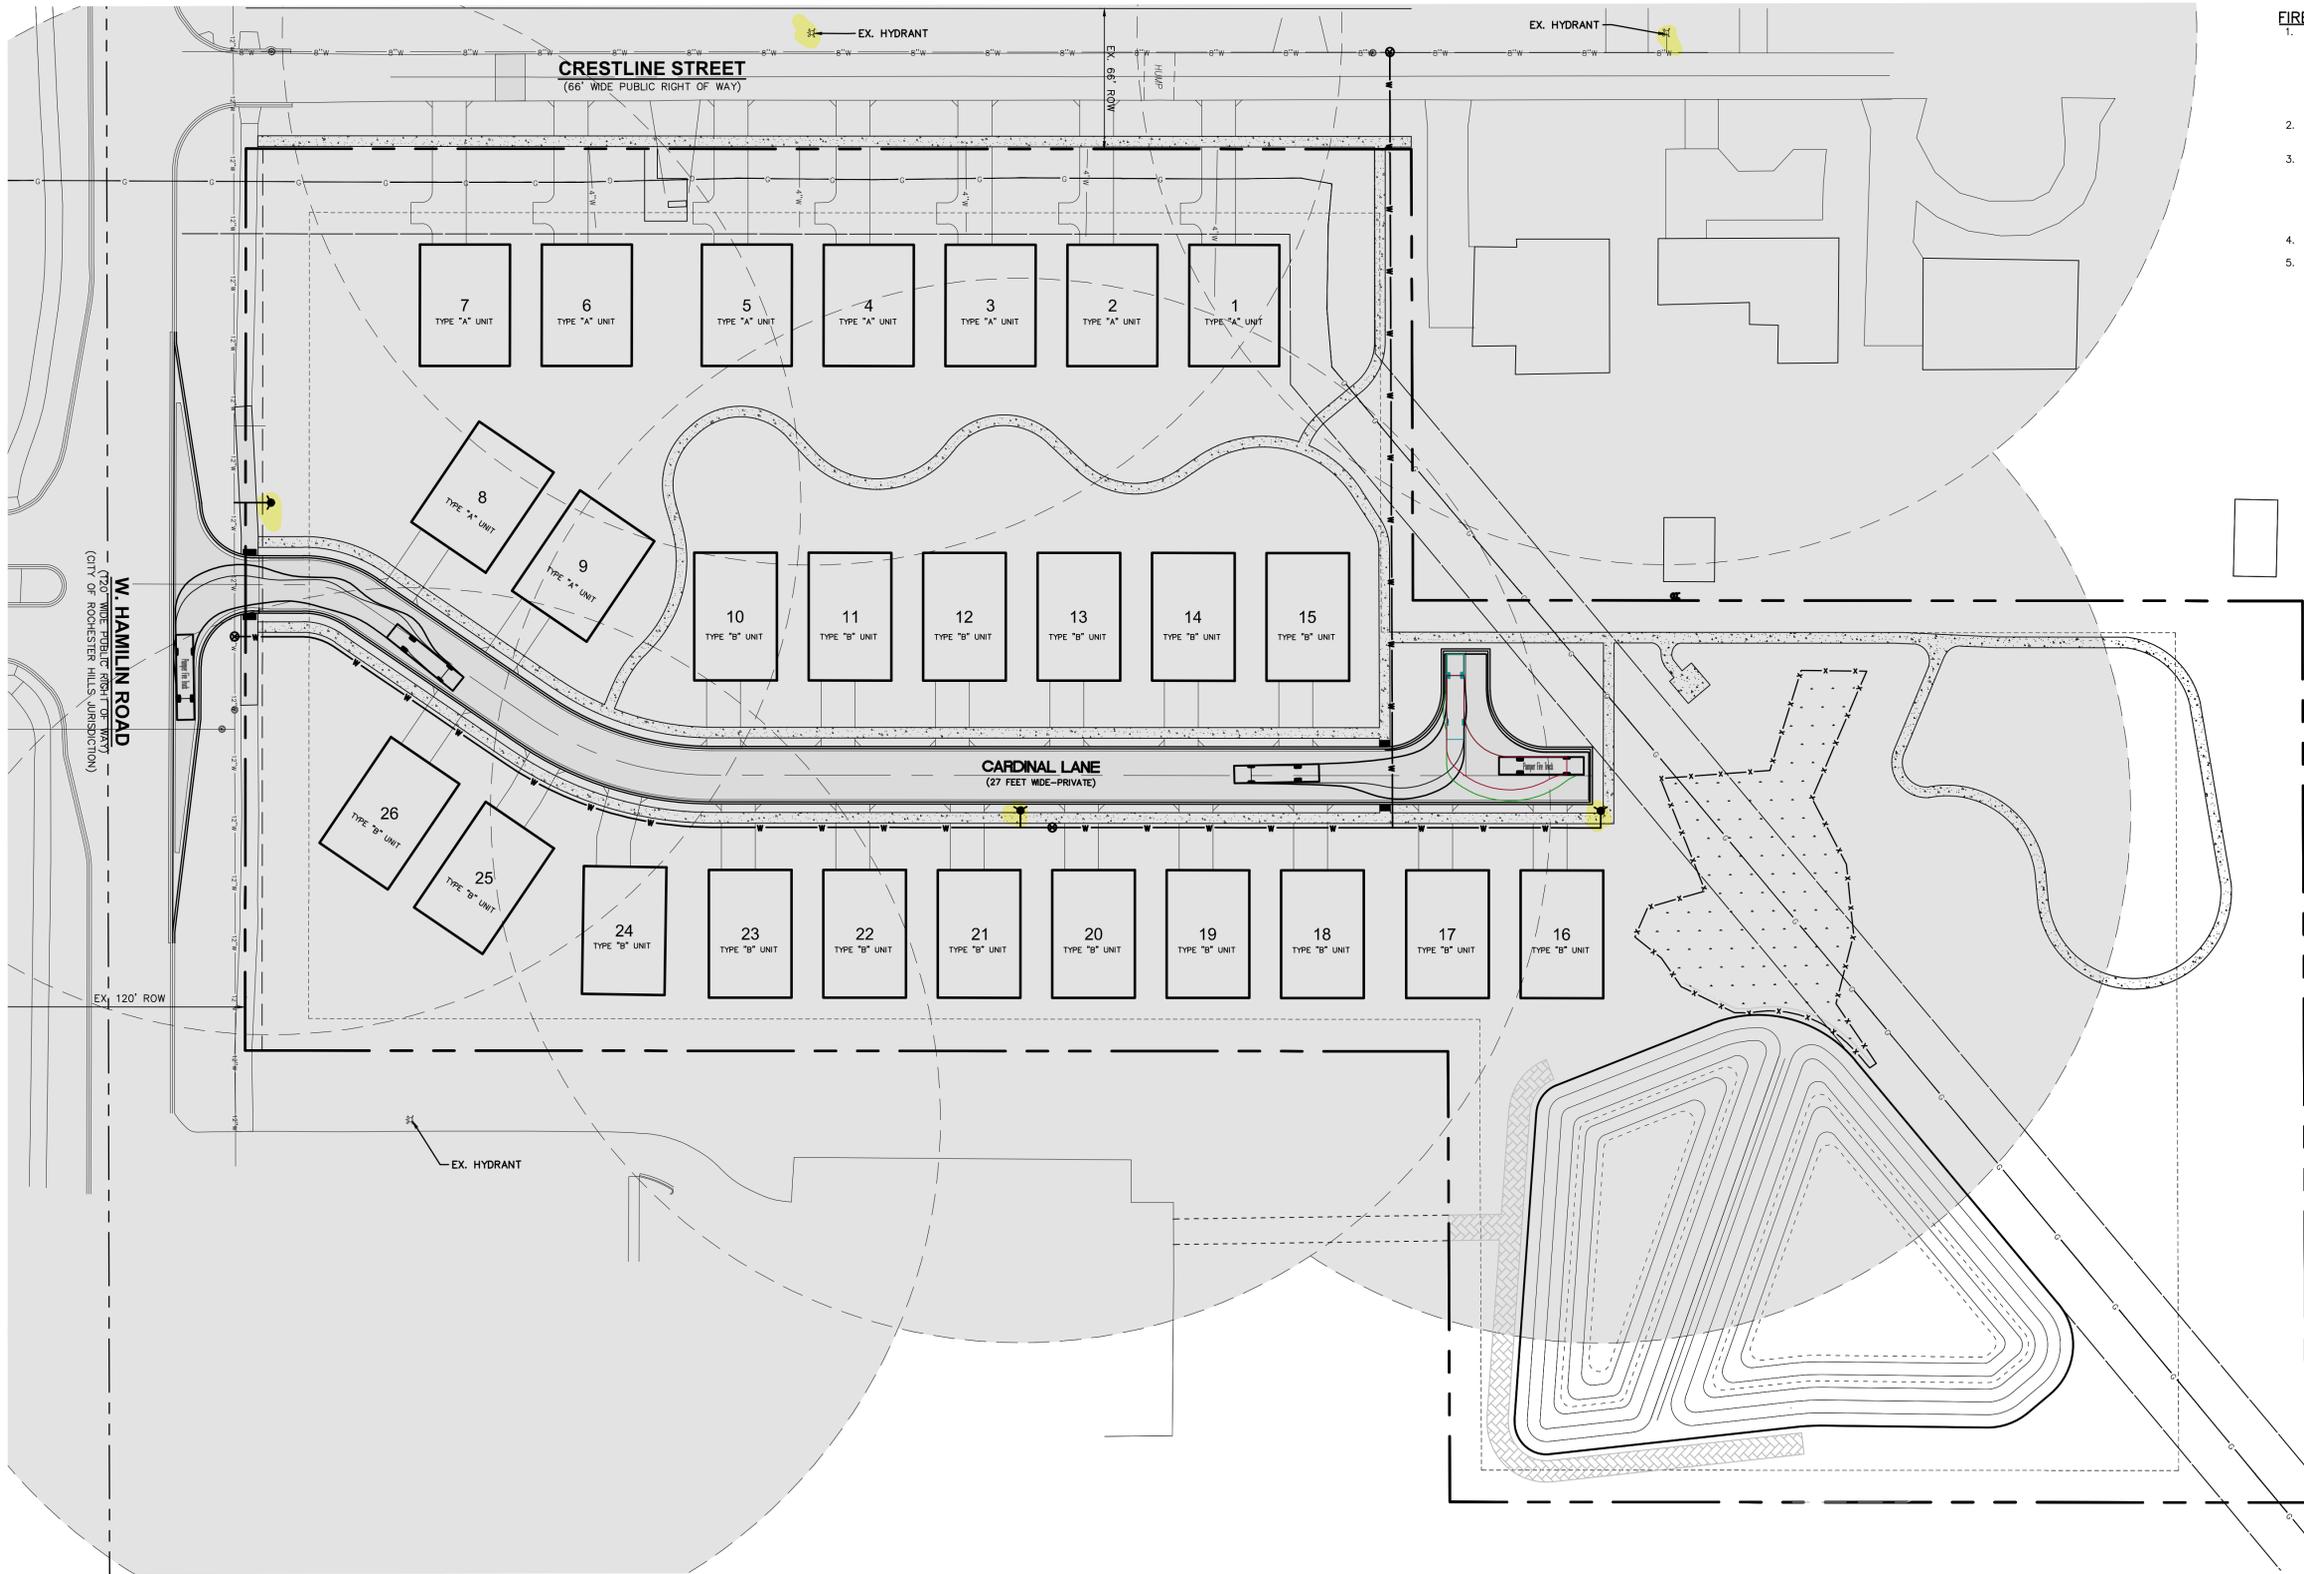

SECTION 22
TOWN 3 NORTH, RANGE 11 EAST
CITY OF ROCHESTER HILLS
OAKLAND COUNTY, MICHIGAN

M2J, LLC
CAMDEN CROSSING
PRELIMINARY SITE PLAN
FIRE PROTECTION PLAN

DATE
AUG. 16, 2019
2020-06-15 PER CITY
2021-01-21 PER CITY
2021-07-02 PER CITY
2021-08-23 PER CITY

REVISIONS

SCALE: 1" = 40 FEET

DRAWN BY: KS
CHECKED BY: JA
P.M.: JACKERMAN
JOB #: 18001982
FILE CODE: -
SHEET NO. C-06

CITY FILE #19-031
SECTION #22

NOT FOR CONSTRUCTION

K:\18001982\DWG\PLAN SETS\SITE #PRELIMINARY\18001982_C-06 - PF.DWG 8/23/2021 10:19 AM KEVIN SULLIVAN

CAD FILE: 18001982_C-06 - PF.DWG



Know what's below. Call before you dig.

THE LOCATIONS OF EXISTING UNDERGROUND UTILITIES ARE SHOWN IN AN APPROXIMATE WAY ONLY AND HAVE NOT BEEN INDEPENDENTLY VERIFIED BY THE OWNER OR ITS REPRESENTATIVE. THE CONTRACTOR SHALL DETERMINE THE EXACT LOCATION OF ALL EXISTING UTILITIES BEFORE COMMENCING WORK, AND AGREES TO BE FULLY RESPONSIBLE FOR ANY AND ALL DAMAGES WHICH MIGHT BE OCCASIONED BY THE CONTRACTOR'S FAILURE TO EXACTLY LOCATE AND PRESERVE ANY AND ALL UNDERGROUND UTILITIES.

NOTICE: CONSTRUCTION SITE SAFETY IS THE SOLE RESPONSIBILITY OF THE CONTRACTOR. NEITHER THE OWNER NOR THE ENGINEER SHALL BE EXPECTED TO ASSUME ANY RESPONSIBILITY FOR SAFETY OF THE WORK OF PERSONS ENGAGED IN THE WORK, OF ANY NEARBY STRUCTURES, OR OF ANY OTHER PERSONS.

COPYRIGHT © 2021 ATWELL, LLC. NO REPRODUCTION SHALL BE MADE WITHOUT THE PRIOR WRITTEN CONSENT OF ATWELL, LLC.

ATWELL
866.850.4200 www.atwell-group.com
TWO TOWNE SQUARE, SUITE 700
SOUTHFIELD, MI 48076
248.447.2000



SECTION 22
TOWN 3 NORTH, RANGE 11 EAST
CITY OF ROCHESTER HILLS
OAKLAND COUNTY, MICHIGAN

M2J, LLC
CAMDEN CROSSING
PRELIMINARY SITE PLAN
DETAIL SHEET

DATE
AUG. 16, 2019

2020-06-15 PER CITY
2021-01-21 PER CITY
2021-07-02 PER CITY
2021-08-23 PER CITY

REVISIONS

NA NA NA
N/A

DRAWN BY: KS
CHECKED BY: JA
P.M.: JACKERMAN
JOB #: 18001982
FILE CODE: -
SHEET NO.

CITY FILE #19-031
SECTION #22
NOT FOR CONSTRUCTION
C-07

MAXIMUM LANDING SLOPE IS 2.0% IN EACH DIRECTION OF TRAVEL. LANDING MINIMUM DIMENSIONS 5' x 5'. SEE NOTES.

MAXIMUM RAMP CROSS SLOPE IS 2.0%. RUNNING SLOPE 5% - 7% (8.3% MAXIMUM). SEE NOTES.

CURB RAMP TYPE R
(ROLLED SIDES)

CURB RAMP TYPE F
(FLARED SIDES, TWO RAMPS SHOWN)

DEPARTMENT DIRECTOR: Paul C. Argolis
MICHIGAN DEPARTMENT OF TRANSPORTATION
BUREAU OF DEVELOPMENT STANDARD PLAN FOR

CURB RAMP AND DETECTABLE WARNING DETAILS

APPROVED BY: DIRECTOR, BUREAU OF FIELD SERVICES
APPROVED BY: DIRECTOR, BUREAU OF DEVELOPMENT

5-8-2020 PLAN DATE
R-28-J SHEET 1 OF 7

MAXIMUM LANDING SLOPE IS 2.0% IN EACH DIRECTION OF TRAVEL. LANDING MINIMUM DIMENSIONS 5' x 5'. SEE NOTES.

MAXIMUM RAMP CROSS SLOPE IS 2.0%. RUNNING SLOPE 5% - 7% (8.3% MAXIMUM). SEE NOTES.

CURB RAMP TYPE RF
(ROLLED / FLARED SIDES)

SECTION A-A

CURB TYPE	MAXIMUM RISE (INCHES)	A	B
B1	3/4	1	
B2	3/4	1	
B3	3/4	1	
B4	3/4	1	
B5	3/4	1	
C1	1/2	1/2	
C2	1/2	1/2	
C3	1/2	1/2	
C4	1/2	1/2	
C5	1	1/2	
F1	1/2	1/2	
F2	1/2	1/2	
F3	3/4	1/2	
F4	3/4	1/2	
F5	1	1/2	
F6	1	1/2	

FOR CURB TYPES SEE STANDARD PLAN R-30-SERIES

MICHIGAN DEPARTMENT OF TRANSPORTATION
BUREAU OF DEVELOPMENT STANDARD PLAN FOR

CURB RAMP AND DETECTABLE WARNING DETAILS

APPROVED BY: DIRECTOR, BUREAU OF DEVELOPMENT

5-8-2020 PLAN DATE
R-28-J SHEET 2 OF 7

MAXIMUM LANDING SLOPE IS 2.0% IN EACH DIRECTION OF TRAVEL. LANDING MINIMUM DIMENSIONS 5' x 5'. SEE NOTES.

MAXIMUM RAMP CROSS SLOPE IS 2.0%. RUNNING SLOPE 5% - 7% (8.3% MAXIMUM). SEE NOTES.

CURB RAMP TYPE P
(PARALLEL RAMP)
DO NOT USE IN AREAS WHERE PONDING MAY OCCUR

CURB RAMP TYPE C
(COMBINATION RAMP)

CURB RAMP TYPE M
(MEDIAN ISLAND)

MICHIGAN DEPARTMENT OF TRANSPORTATION
BUREAU OF DEVELOPMENT STANDARD PLAN FOR

CURB RAMP AND DETECTABLE WARNING DETAILS

APPROVED BY: DIRECTOR, BUREAU OF DEVELOPMENT

5-8-2020 PLAN DATE
R-28-J SHEET 3 OF 7

MAXIMUM LANDING SLOPE IS 2.0% IN EACH DIRECTION OF TRAVEL. LANDING MINIMUM DIMENSIONS 5' x 5'. SEE NOTES.

MAXIMUM RAMP CROSS SLOPE IS 2.0%. RUNNING SLOPE 5% - 7% (8.3% MAXIMUM). SEE NOTES.

CURB RAMP TYPE D
(DEPRESSED CORNER)

CURB RAMP TYPE D
(TANGENT DETECTABLE WARNING SHOWN)

MICHIGAN DEPARTMENT OF TRANSPORTATION
BUREAU OF DEVELOPMENT STANDARD PLAN FOR

CURB RAMP AND DETECTABLE WARNING DETAILS

APPROVED BY: DIRECTOR, BUREAU OF DEVELOPMENT

5-8-2020 PLAN DATE
R-28-J SHEET 4 OF 7

THE DETECTABLE WARNING SURFACE SHALL BE LOCATED SO THAT THE EDGE NEAREST THE RAIL CROSSING IS 6' MINIMUM AND 15' MAXIMUM FROM THE CENTERLINE OF THE NEAREST RAIL. DO NOT PLACE DETECTABLE WARNING ON RAILROAD CROSSING MATERIAL.

DETECTABLE WARNING AT RAILROAD CROSSING

DETECTABLE WARNING AT FLUSH SHOULDER OR ROADWAY

MICHIGAN DEPARTMENT OF TRANSPORTATION
BUREAU OF DEVELOPMENT STANDARD PLAN FOR

CURB RAMP AND DETECTABLE WARNING DETAILS

APPROVED BY: DIRECTOR, BUREAU OF DEVELOPMENT

5-8-2020 PLAN DATE
R-28-J SHEET 5 OF 7

5.0% MAX. RUNNING SLOPE BEYOND BOTTOM GRADE BREAK. SEE SECTION B-B

WHERE EITHER END OF THE BOTTOM GRADE BREAK IS MORE THAN 5' FROM THE BACK OF CURB, THE DETECTABLE WARNING SHALL BE LOCATED AT THE BACK OF CURB. (DOME ORIENTATION IS NOT SIGNIFICANT ON RADII.)

CURB RAMP LOCATED IN RADIUS (TYPE B SHOWN) (GRADE BREAK OFFSET GREATER THAN 5')

CURB RAMP PERPENDICULAR TO RADIAL CURB (TYPE F SHOWN) (USE WITH RADIAL CURB WHEN THE CROSSWALK AND CURB RAMP ARE NOT ALLOWED)

WHERE BOTH ENDS OF THE BOTTOM GRADE BREAK ARE WITHIN 5' OF THE BACK OF CURB, THE DETECTABLE WARNING SHALL BE LOCATED ON THE RAMP SURFACE AT THE BOTTOM GRADE BREAK.

CURB RAMP PERPENDICULAR TO TANGENT CURB (TYPE F AND TYPE RF SHOWN)

CURB RAMP LOCATED IN RADIUS (TYPE B SHOWN) (GRADE BREAK OFFSET LESS THAN 5')

GRADE BREAKS AT THE TOP AND BOTTOM OF CURB RAMPS SHALL BE PERPENDICULAR TO THE DIRECTION OF TRAVEL.

TRANSITION ADJACENT GUTTER PAN CROSS SECTION TO PROVIDE 5.0% MAXIMUM COUNTER SLOPE ACROSS THE RAMP OPENING.

APPROACH AREA SHALL END FLUSH WITH BACK OF CURB.

24" DETECTABLE WARNING, EXTENDING THE WIDTH OF THE RAMP.

SECTION B-B
CURB RAMP ORIENTATION

MICHIGAN DEPARTMENT OF TRANSPORTATION
BUREAU OF DEVELOPMENT STANDARD PLAN FOR

CURB RAMP AND DETECTABLE WARNING DETAILS

APPROVED BY: DIRECTOR, BUREAU OF DEVELOPMENT

5-8-2020 PLAN DATE
R-28-J SHEET 6 OF 7

50% TO 65% OF BASE

1.6" - 2.4"

1.6" MIN.

0.65" MIN.

0.3" TO 1.4"

ALIGNED IN DIRECTION OF TRAVEL AND PERPENDICULAR (OR RADIAL) TO GRADE BREAK

DETECTABLE WARNING DETAILS

NOTES:

DETAILS SPECIFIED ON THIS PLAN APPLY TO ALL CONSTRUCTION, RECONSTRUCTION, OR ALTERATION OF STREETS, CURBS, OR SIDEWALKS IN THE PUBLIC RIGHT OF WAY.

CURB RAMPS ARE TO BE LOCATED AS SPECIFIED ON THE PLANS OR AS DIRECTED BY THE ENGINEER.

RAMPS SHALL BE PROVIDED AT ALL CORNERS OF AN INTERSECTION WHERE THERE IS EXISTING OR PROPOSED SIDEWALK AND CURB. RAMPS SHALL ALSO BE PROVIDED AT MARKED AND/OR SIGNALIZED WID-BLOCK CROSSINGS.

SURFACE TEXTURE OF THE RAMP SHALL BE THAT OBTAINED BY A COARSE BROWNING, TRANSVERSE TO THE RUNNING SLOPE.

SIDEWALK SHALL BE RAMPED WHERE THE DRIVEWAY CURB IS EXTENDED ACROSS THE WALK.

CARE SHALL BE TAKEN TO ASSURE A UNIFORM GRADE ON THE RAMP, WHERE CONDITIONS PERMIT. IT IS DESIRABLE THAT THE SLOPE OF THE RAMP BE IN ONLY ONE DIRECTION, PARALLEL TO THE DIRECTION OF TRAVEL.

RAMPS SHALL BE INCREASED, IF NECESSARY, TO ACCOMMODATE SIDEWALK SNOW REMOVAL EQUIPMENT NORMALLY USED BY THE MUNICIPALITY.

WHEN 5' MINIMUM WIDTHS ARE NOT PRACTICABLE, RAMP WIDTH MAY BE REDUCED TO NOT LESS THAN 4' AND LANDINGS TO NOT LESS THAN 4' x 4'.

CURB RAMPS WITH A RUNNING SLOPE ≤ 5% DO NOT REQUIRE A TOP LANDING. HOWEVER, ANY CONTIGUOUS SIDEWALK OR PEDESTRIAN ROUTE CROSSING THROUGH OR INTERSECTING THE CURB RAMP MUST INDEPENDENTLY MAINTAIN A CROSS SLOPE NOT GREATER THAN 2% PERPENDICULAR TO ITS OWN DIRECTION(S) OF TRAVEL.

DETECTABLE WARNING SURFACE COVERAGE IS 24" MINIMUM IN THE DIRECTION OF RAMP/PATH TRAVEL AND THE FULL WIDTH OF THE RAMP/PATH OPENING EXCLUDING CURBED OR FLARED CURB TRANSITION AREAS. A BORDER OFFSET NOT GREATER THAN 2" MEASURED ALONG THE EDGES OF THE DETECTABLE WARNING IS ALLOWABLE. FOR RADIAL CURB THE OFFSET IS MEASURED FROM THE ENDS OF THE RADII.

FOR NEW ROADWAY CONSTRUCTION, THE RAMP CROSS SLOPE MAY NOT EXCEED 2.0%. FOR ALTERATIONS TO EXISTING ROADWAYS, THE CROSS SLOPE MAY BE TRANSITIONED TO MEET AN EXISTING ROADWAY GRADE. THE CROSS SLOPE TRANSITION SHALL BE APPLIED UNIFORMLY OVER THE FULL LENGTH OF THE RAMP.

THE MAXIMUM RUNNING SLOPE OF 8.3% IS RELATIVE TO A FLAT 100% REFERENCE. HOWEVER, IT SHALL NOT REQUIRE ANY RAMP OR SERIES OF RAMPS TO EXCEED 15 FEET IN LENGTH NOT INCLUDING LANDINGS OR TRANSITIONS.

DRAINAGE STRUCTURES SHOULD NOT BE PLACED IN LINE WITH RAMPS. THE LOCATION OF THE RAMP SHOULD TAKE PRECEDENCE OVER THE LOCATION OF THE DRAINAGE STRUCTURE. WHERE EXISTING DRAINAGE STRUCTURES ARE LOCATED IN THE RAMP PATH OF TRAVEL, USE A MANUFACTURER'S ADA COMPLIANT GRATE. OPENINGS SHALL NOT BE GREATER THAN 1/2". ELONGATED OPENINGS SHALL BE PLACED SO THAT THE LONG DIMENSION IS PERPENDICULAR TO THE DOMINANT DIRECTION OF TRAVEL.

THE TOP OF THE JOINT FILLER FOR ALL RAMP TYPES SHALL BE FLUSH WITH THE ADJACENT CONCRETE.

CROSSWALK AND STOP LINE MARKINGS, IF USED, SHALL BE SO LOCATED AS TO STOP TRAFFIC SHORT OF RAMP CROSSINGS. SPECIFIC DETAILS FOR MARKING APPLICATIONS ARE GIVEN IN THE "MICHIGAN MANUAL ON UNIFORM TRAFFIC CONTROL DEVICES".

FLARED SIDES WITH A SLOPE OF 10% MAXIMUM, MEASURED ALONG THE ROADSIDE CURB LINE, SHALL BE PROVIDED WHERE AN UNSTRUCTURED CIRCULATION PATH LATERALLY CROSSES THE CURB RAMP. FLARED SIDES ARE NOT REQUIRED WHERE THE RAMP IS BORDERED BY LANDSCAPING, UNPAVED SURFACE OR PERMANENTLY FIXED OBJECTS. WHERE THEY ARE NOT REQUIRED, FLARED SIDES CAN BE CONSIDERED IN ORDER TO AVOID SHARP CURB RETURNS AT RAMP OPENINGS.











DETECTABLE WARNING PLATES MUST BE INSTALLED USING FABRICATED OR FIELD CUT UNITS CAST AND/OR ANCHORED IN THE PAVEMENT TO RESIST SHIFTING OR HEAVING.

MICHIGAN DEPARTMENT OF TRANSPORTATION
BUREAU OF DEVELOPMENT STANDARD PLAN FOR

CURB RAMP AND DETECTABLE WARNING DETAILS

APPROVED BY: DIRECTOR, BUREAU OF DEVELOPMENT

5-8-2020 PLAN DATE
R-28-J SHEET 7 OF 7

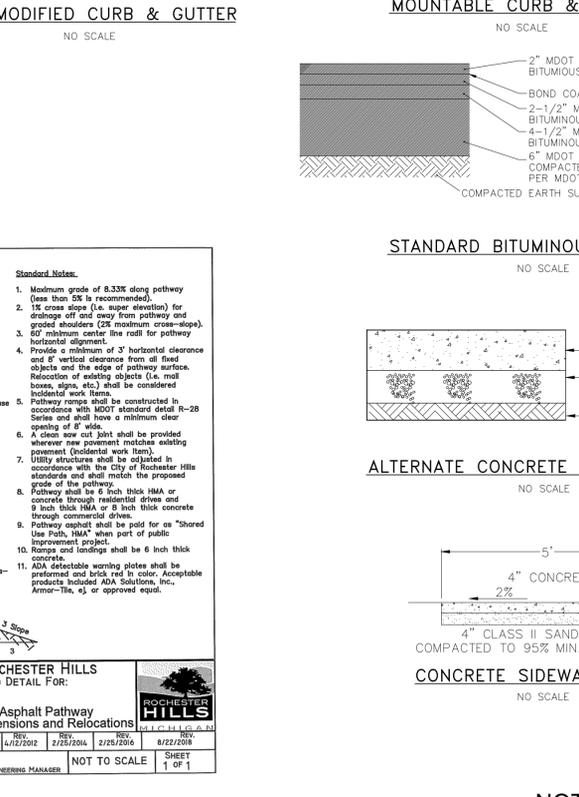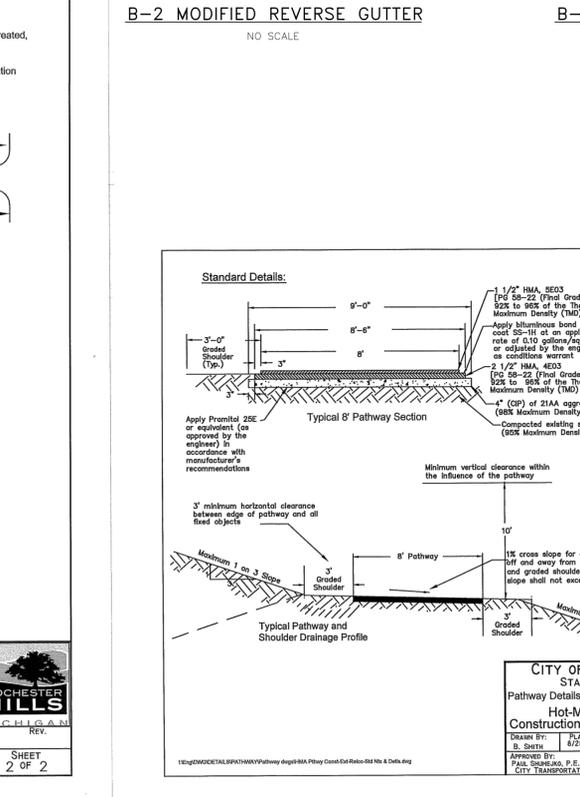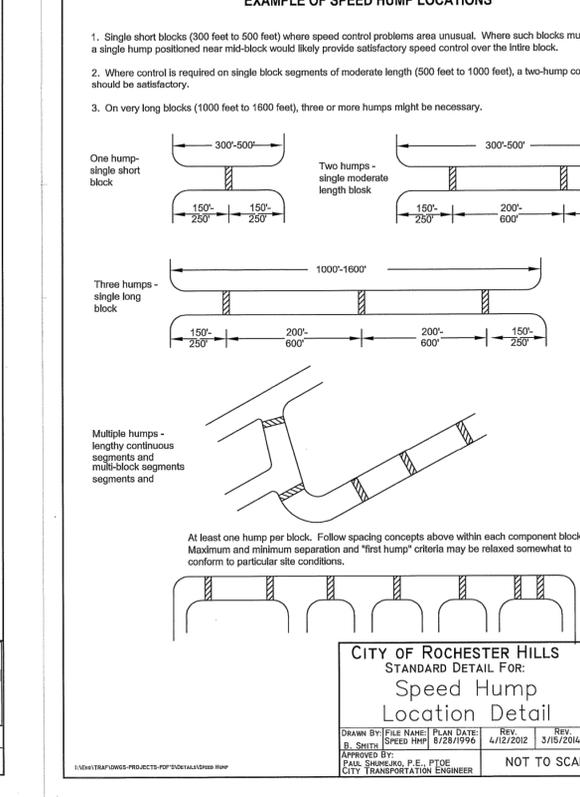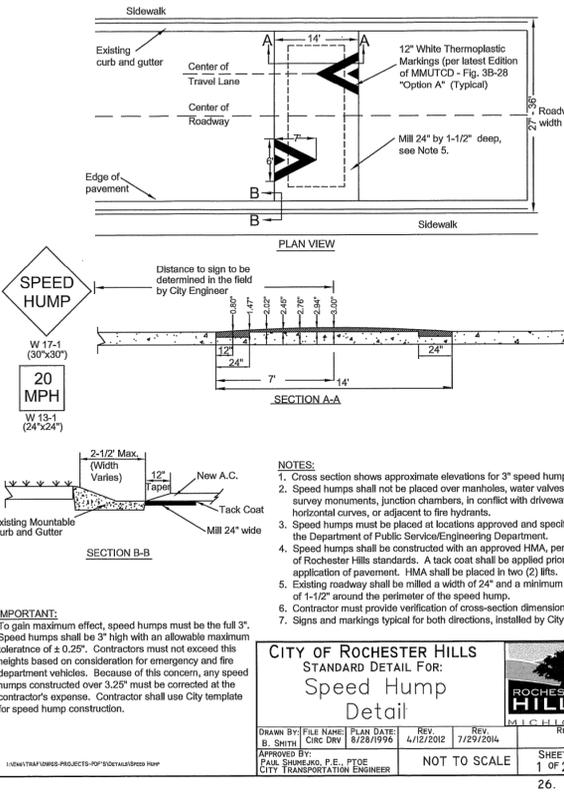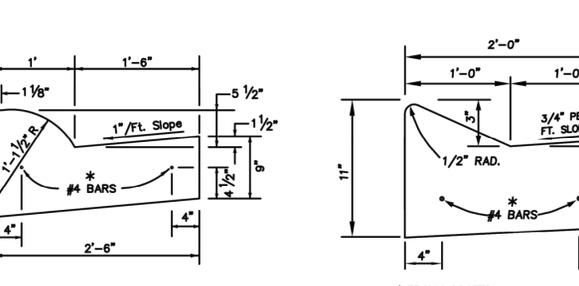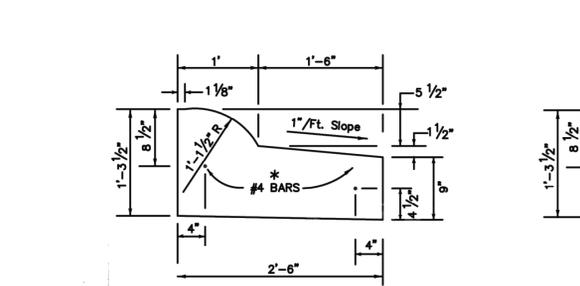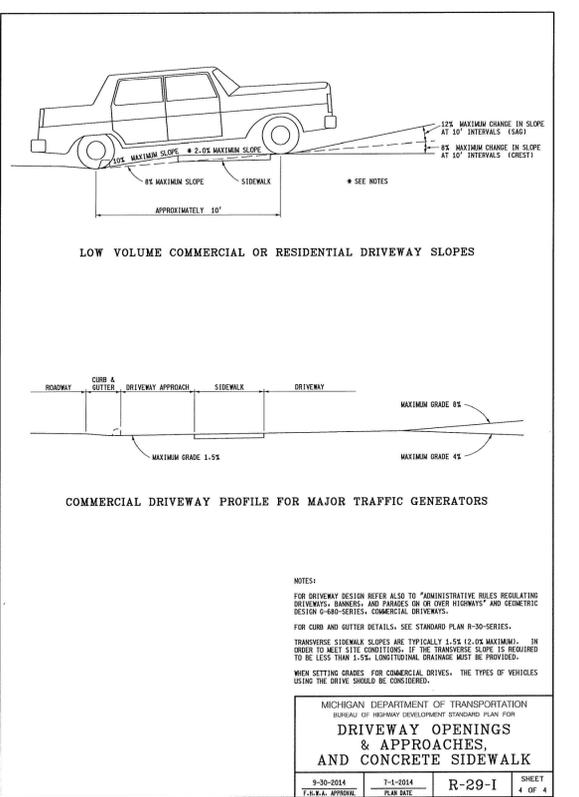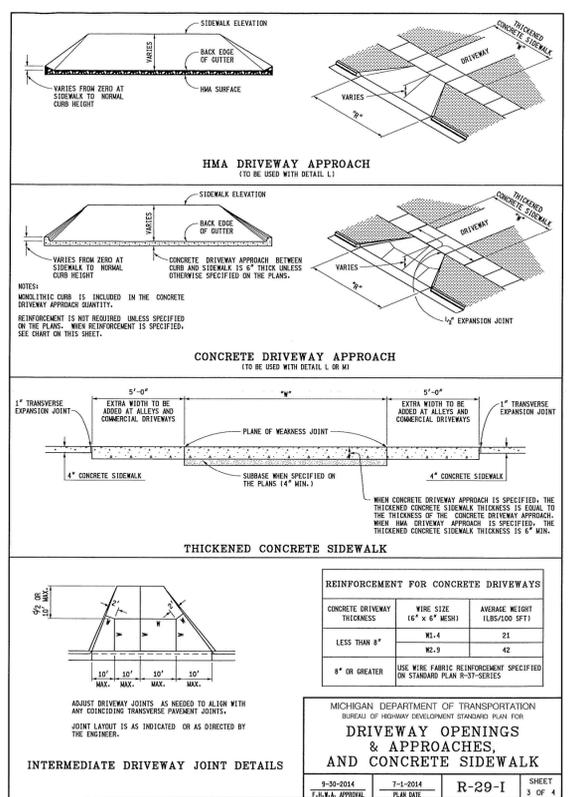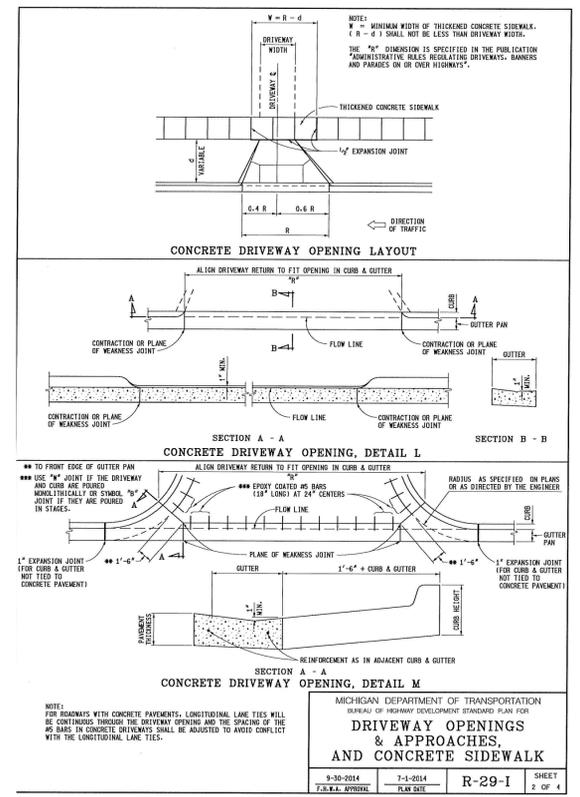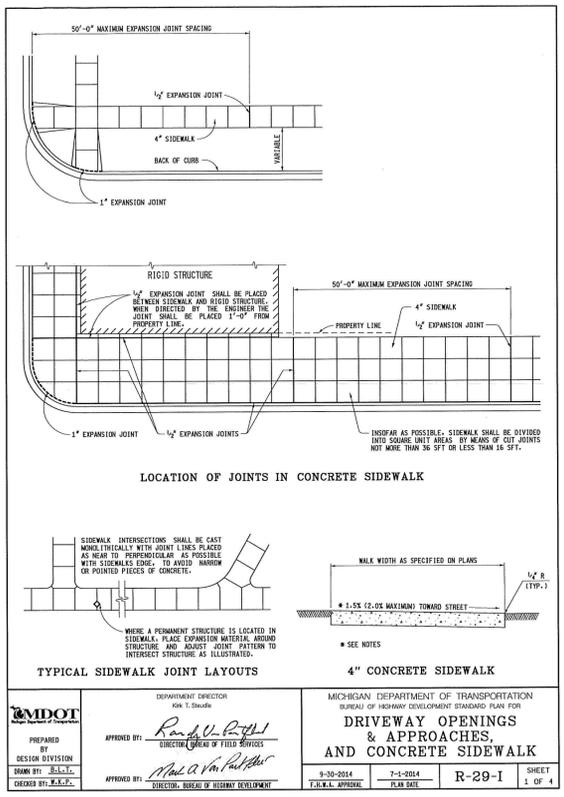

811
 Know what's below.
 Call before you dig.

THE LOCATIONS OF EXISTING UNDERGROUND UTILITIES ARE SHOWN IN AN APPROXIMATE WAY ONLY AND HAVE NOT BEEN INDEPENDENTLY VERIFIED BY THE OWNER OR ITS REPRESENTATIVE. THE CONTRACTOR SHALL DETERMINE THE EXACT LOCATION OF ALL EXISTING UTILITIES BEFORE COMMENCING WORK, AND AGREES TO BE FULLY RESPONSIBLE FOR ANY OCCASIONAL BY THE CONTRACTOR'S FAILURE TO EXACTLY LOCATE AND PRESERVE ANY AND ALL UNDERGROUND UTILITIES.

NOTICE: CONSTRUCTION SITE SAFETY IS THE SOLE RESPONSIBILITY OF THE CONTRACTOR. NEITHER THE OWNER NOR THE ENGINEER SHALL BE RESPONSIBLE FOR SAFETY OF THE WORK OF PERSONS ENGAGED IN THE WORK OF ANY NEARBY STRUCTURES, OR OF ANY OTHER PERSONS.

COPYRIGHT © 2021 ATWELL, LLC. NO REPRODUCTION SHALL BE MADE WITHOUT THE PRIOR WRITTEN CONSENT OF ATWELL, LLC.

ATWELL
 866.850.4200 www.atwell-group.com
 TWO TOWNE SQUARE, SUITE 700
 SOUTHFIELD, MI 48076
 248.447.2600

SECTION 22
 TOWN 3 NORTH, RANGE 11 EAST
 CITY OF ROCHESTER HILLS
 OAKLAND COUNTY, MICHIGAN

M2J, LLC
 CAMDEN CROSSING
 PRELIMINARY SITE PLAN
 DETAIL SHEET

DATE: AUG. 16, 2019
 2020-06-15 PER CITY
 2021-01-21 PER CITY
 2021-07-02 PER CITY
 2021-08-23 PER CITY

REVISIONS
 NA NA NA
 N/A

DRAWN BY: KS
 CHECKED BY: JA
 P.M.: JACKERMAN
 JOB #: 18001982
 FILE CODE: -
 SHEET NO: C-08

CITY FILE #19-031
 SECTION #22

NOT FOR CONSTRUCTION