

**2015 MICHIGAN UNIFORM ENERGY CODE RULES
PART 10 WITH ANSI/ASHRAE/IESNA STANDARD
90.1-2013, Section 9.4.1.4.**

CITY FILE #: 17-048

Statistics							
Description	Symbol	Avg	Max	Min	Max/Min	Avg/Min	Avg/Max
East Property Line @ 5' AFG	+	0.4 fc	1.0 fc	0.0 fc	N/A	N/A	0.4:1
North Property Line @ 5' AFG	+	0.3 fc	0.4 fc	0.1 fc	4.0:1	3.0:1	0.8:1
Parking Area	✖	1.3 fc	2.6 fc	0.4 fc	6.5:1	3.3:1	0.5:1
Sidewalk	✖	0.9 fc	6.9 fc	0.2 fc	34.5:1	4.5:1	0.1:1
South Property Line @ 5' AFG	+	0.5 fc	1.0 fc	0.1 fc	10.0:1	5.0:1	0.5:1
West Property Line @ 5' AFG	+	0.4 fc	1.0 fc	0.0 fc	N/A	N/A	0.4:1

GENERAL NOTE

1. SEE SCHEDULE FOR LUMINAIRE MOUNTING HEIGHT.
 2. SEE LUMINAIRE SCHEDULE FOR LIGHT LOSS FACTOR.
 3. CALCULATIONS ARE SHOWN IN FOOTCANDLES AT GRADE.

THE ENGINEER AND/OR ARCHITECT MUST DETERMINE APPLICABILITY OF THE LAYOUT TO EXISTING / FUTURE FIELD CONDITIONS. THIS LIGHTING LAYOUT REPRESENTS ILLUMINATION LEVELS CALCULATED FROM LABORATORY DATA TAKEN UNDER CONTROLLED CONDITIONS IN ACCORDANCE WITH ILLUMINATING ENGINEERING SOCIETY APPROVED METHODS. ACTUAL PERFORMANCE OF ANY MANUFACTURER'S LUMINAIRE MAY VARY DUE TO VARIATION IN ELECTRICAL VOLTAGE, TOLERANCE IN LAMPS, AND OTHER VARIABLE FIELD CONDITIONS. MOUNTING HEIGHTS INDICATED ARE FROM GRADE AND/OR FLOOR UP.

THESE LIGHTING CALCULATIONS ARE NOT A SUBSTITUTE FOR INDEPENDENT ENGINEERING ANALYSIS OF LIGHTING SYSTEM SUITABILITY AND SAFETY. THE ENGINEER AND/OR ARCHITECT IS RESPONSIBLE TO REVIEW FOR MICHIGAN ENERGY CODE AND LIGHTING QUALITY COMPLIANCE.

Plan View

1

Luminaire Schedule													
Symbol	Label	QTY	Manufacturer	Catalog Number	Description	Lamp	Number Lamps	Filename	Lumens per Lamp	LLF	Wattage	Mounting Height	
	A	5	Lithonia Lighting	DSX0 LED P4 40K TFTM MVOLT	DSX0 LED P4 40K TFTM MVOLT	LED	1	DSX0_LED_P4_40K_TFTM_MVOLT.ies	10558	0.9	92	20'-0"	
	B	3	Lithonia Lighting	DSXW1 LED 20C 530 40K T3S MVOLT	DSXW1 LED WITH (2) 10 LED LIGHT ENGINES, TYPE T3S OPTIC, 4000K, @ 530mA.	LED	1	DSXW1_LED_20C_530_40K_T3S_MVOLT.ies	4331	0.9	34.9	28'-0"	
	C	3	BEGA	22 263	RECESSED WALL MOUNT	LED	1	22263.IES	1127	0.9	21.4	3'-0"	
	D	4	BEGA	55 943	SEMI-RECESSED DOWNLIGHT WITH PARTIALLY FROSTED CRYSTAL GLASS	LED	1	55943.ies	871	0.9	22	13'-0"	


PROPOSED BUILDING FOR:
**South Boulevard
Office Development**

905 SOUTH BOULEVARD EAST
ROCHESTER HILLS, MICHIGAN

Issued dr/ch
1 SITE PLAN REVIEW
1 PER CITY REVIEW
11.17.17
01.12.18

Sheet title


SITE DETAILS

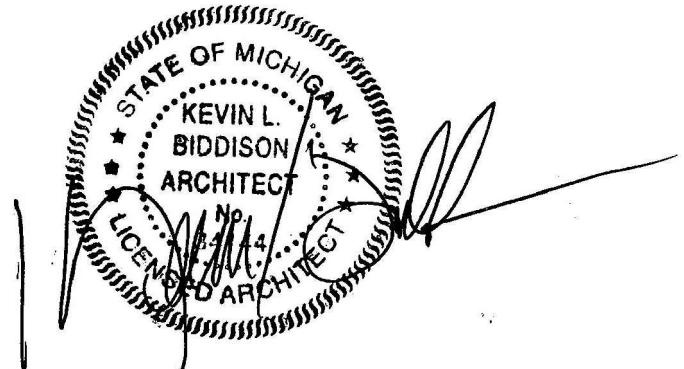


1999.17

Sheet no.


SP.401

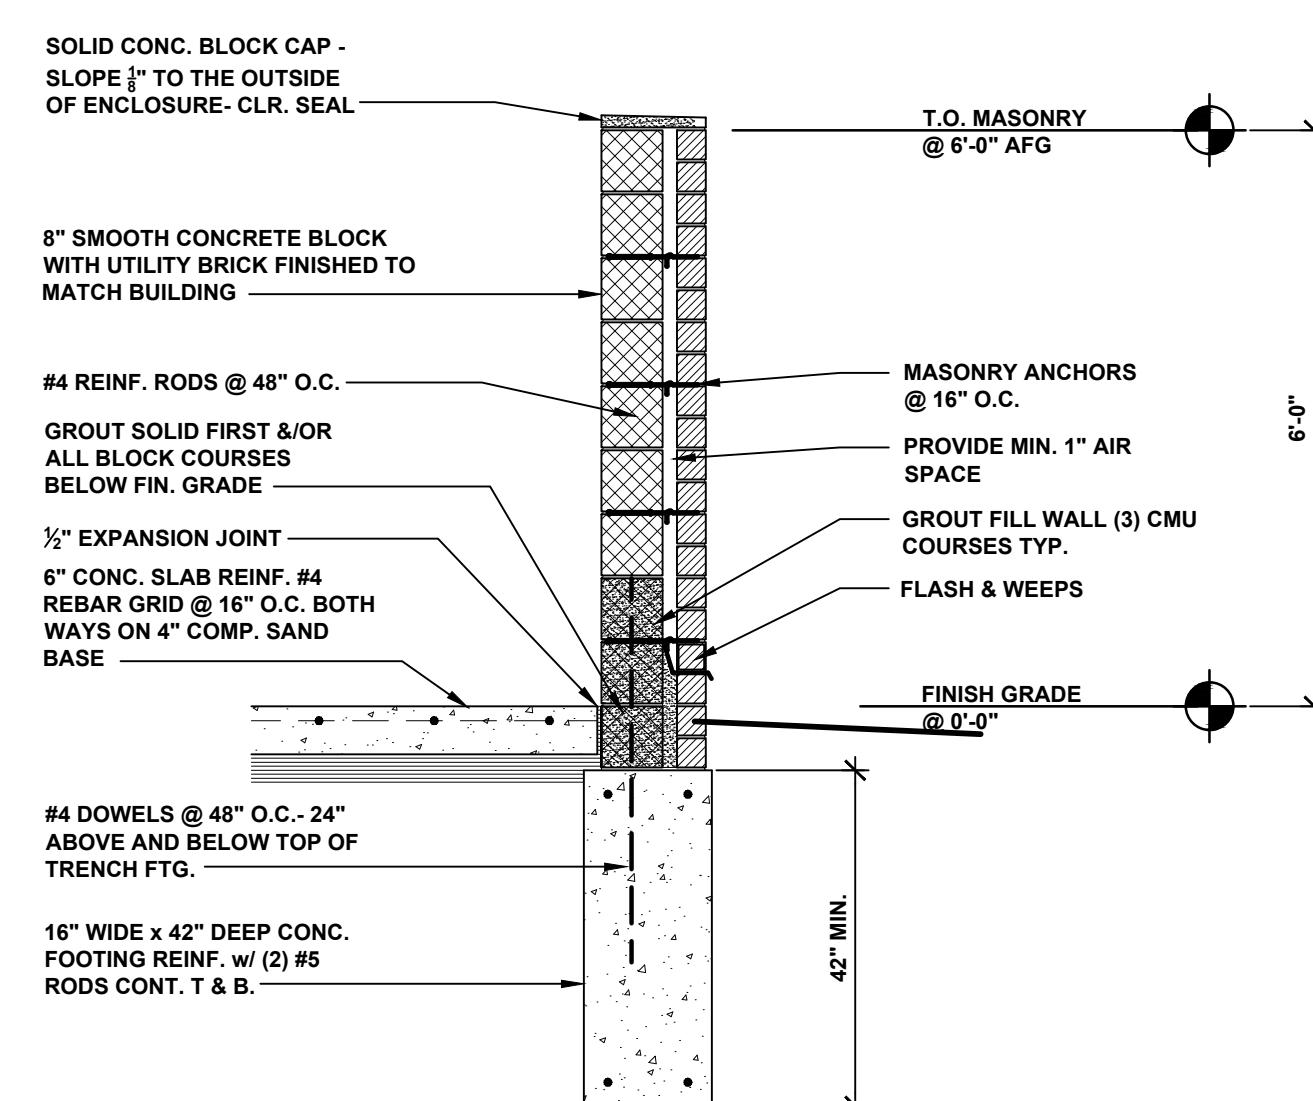

401.03
SP.401
ENCLOSURE WALL SECTION
SCALE: 1/2" = 1'-0"

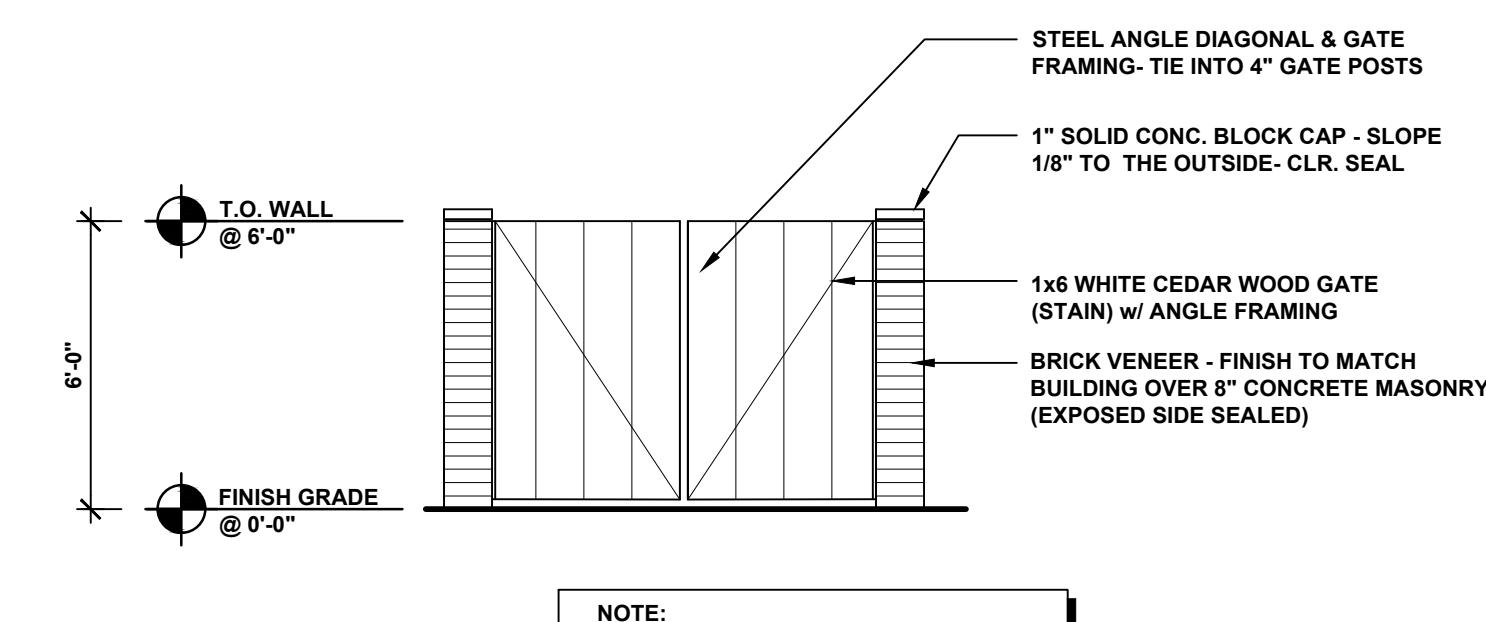

401.02
WASTE ENCLOSURE ELEVATION
SP.401
SCALE: 1/4"=1'-0"

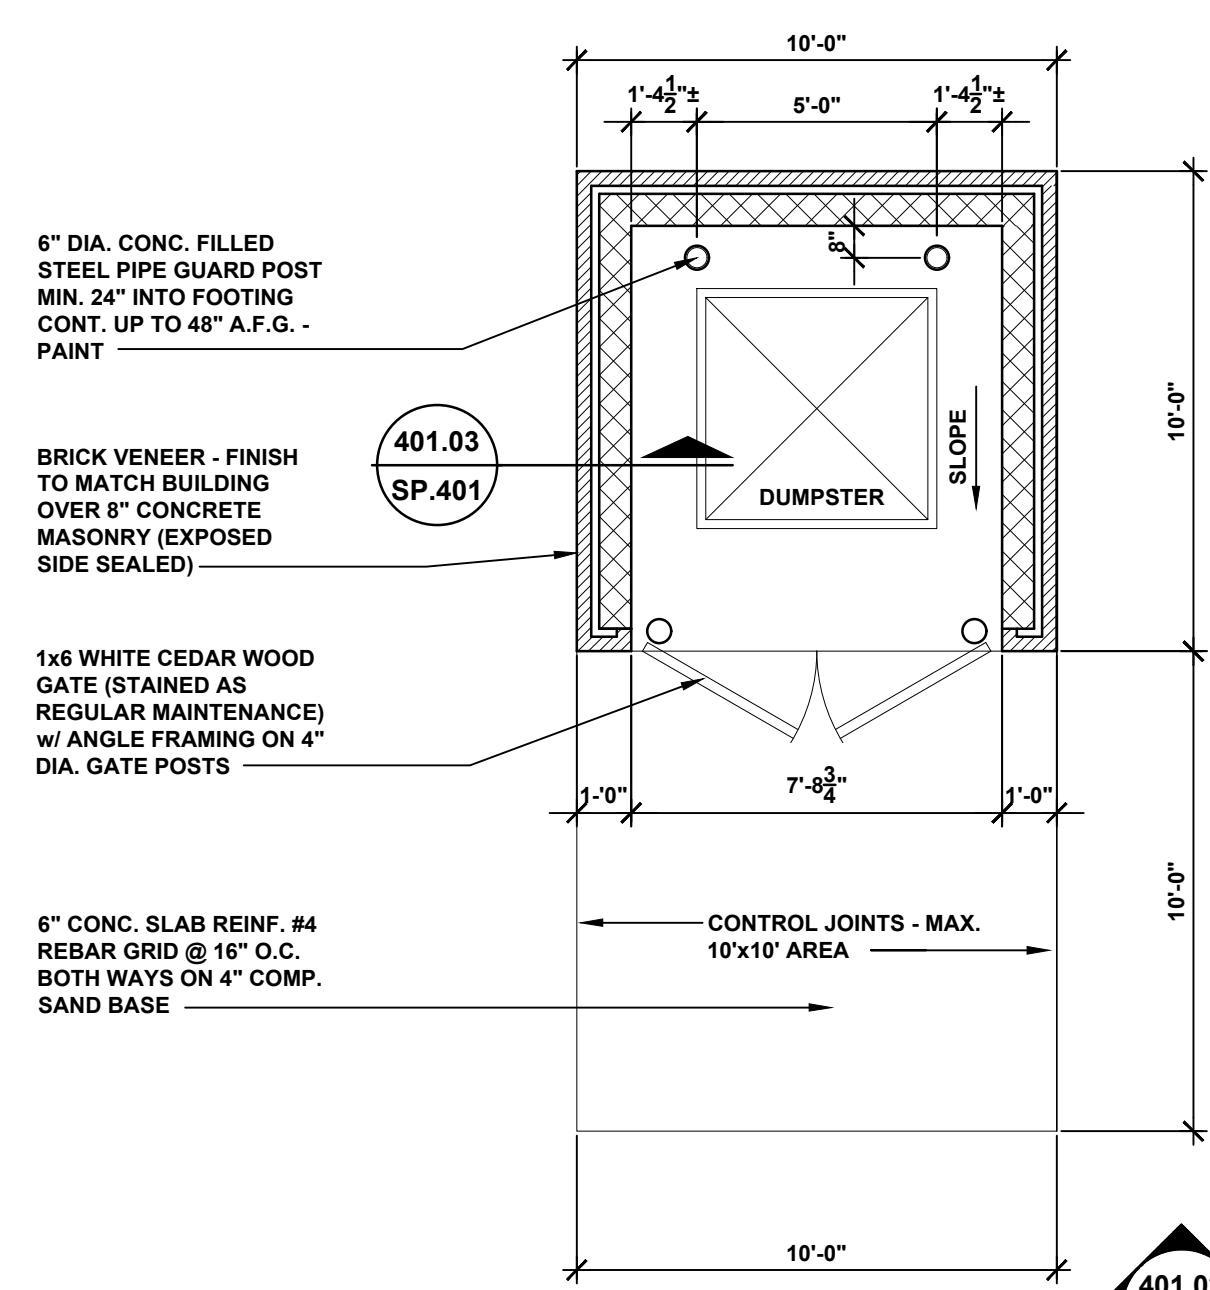

401.01
WASTE ENCLOSURE PLAN
SP.401
SCALE: 1/4"=1'-0"




CITY FILE # 17-048

Sheet no.

SP.401

Martin St. Suite 10
Birmingham, MI 48009
Phone: 248.554.9500

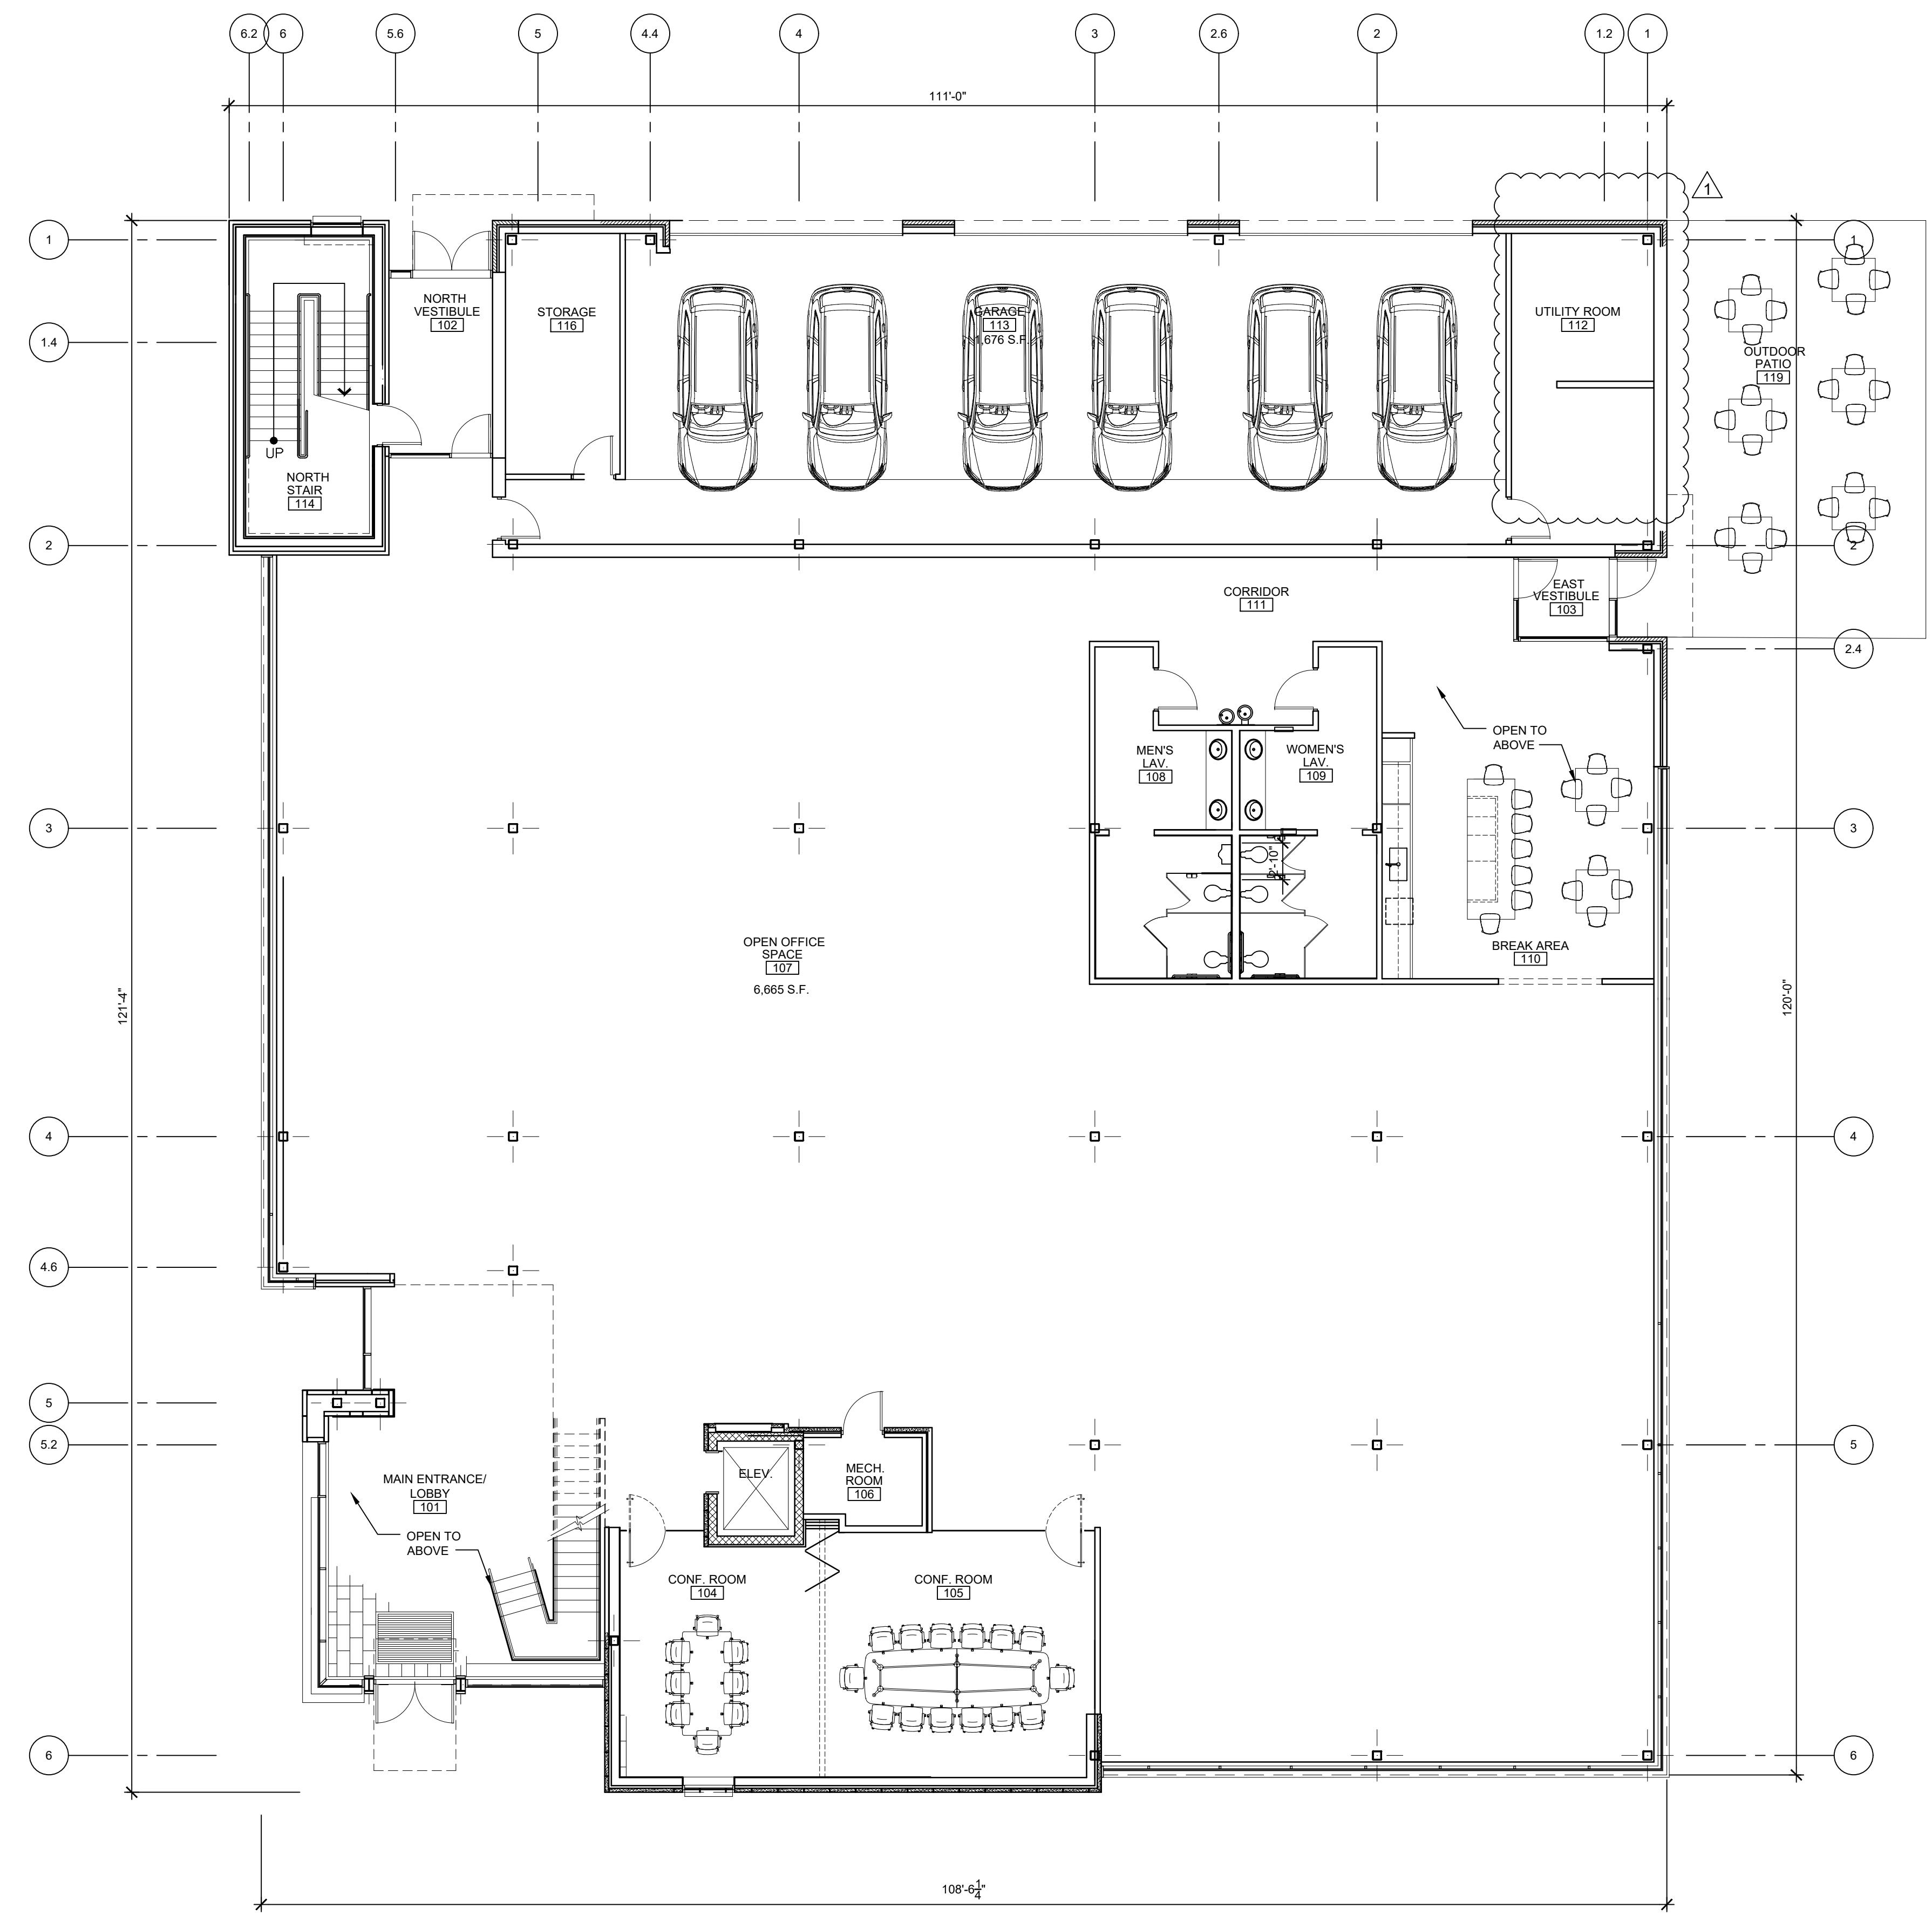

999.17

101




NORTH

1st FLOOR PLAN





SCALE: 1/8"=1'-0"

CITY FILE #: 17-048

Sheet no. _____

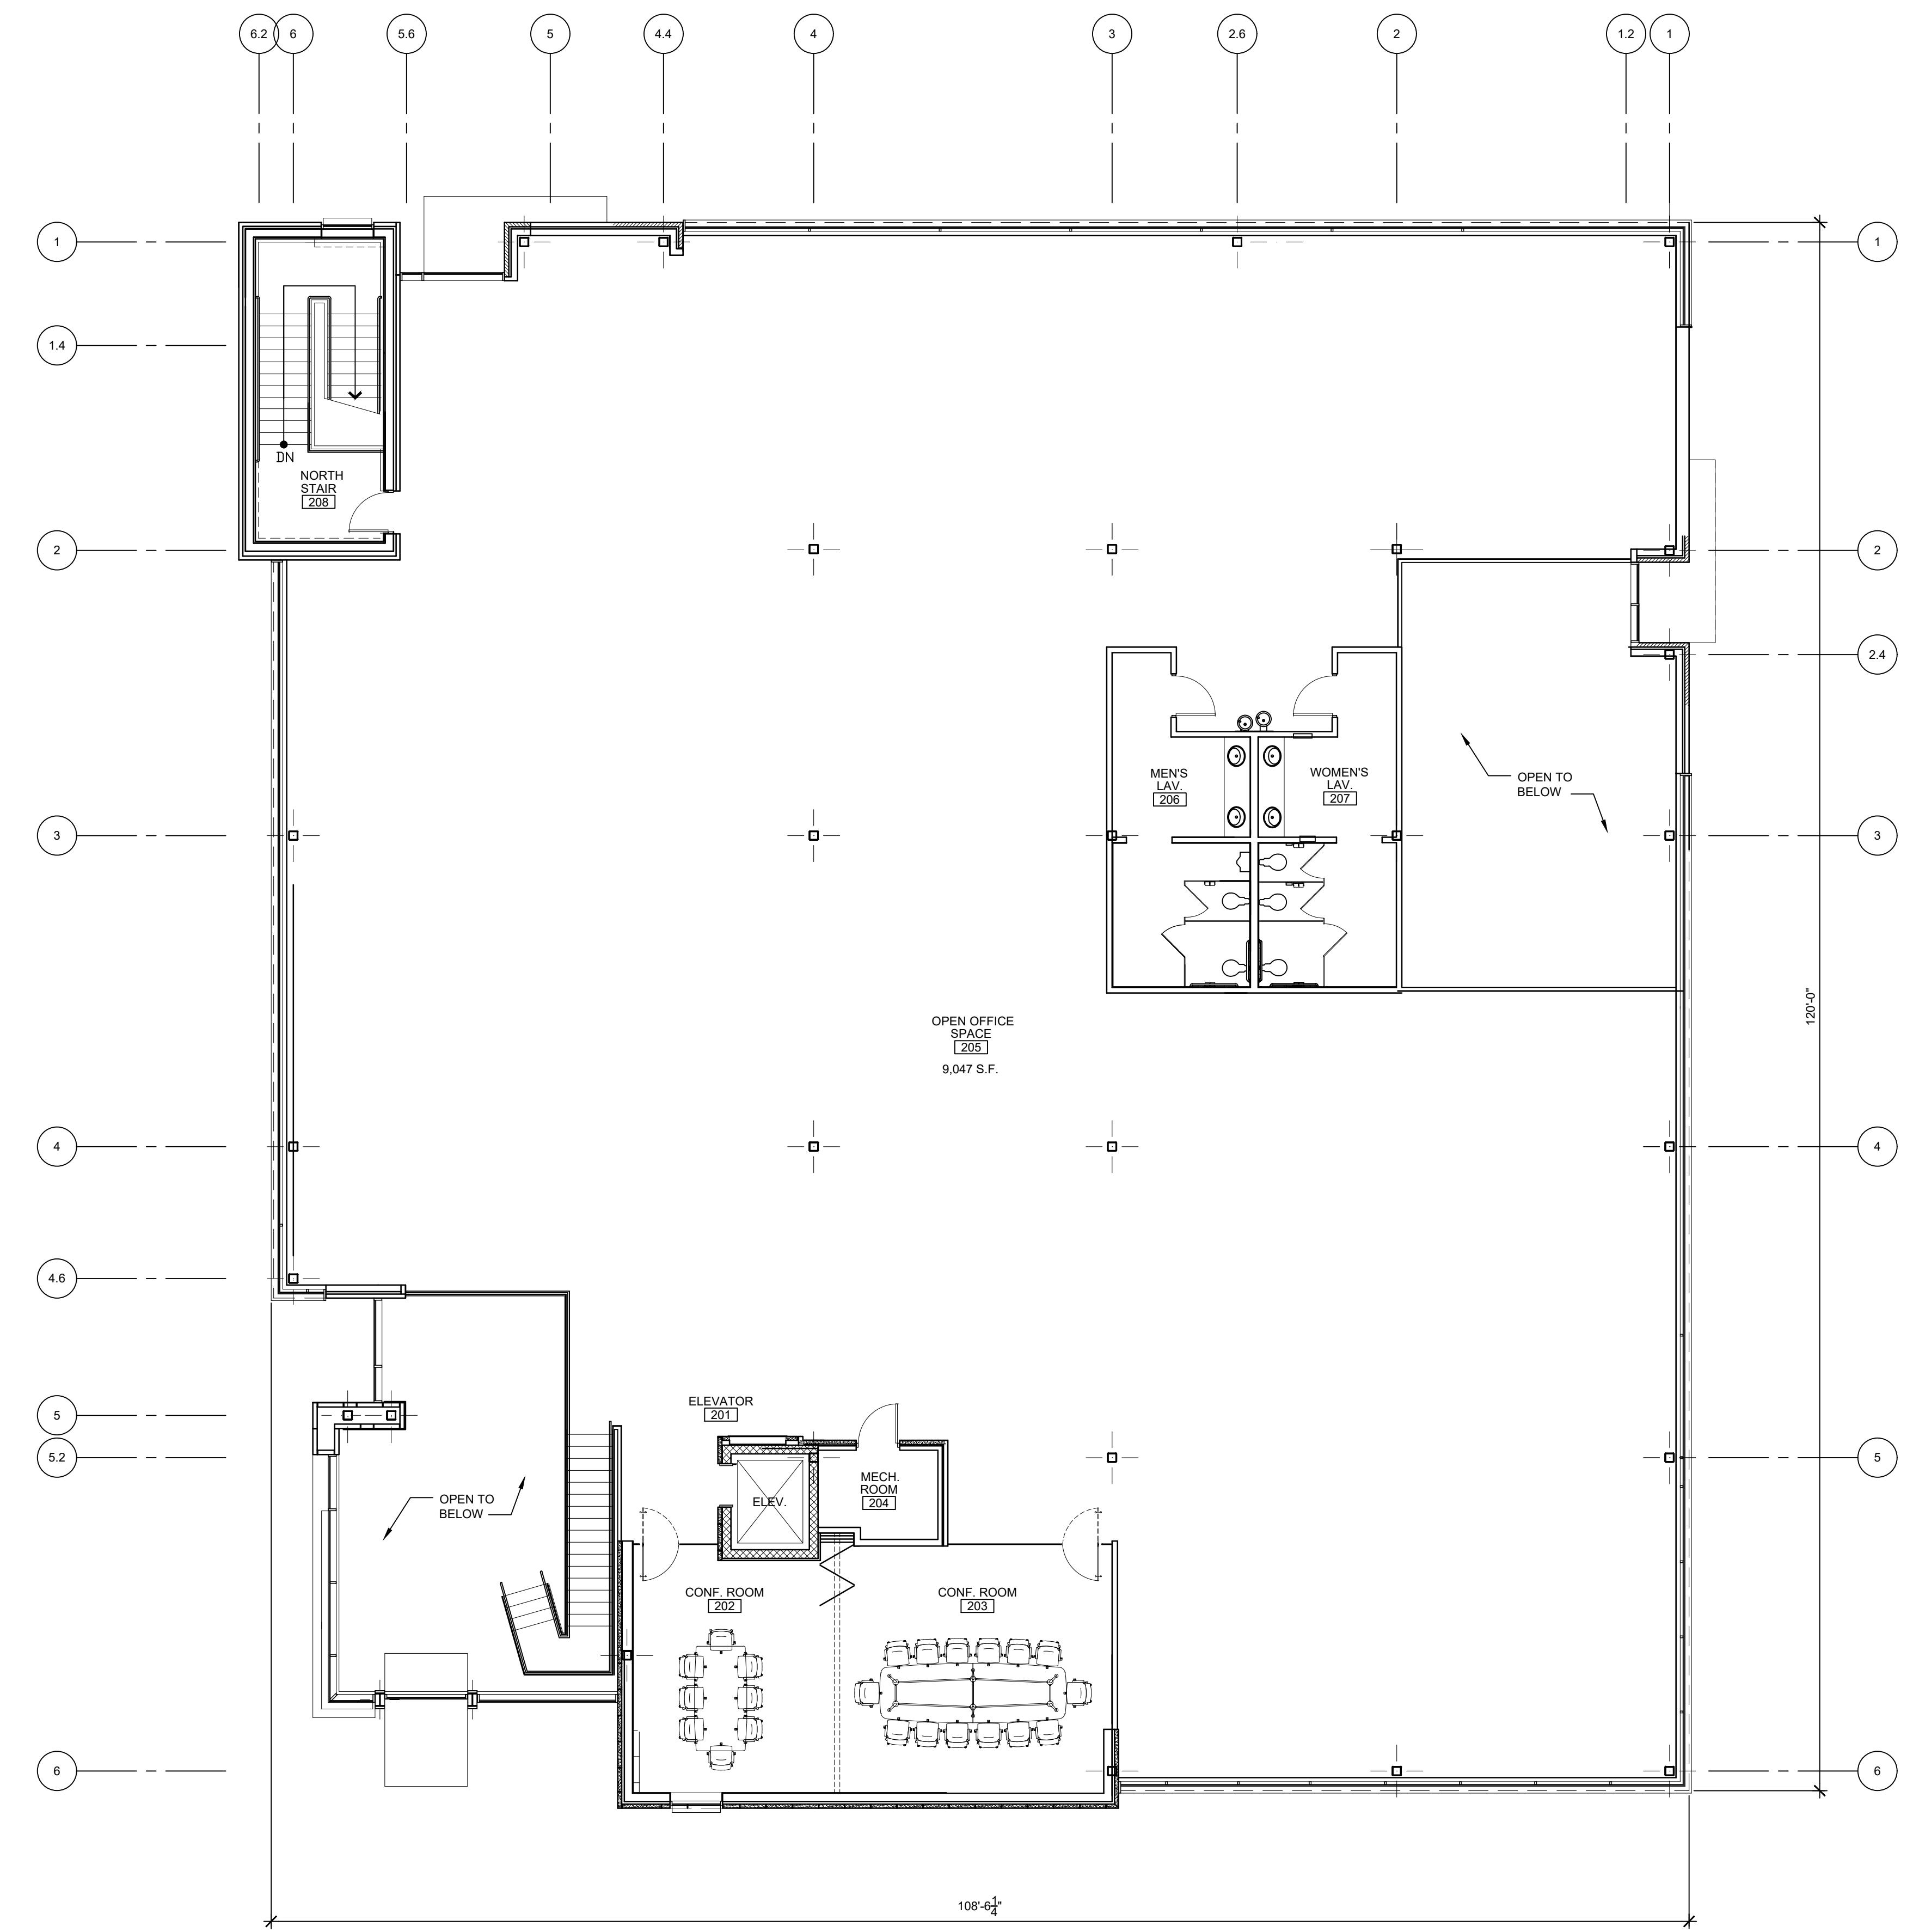

Consultants

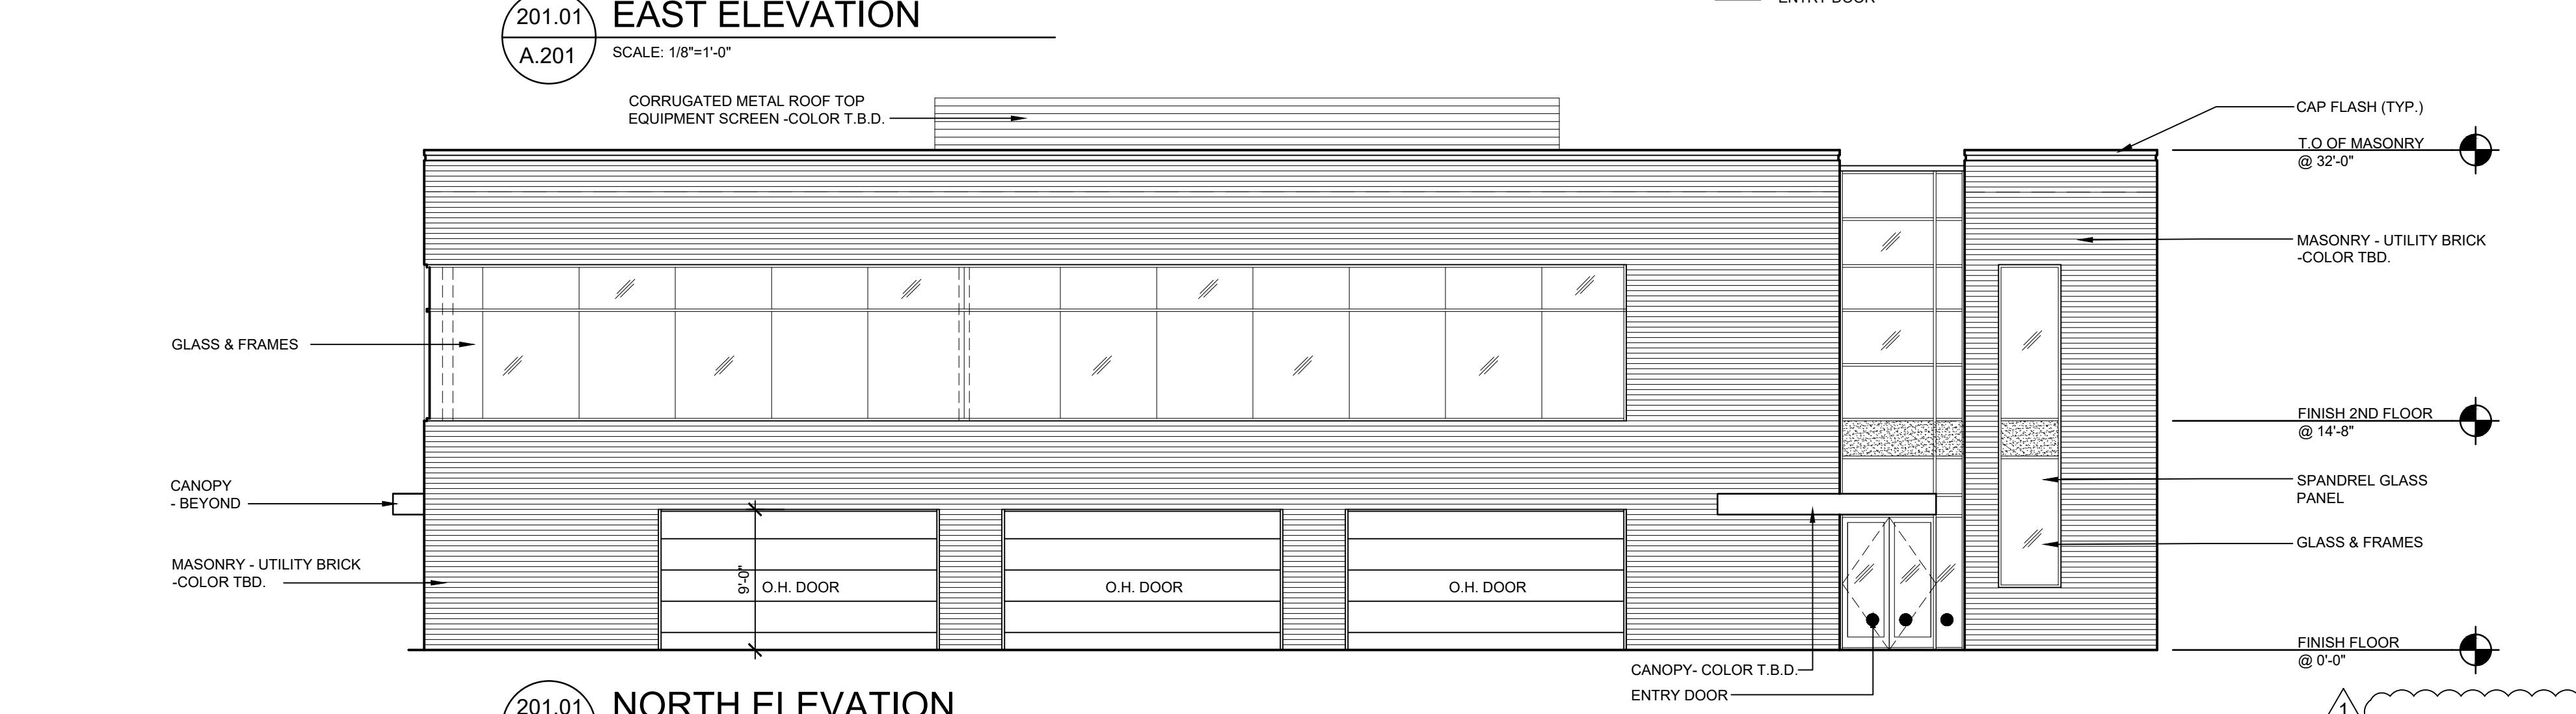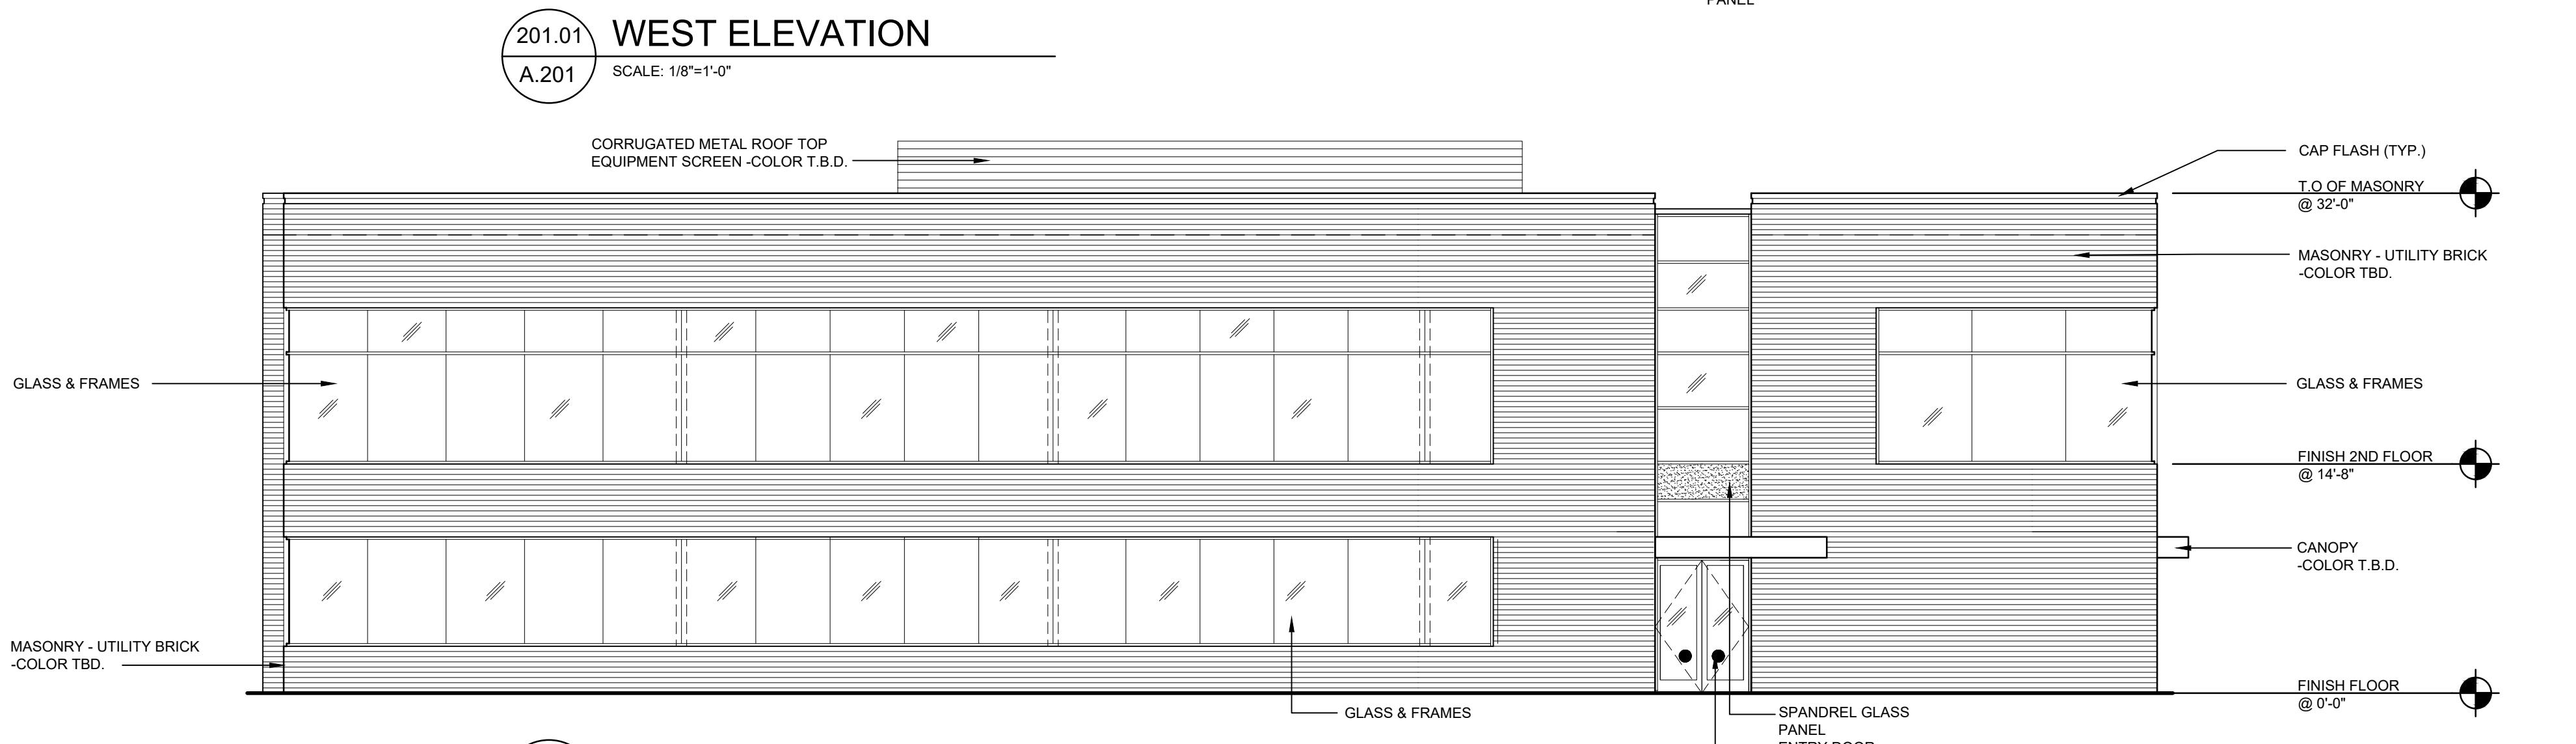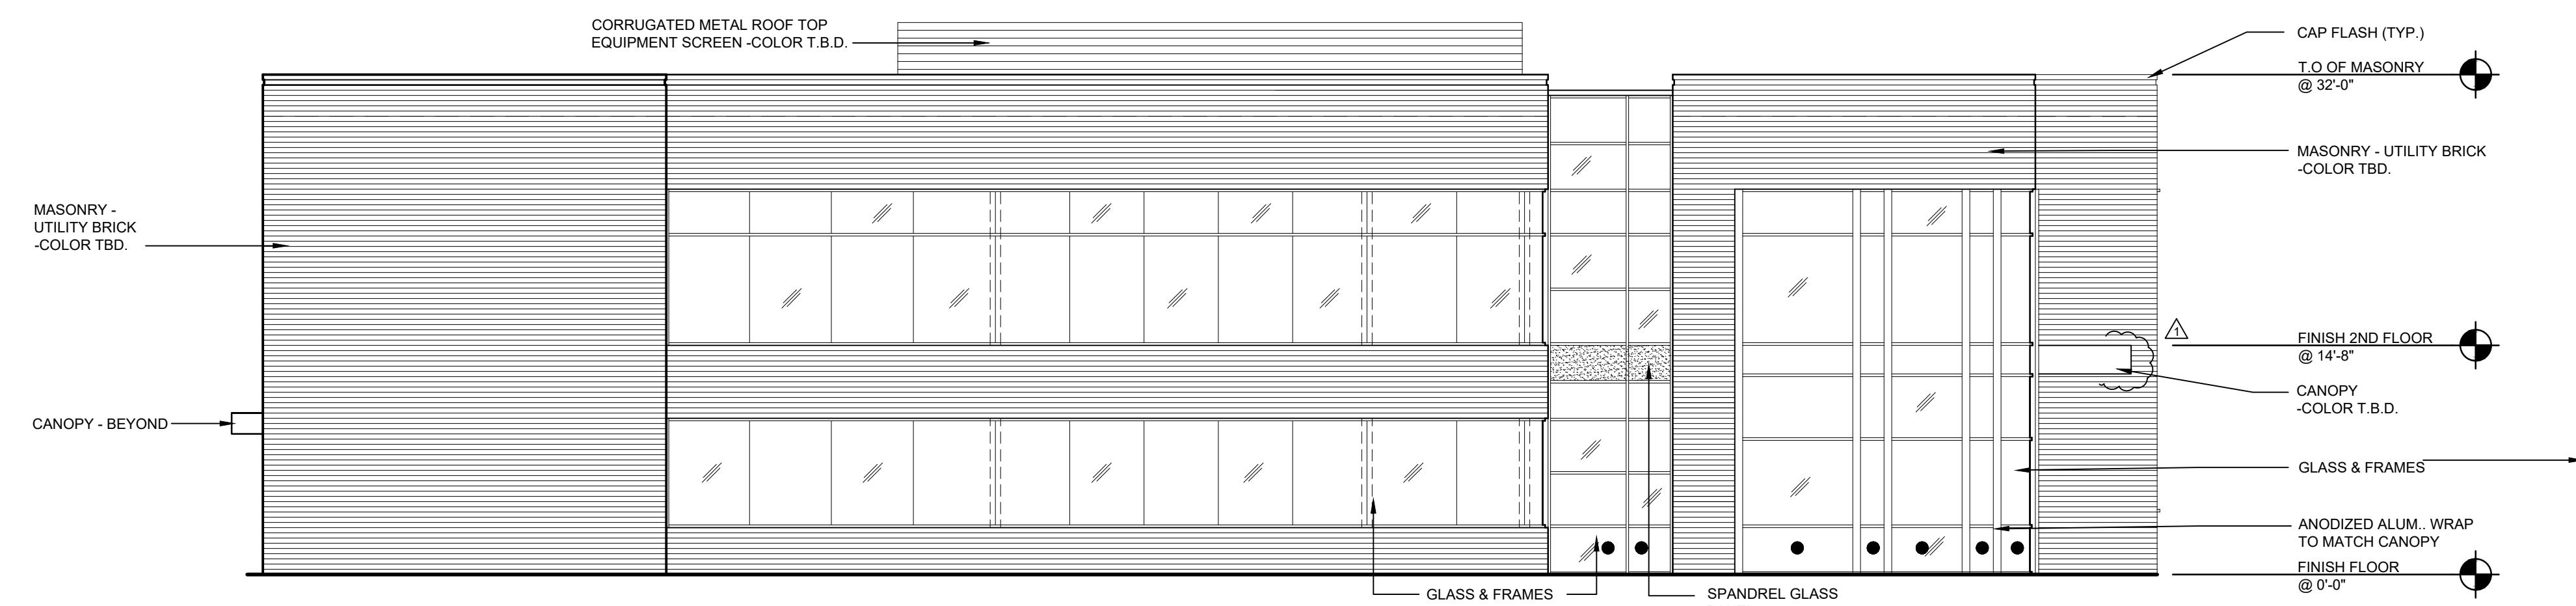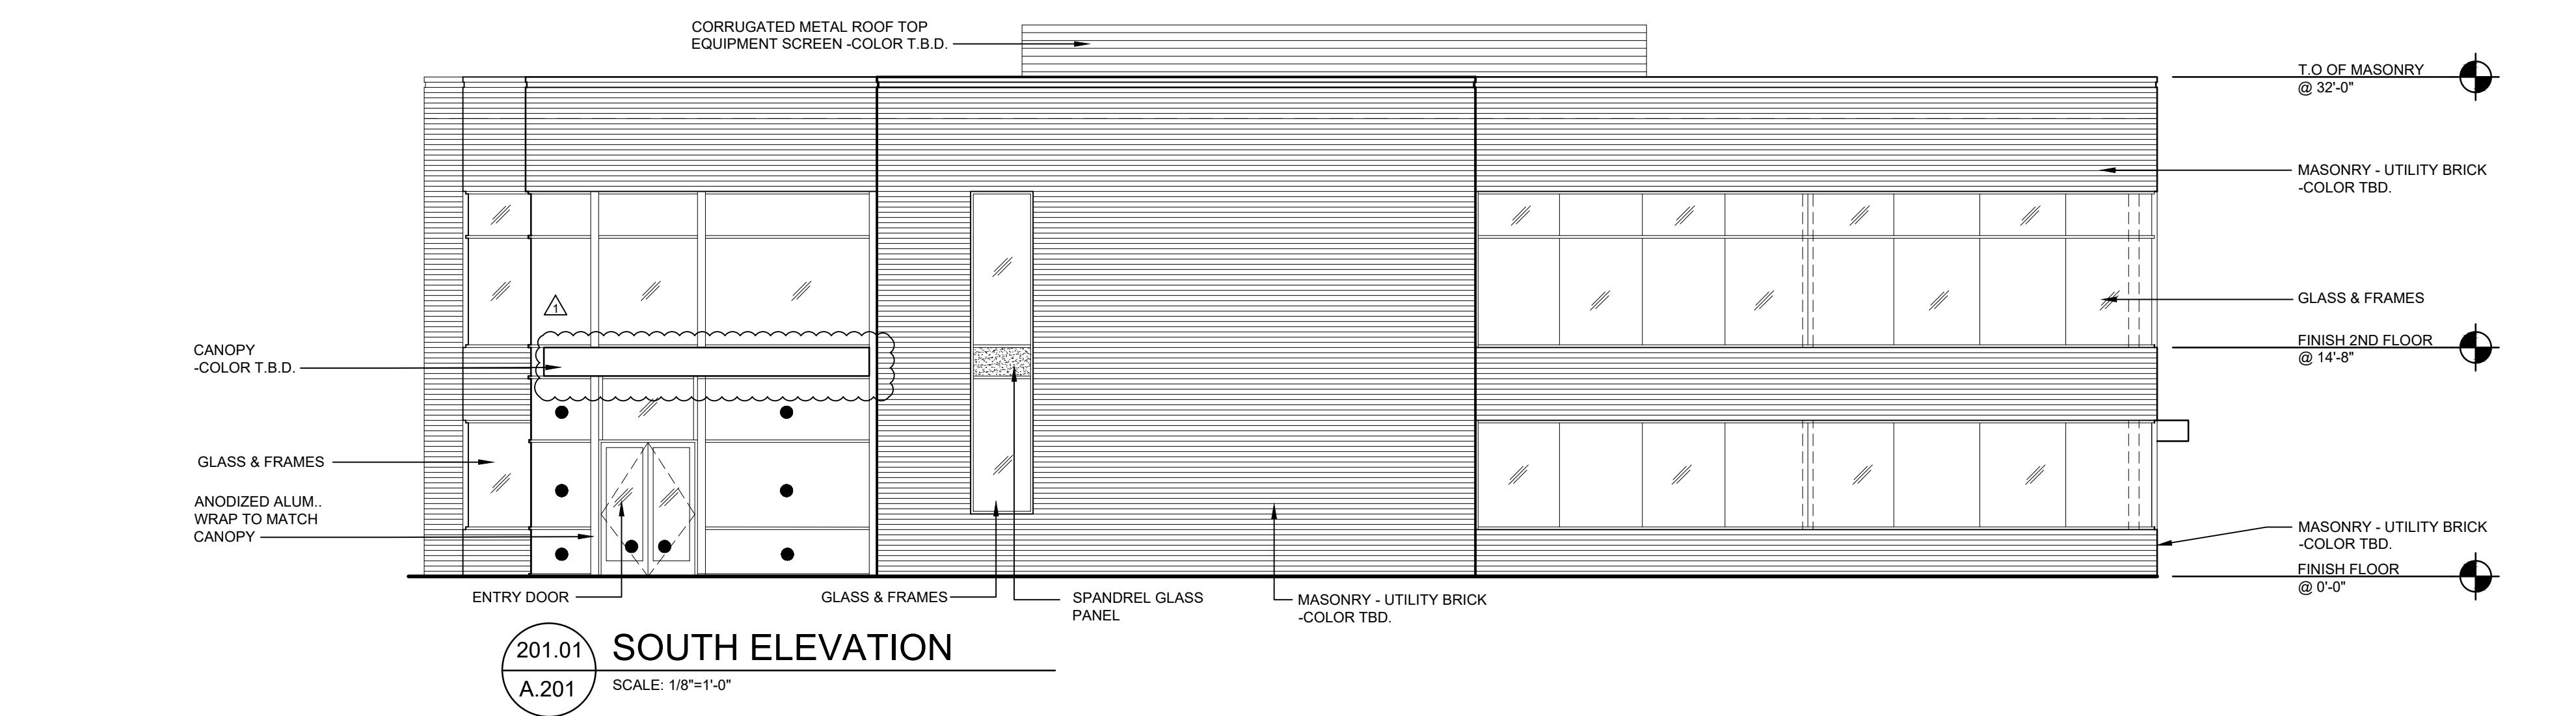

Consultants

Project title

PROPOSED BUILDING FOR:
**South Boulevard
Office Development**

905 SOUTH BOULEVARD EAST
ROCHESTER HILLS, MICHIGAN

Issued dr/ch

SITE PLAN REVIEW
11.17.17

PER CITY REVIEW
01.12.18

11.17.17
01.12.18

Sheet title

ELEVATIONS



Project no.

1999.17

Sheet no.

CITY FILE #: 17-048

A.201