


Accessory structure is less than 10 feet away from main building so the main building setbacks apply.

Rear yard setback of 30 feet required.

Side yard setback of 10 feet required.

Missing accessory structure dimensions from plot plan.

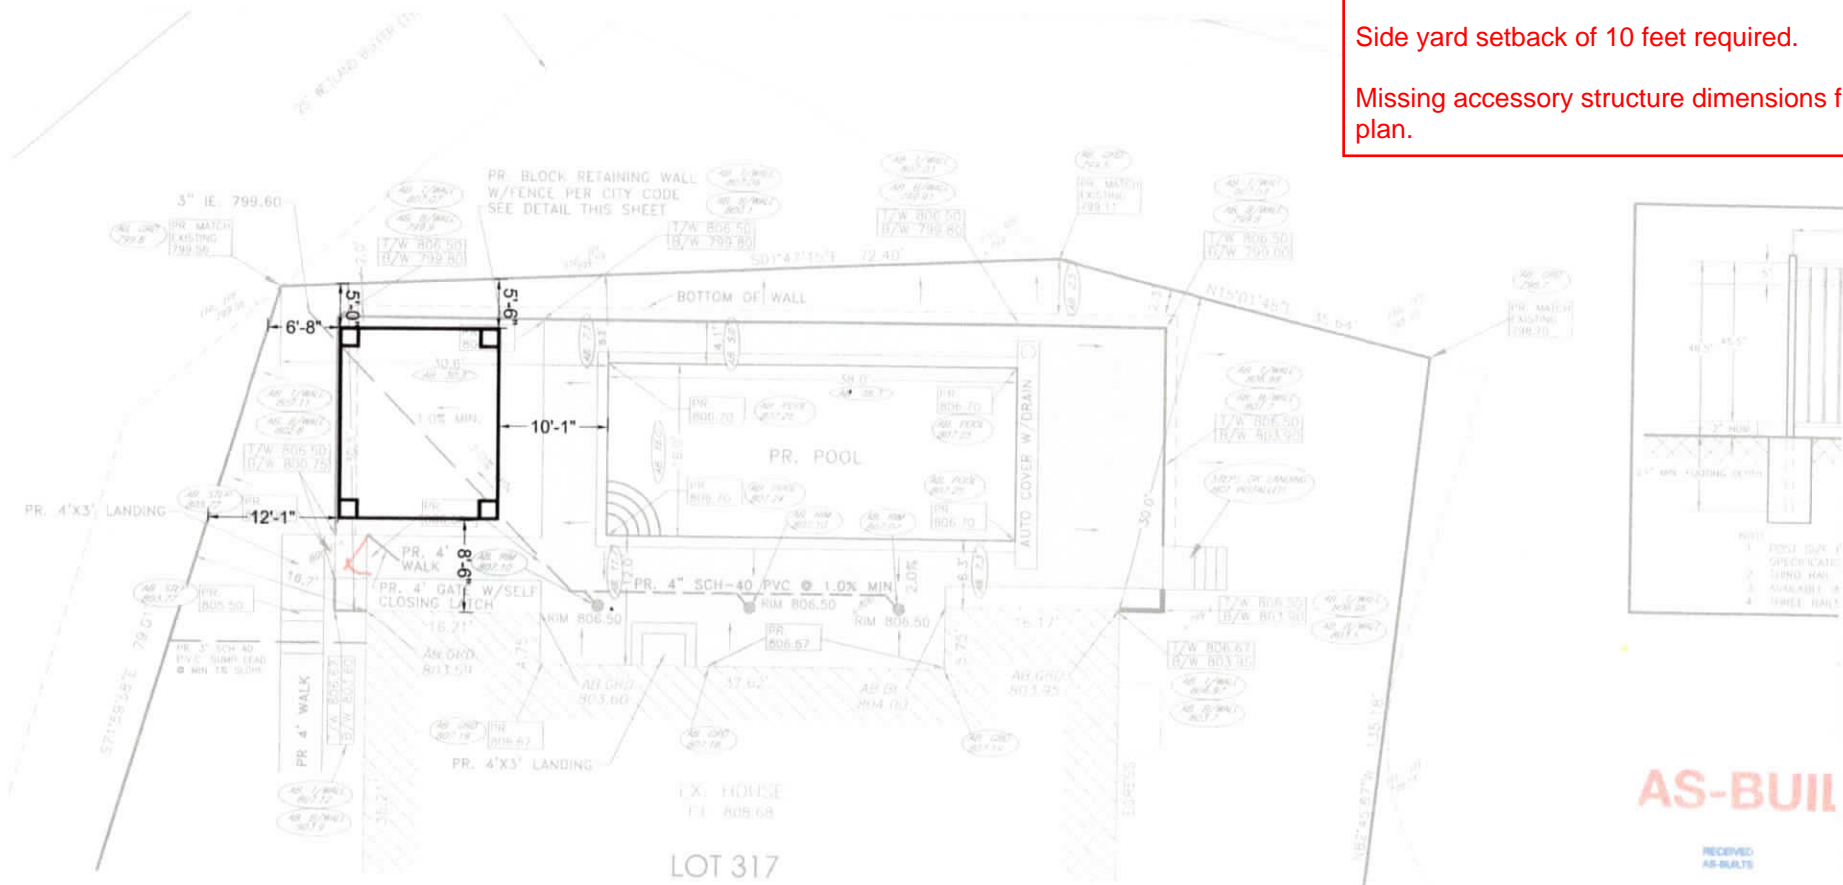

AS-BUILT

RECEIVED
AS-BUILTS

NOV 11 2013

Building Department
City of Rochester Hills

EASE CHECK GATE SWING (OPEN OUT)
NWB BE LANDING @ TOP OF STAIR @ GATE

Diamond Pro[®] Retaining Wall System
Estimating Chart for Geosynthetic Reinforcement
No Slopes / No Surcharges

SILTY/CLAYEY SAND SOIL		12 Courses 8'-0" (2400 mm)	PR. FINCE PER CITY
11	30" 120pcf (1940N/m)		

DATE: 10/25/13
FILED BY: A.C.R.D.
FINAL AS-BUILT
AS-B = AS-BUILT
AS-BR = AS-BUILT BRICK LEISURE
AS-GND = AS-BUILT FINISH GROUND
AS-T/W = AS-BUILT TOP OF WALK
AS-F/C = AS-BUILT TOP OF CURB

534 PLACID CT ROCHESTER HILLS, MI