


SITE SURVEY

LEGAL DESCRIPTION:
A PART OF THE SOUTHWEST FRACTIONAL 1/4 OF SECTION 30, T.3N., R.11E., CITY OF ROCHESTER HILLS, MICHIGAN, OAKLAND COUNTY MORE PARTICULARLY DESCRIBED AS: COMMENCING AT SOUTHWEST CORNER OF SAID SECTION 30, N.89°08'46"E., 1424.78 FT. ALONG THE SOUTH LINE OF SAID SECTION 30 AND THE CENTERLINE OF AUBURN ROAD TO THE POINT OF BEGINNING; THENCE CONTINUING N.89°08'46"E., 457.22 FT. ALONG THE SOUTH LINE OF SAID SECTION 30 AND THE CENTERLINE OF AUBURN ROAD TO THE S.W. CORNER OF ROCHESTER HILLS CORPORATE CENTER SUBDIVISION AS RECORDED IN L.193 OF PLATS, P.32-35, OAKLAND COUNTY RECORDS; THENCE N.02°56'39"W., 793.89 FT.; THENCE S.89°06'28"W., 393.53 FT.; THENCE S.02°56'39"E., 240.00 FT.; THENCE S.89°06'28"W., 156.68 FT.; THENCE S.02°56'39"E., 460.53 FT. ALONG THE EAST LINE OF WHEATON & WORRALL'S AVON HILLS ESTATES NO. 1, AS RECORDED IN L.40 OF PLATS, P.31, OAKLAND COUNTY RECORDS AND THE CENTERLINE OF YORK RD. (60 FT. WIDE); THENCE S46°53'37"E., 133.90 FT. TO THE POINT OF BEGINNING. CONTAINING 394,522.81 S.F. OR 9.057 AC. OF LAND MORE OR LESS, TOGETHER WITH THE RIGHTS OF THE PUBLIC OVER YORK RD. AND AUBURN RD. ALL OF THE ABOVE BEING SUBJECT TO EASEMENTS, RESTRICTIONS AND RIGHT-OF-WAYS OF RECORD, IF ANY.

COMMONLY KNOWN AS: 3600 AUBURN RD., ROCHESTER HILLS, MI 48307
PARCEL ID#15-30-376-032

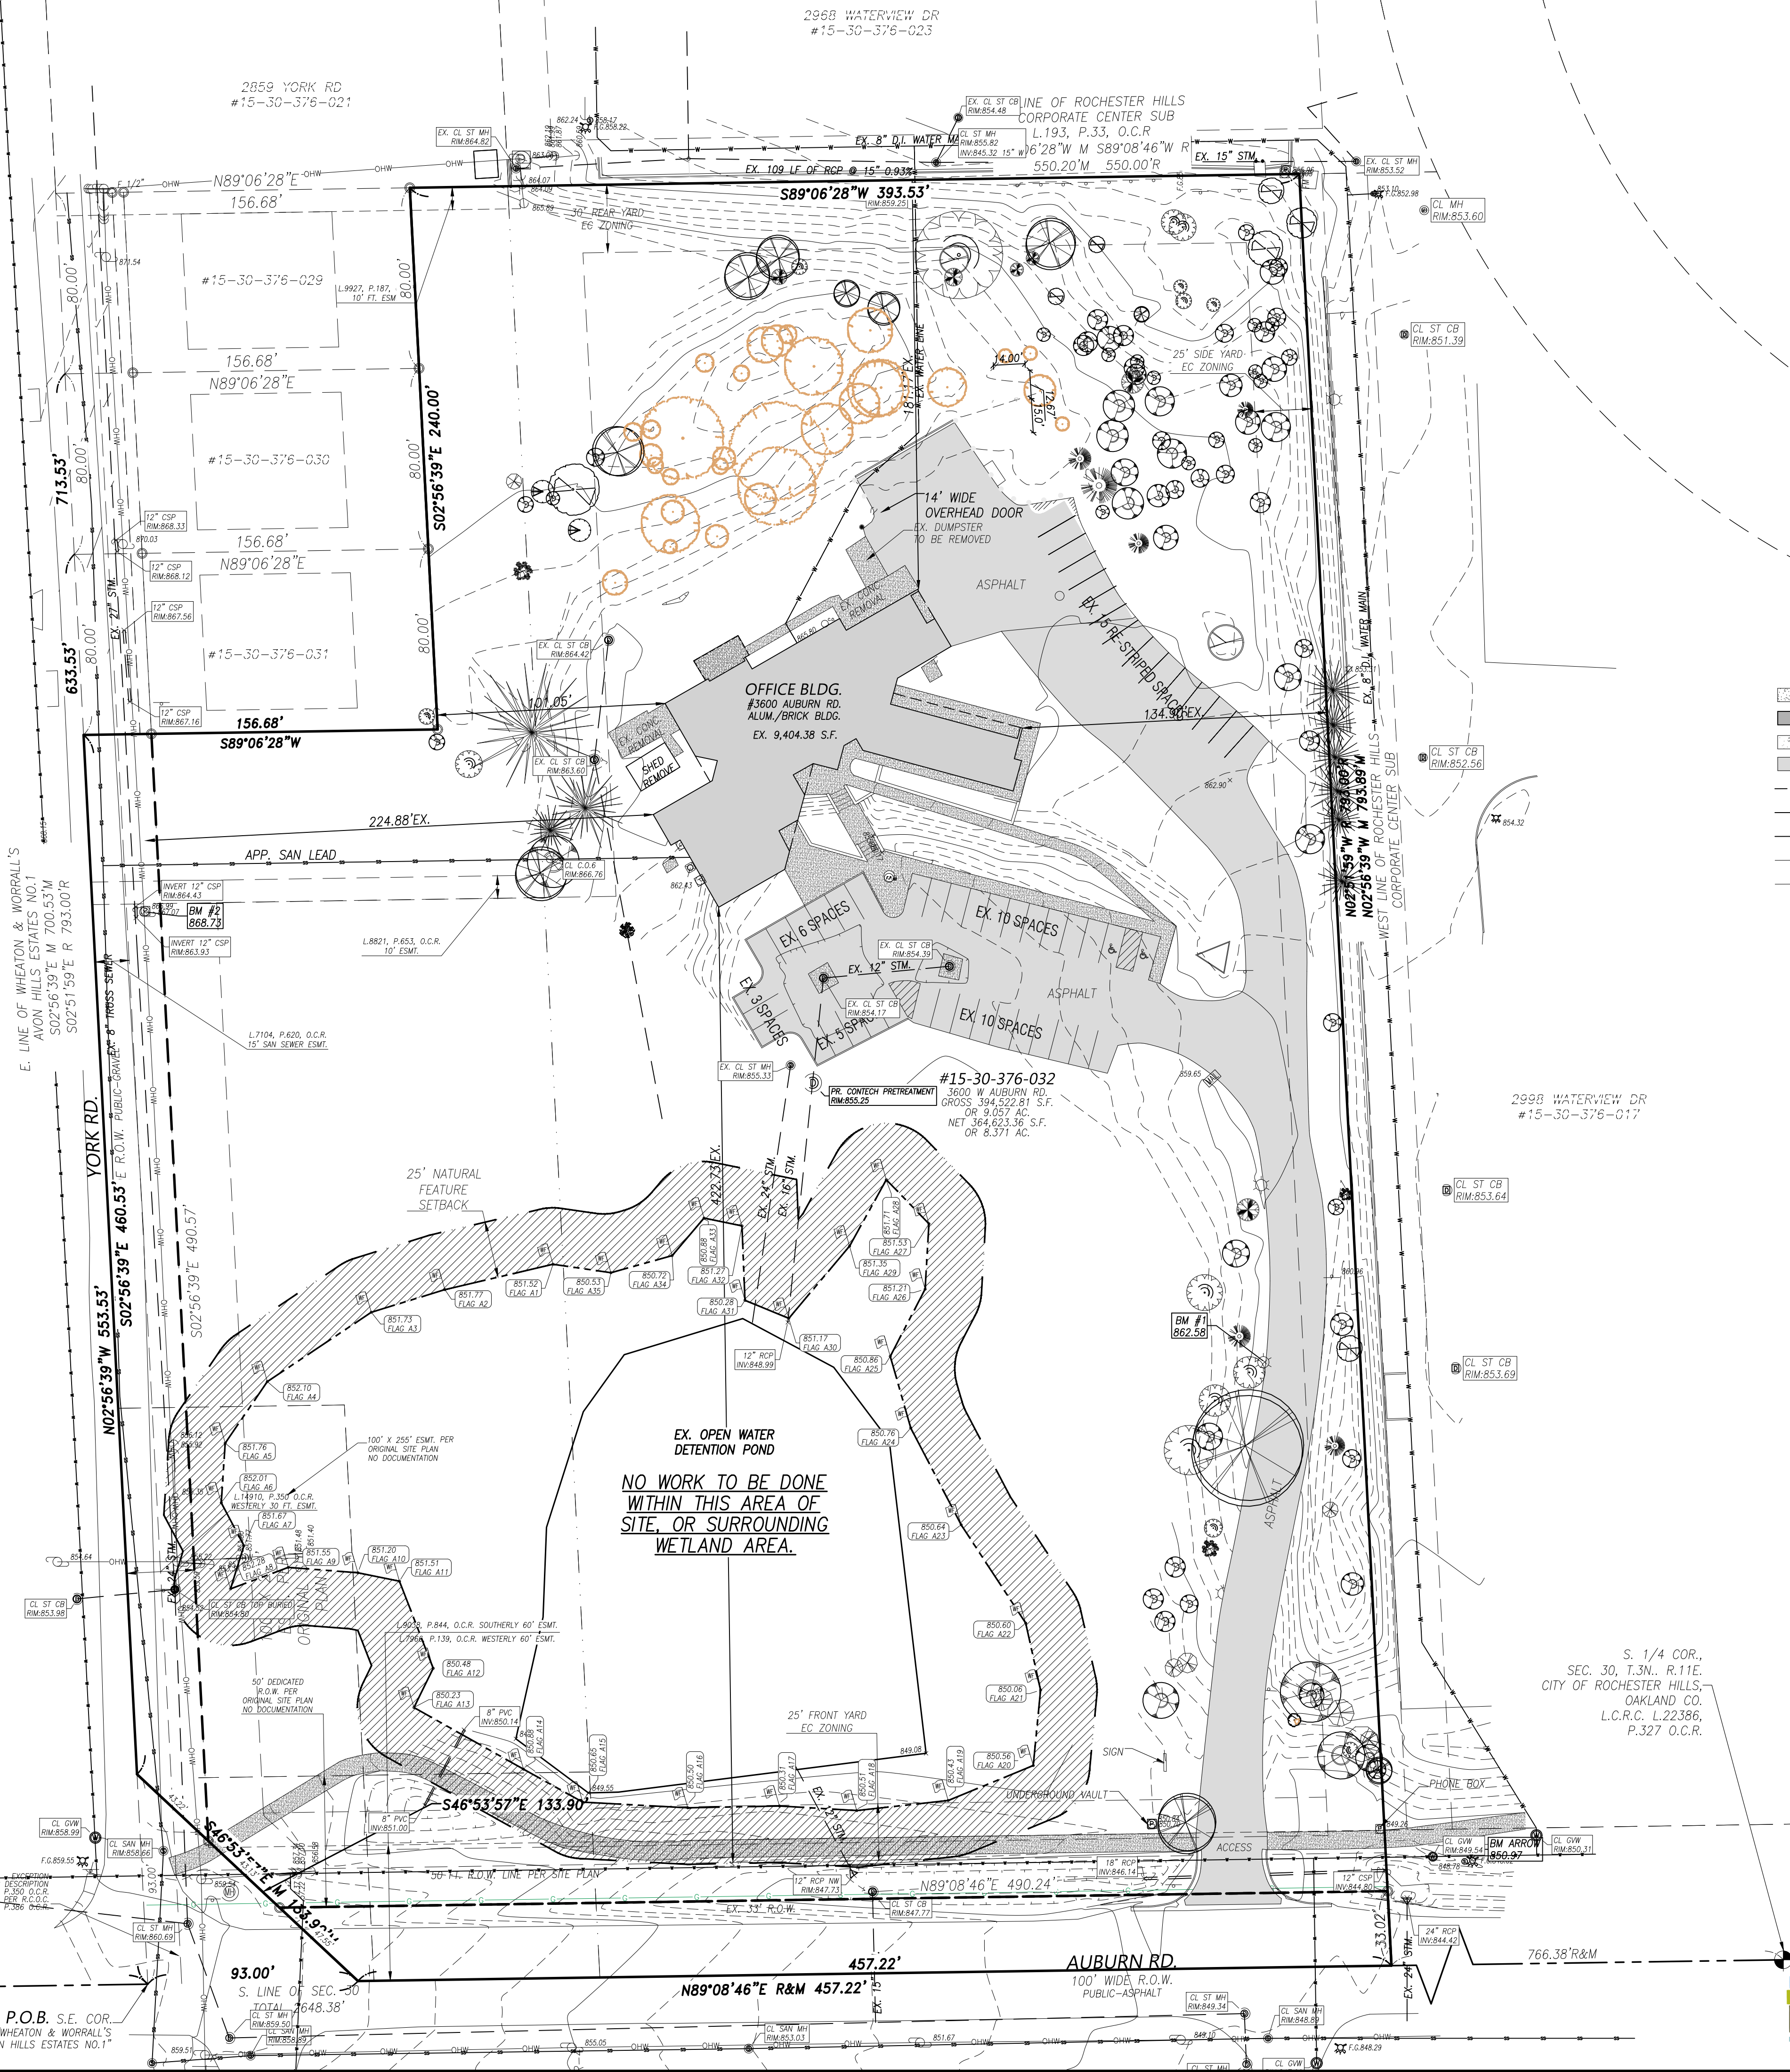

3 FULL WORKING DAYS
BEFORE YOU DIG CALL

811
Know what's below
Call before you dig
MISSDIG System, Inc.
1-800-482-7171 www.missdig.net
(TOLL FREE)

SCALE: 1" EQ. 40'

- LEGEND:**
- FOUND IRON
 - SET IRON
 - RECORD DISTANCE
 - MEASURED DISTANCE
 - EXISTING GRAVEL
 - EXISTING BUILDING
 - EXISTING CONCRETE
 - EXISTING ASPHALT
 - EXISTING STORM SEWER
 - EXISTING SANITARY SEWER
 - EXISTING WATERMAIN
 - EXISTING OVERHEAD WIRES
 - EXISTING FENCE
 - EXISTING UTILITY POLE
 - EXISTING WATER SHUT OFF
 - EXISTING GATE VALVE
 - EXISTING HYDRANT
 - EXISTING WELL
 - EXISTING GAS SHUT OFF
 - EXISTING SANITARY STRUCTURE
 - EXISTING STORM STRUCTURE
 - EXISTING DOWN SPOUT
 - EXISTING UTILITY PEDESTAL
 - EXISTING GRADE
- x 655.00

BENCHMARK:
BM #1: EAST SIDE OF CONCRETE BASE ON LIGHT POLE LOCATED ON THE WEST SIDE OF DRIVE, 240' NORTH OF ENTRANCE. ELEVATION: 862.58 NAVD88 DATUM
BM #2: MAG NAIL IN THE EAST FACE OF UTILITY POLE LOCATED ON THE EAST SIDE OF YORK RD. MIDDLE OF SITE. ELEVATION: 868.73 NAVD88 DATUM

REICHERT SURVEYING INC.
P 248.651.0592
Mail@ReichertSurveying.com
140 Flumerfelt Lane
Rochester, MI 48306

SITE SURVEY
A PART OF THE SOUTHWEST FRACTIONAL 1/4 OF SECTION 30, T.3N., R.11E., CITY OF ROCHESTER HILLS, MICHIGAN, OAKLAND COUNTY, COMMONLY KNOWN AS: 3600 AUBURN RD., ROCHESTER HILLS, MI 48307; PARCEL ID#15-30-376-032

PREPARED FOR:
AUBURN ROAD 3600 LLC
215 MONTMORENCY RD.
ROCHESTER HILLS, MI 48307
(248) 875-3531

SEAL:

NO.	DATE	DESCRIPTION	BY	CHK
1	9/10/25	REV. PER CITY		
2	9/15/25	ADD WETLANDS		

SCALE: 1"=40' DRAWN: B.G.R.
DATE: 11/18/24 CHECK: G.H.R.
JOB # 23-140 SHEET: SURVEY

J2024-0393
PSP2024-0039
Revision #2
Received 3/25/2025
City of Rochester Hills
Planning & Economic Development

TREE TABLE			TREE TABLE		
#	DESC.	ELEV.	#	DESC.	ELEV.
301	13" 18" PINE	868.27	374	6" OAK	864.63
302	12" CHERRY	867.71	375	6" OAK	863.49
303	7" BOXELDER	868.04	376	24" POPLAR	863.31
304	7" CHERRY	868.20	377	12" POPLAR	870.09
307	8" BOXELDER	865.31	393	21" POPLAR	866.92
308	13" BOXELDER	865.28	394	7" OAK	868.11
309	6" BOXELDER	865.15	395	20" POPLAR	867.24
310	8" BOXELDER	865.06	396	7" CHERRY	867.81
311	6" BOXELDER	864.73	398	9" APPLE	868.99
312	7" BOXELDER	865.07	399	10" SASSAFRAS	869.55
313	13" BOXELDER	864.64	409	7" WALNUT	870.26
314	11" BOXELDER	864.37	410	7" BOXELDER	869.68
315	7" MULBERRY	864.19	411	10" SASSAFRAS	869.97
316	10" BOXELDER	864.19	412	6" BOXELDER	869.65
317	6" BOXELDER	864.08	413	22" ELM	869.88
318	6" BOXELDER	864.04	414	8" BOXELDER	870.56
319	13" BOXELDER	864.07	415	24" POPLAR	871.60
320	6" BOXELDER	863.36	417	7" CRAB APPLE	863.55
321	6" BOXELDER	863.11	418	24" POPLAR	866.55
322	9" BOXELDER	863.38	419	11" 12" BOXELDER	866.46
323	9" BOXELDER	863.60	420	11" PINE	866.72
324	10" OAK	864.47	421	18" PINE	865.43
325	6" BOXELDER	864.05	422	8" 8" MAPLE	866.36
326	11" BOXELDER	863.21	423	12" BOXELDER	864.12
327	9" BOXELDER	862.06	424	9" BOXELDER	862.71
328	7" POPLAR	861.11	425	13" BOXELDER	862.04
329	6" CHERRY	858.49	426	8" BOXELDER	860.79
330	7" CHERRY	858.65	427	7" BOXELDER	861.04
331	6" CHERRY	858.31	428	6" APPLE	861.22
332	9" BOXELDER	862.98	429	10" BOXELDER	862.76
333	9" BOXELDER	864.44	430	11" ELM	864.24
334	9" BOXELDER	864.40	431	9" MULBERRY	864.00
335	7" ELM	863.83	432	8" BOXELDER	864.79
336	7" ELM	860.00	433	7" WALNUT	864.08
337	11" CHERRY	858.54	434	24" 28" POPLAR	860.39
338	12" CHERRY	858.57	435	12" BOXELDER	859.16
339	6" BOXELDER	865.20	436	10" OAK	860.72
344	10" MULBERRY	865.94	437	10" 11" BOXELDER BAD	850.97
345	8" 8" MULBERRY	866.09	438	7" CHERRY	851.73
346	12" BOXELDER	865.85	439	16" WALNUT	852.64
347	14" BOXELDER	865.76	440	8" WALNUT	853.89
348	6" BOXELDER	865.92	441	12" BOXELDER	852.00
349	10" BOXELDER	865.46	442	8" BOXELDER	852.61
350	9" MULBERRY	865.92	443	12" POPLAR POOR	852.56
351	11" BOXELDER	865.37	444	12" WALNUT	855.46
352	8" BOXELDER	865.24	445	10" WALNUT	856.32
353	8" BOXELDER	865.13	446	5" 6" BOXELDER	856.70
354	14" BOXELDER	865.67	447	12" 15" BOXELDER	857.23
355	14" BOXELDER	865.32	448	6" CATALPA	854.38
356	15" ELM	859.54	449	27" POPLAR	850.86
357	8" BOXELDER	859.25	450	16" BOXELDER	851.83
358	11" BOXELDER	859.50	451	8" WALNUT	853.14
359	8" BOXELDER	860.89	452	9" WALNUT	853.97
360	6" BOXELDER	861.70	453	9" BOXELDER	852.78
361	9" BOXELDER	862.12	454	9" BOXELDER POOR	853.48
362	6" BOXELDER	861.80	455	8" APPLE	857.22
363	8" BOXELDER	860.80	456	8" BOXELDER	854.40
364	7" BOXELDER	862.59	457	9" BOXELDER	854.64
365	11" BOXELDER	863.64	458	8" CHERRY	857.49
366	9" BOXELDER	864.26	459	10" 12" CHERRY	856.45
367	11" ELM	857.34	460	12" BOXELDER	857.62
368	13" ELM	856.85	461	14" CHERRY	857.51
369	7" BOXELDER	859.43	462	14" 14" CHERRY VERY POOR	860.16
370	15" POPLAR	870.17	463	10" MULBERRY	859.18

TREE TABLE			TREE TABLE		
#	DESC.	ELEV.	#	DESC.	ELEV.
301	13" 18" PINE	868.27	374	6" OAK	864.63
302	12" CHERRY	867.71	375	6" OAK	863.49
303	7" BOXELDER	868.04	376	24" POPLAR	863.31
304	7" CHERRY	868.20	377	12" POPLAR	870.09
307	8" BOXELDER	865.31	393	21" POPLAR	866.92
308	13" BOXELDER	865.28	394	7" OAK	868.11
309	6" BOXELDER	865.15	395	20" POPLAR	867.24
310	8" BOXELDER	865.06	396	7" CHERRY	867.81
311	6" BOXELDER	864.73	398	9" APPLE	868.99
312	7" BOXELDER	865.07	399	10" SASSAFRAS	869.55
313	13" BOXELDER	864.64	409	7" WALNUT	870.26
314	11" BOXELDER	864.37	410	7" BOXELDER	869.68
315	7" MULBERRY	864.19	411	10" SASSAFRAS	869.97
316	10" BOXELDER	864.19	412	6" BOXELDER	869.65
317	6" BOXELDER	864.08	413	22" ELM	869.88
318	6" BOXELDER	864.04	414	8" BOXELDER	870.56
319	13" BOXELDER	864.07	415	24" POPLAR	871.60
320	6" BOXELDER	863.36	417	7" CRAB APPLE	863.55
321	6" BOXELDER	863.11	418	24" POPLAR	866.55
322	9" BOXELDER	863.38	419	11" 12" BOXELDER	866.46
323	9" BOXELDER	863.60	420	11" PINE	866.72
324	10" OAK	864.47	421	18" PINE	865.43
325	6" BOXELDER	864.05	422	8" 8" MAPLE	866.36
326	11" BOXELDER	863.21	423	12" BOXELDER	864.12
327	9" BOXELDER	862.06	424	9" BOXELDER	862.71
328	7" POPLAR	861.11	425	13" BOXELDER	862.04
329	6" CHERRY	858.49	426	8" BOXELDER	860.79
330	7" CHERRY	858.65	427	7" BOXELDER	861.04
331	6" CHERRY	858.31	428	6" APPLE	861.22
332	9" BOXELDER	862.98	429	10" BOXELDER	862.76
333	9" BOXELDER	864.44	430	11" ELM	864.24
334	9" BOXELDER	864.40	431	9" MULBERRY	864.00
335	7" ELM	863.83	432	8" BOXELDER	864.79
336	7" ELM	860.00	433	7" WALNUT	864.08
337	11" CHERRY	858.54	434	24" 28" POPLAR	860.39
338	12" CHERRY	858.57	435	12" BOXELDER	859.16
339	6" BOXELDER	865.20	436	10" OAK	860.72
344	10" MULBERRY	865.94	437	10" 11" BOXELDER BAD	850.97
345	8" 8" MULBERRY	866.09	438	7" CHERRY	851.73
346	12" BOXELDER	865.85	439	16" WALNUT	852.64
347	14" BOXELDER	865.76	440	8" WALNUT	853.89
348	6" BOXELDER	865.92	441	12" BOXELDER	852.00
349	10" BOXELDER	865.46	442	8" BOXELDER	852.61
350	9" MULBERRY	865.92	443	12" POPLAR POOR	852.56
351	11" BOXELDER	865.37	444	12" WALNUT	855.46
352	8" BOXELDER	865.24	445	10" WALNUT	856.32
353	8" BOXELDER	865.13	446	5" 6" BOXELDER	856.70
354	14" BOXELDER	865.67	447	12" 15" BOXELDER	857.23
355	14" BOXELDER	865.32	448	6" CATALPA	854.38
356	15" ELM	859.54	449	27" POPLAR	850.86
357	8" BOXELDER	859.25	450	16" BOXELDER	851.83
358	11" BOXELDER	859.50	451	8" WALNUT	853.14
359	8" BOXELDER	860.89	452	9" WALNUT	853.97
360	6" BOXELDER	861.70	453	9" BOXELDER	852.78
361	9" BOXELDER	862.12	454	9" BOXELDER POOR	853.48
362	6" BOXELDER	861.80	455	8" APPLE	857.22
363	8" BOXELDER	860.80	456	8" BOXELDER	854.40
364	7" BOXELDER	862.59	457	9" BOXELDER	854.64
365	11" BOXELDER	863.64	458	8" CHERRY	857.49
366	9" BOXELDER	864.26	459	10" 12" CHERRY	856.45
367	11" ELM	857.34	460	12" BOXELDER	857.62
368	13" ELM	856.85	461	14" CHERRY	857.51
369	7" BOXELDER	859.43	462	14" 14" CHERRY VERY POOR	860.16
370	15" POPLAR	870.17	463	10" MULBERRY	859.18


TREE TABLE		
#	DESC.	ELEV.
481	10" PINE	858.28
482	13" PINE	858.31
483	12" PINE	858.08
484	11" PINE	858.16
485	13" PINE	858.09
486	8" BOXELDER	862.92
REMOVAL TREE TABLE		
#	DESC.	ELEV.
305	11" WALNUT	867.29
306	7" 10" MULBERRY	868.56
340	6" BOXELDER	866.39
341	6" BOXELDER	866.83
342	14" CHERRY POOR	867.05
343	6" MULBERRY	866.43
378	9" 11" BOXELDER	871.57
379	8" 8" 9" BOXELDER	869.50
380	10" 15" BOXELDER	869.73
381	9" 9" BOXELDER POOR	869.45
382	11" 12" BOXELDER	869.60
383	7" 9" 10" BOXELDER	872.64
384	8" POPLAR	872.41
385	14" POPLAR	872.59
386	16" POPLAR	872.84
387	7" ELM	873.42
388	6" 10" 12" 15" BOXELDER	869.95
389	8" 10" 12" BOXELDER	869.04
390	14" BOXELDER	868.33
391	7" BOXELDER	870.71
392	10" BOXELDER	871.32
397	8" BOXELDER	871.35
400	6" WALNUT	867.91
401	10" WALNUT	867.25
402	10" BOXELDER	869.46
403	13" 13" BOXELDER	868.94
404	7" BOXELDER	870.75
405	7" BOXELDER	871.10
406	10" BOXELDER	871.56
407	10" 13" 14" BOXELDER	871.64
408	8" BOXELDER	872.03
416	8" BOXELDER	871.57

A. NUMBER OF REGULATED TREES (> 6") OUTSIDE OF BUILDING ENVELOPE
(SEE SEC. 126-327 (1) A.) FOR DESCRIPTION OF BUILDING ENVELOPES
BASED ON LOT AND DEVELOPMENT TYPE
(DO NOT COUNT DEAD TREES - EXCEPTIONS)

A.	NUMBER OF REGULATED TREES (> 6") OUTSIDE OF BUILDING ENVELOPE (SEE SEC. 126-327 (1) A.) FOR DESCRIPTION OF BUILDING ENVELOPES BASED ON LOT AND DEVELOPMENT TYPE (DO NOT COUNT DEAD TREES - EXCEPTIONS)	157
B.	NUMBER OF REGULATED TREES OUTSIDE OF BUILDING ENVELOPE BEING PRESERVED	125 120/157 OR 0.796
C.	PRESERVATION PERCENTAGE = B / A	79.6% > 40 % MUST BE MIN. OF 40% - SEC.

A. TOTAL NUMBER OF REGULATED TREES INSIDE AND OUTSIDE OF BUILDING ENVELOPE). (DO NOT COUNT DEAD TREES - EXCEPT

A.	TOTAL NUMBER OF REGULATED TREES BEING REMOVED ON SITE (BOTH INSIDE AND OUTSIDE OF BUILDING ENVELOPE). (DO NOT COUNT DEAD TREES – EXCEPTIONS)	32	1 INSIDE 31 OUTSIDE
B.	NUMBER OF REGULATED "NUISSANCE TREES" BEING REMOVED ON SITE (SEE SEC. 126-397 (4)) REQUIRES ONE FOR ONE REPLACEMENT	0	
C.	NUMBER OF REGULATED TREES (NONNUISSANCE) BEING REMOVED THAT ARE NOT OF SIZE TO BE CONSIDERED "SPECIMEN TREES" ON SITE (SEE SEC. 126-397 A.) REQUIRES ONE FOR ONE REPLACEMENT	32	
D.	TOTAL DBH OF "SPECIMEN TREES" BEING REMOVED ON SITE (SEE SEC. 126-397 (3) A.) REQUIRES 50% REPLACEMENT	0	
E.	TOTAL NUMBER OF "SPECIMEN TREES" BEING PRESERVED ON SITE (SEE SEC. 126-397 (3)) 2" TREE CREDIT GIVEN FOR EACH SPECIMEN TREE PRESERVED	7	
F.	NUMBER OF 2" TREE REPLACEMENTS REQUIRED FOR SPECIMEN TREES = $(0.5 \times D) / 2$	0	
G.	TOTAL NUMBER OF 2" TREES REQUIRING REPLACEMENT = $(B+C+F) - E$	25	$(0+32+0)-7$

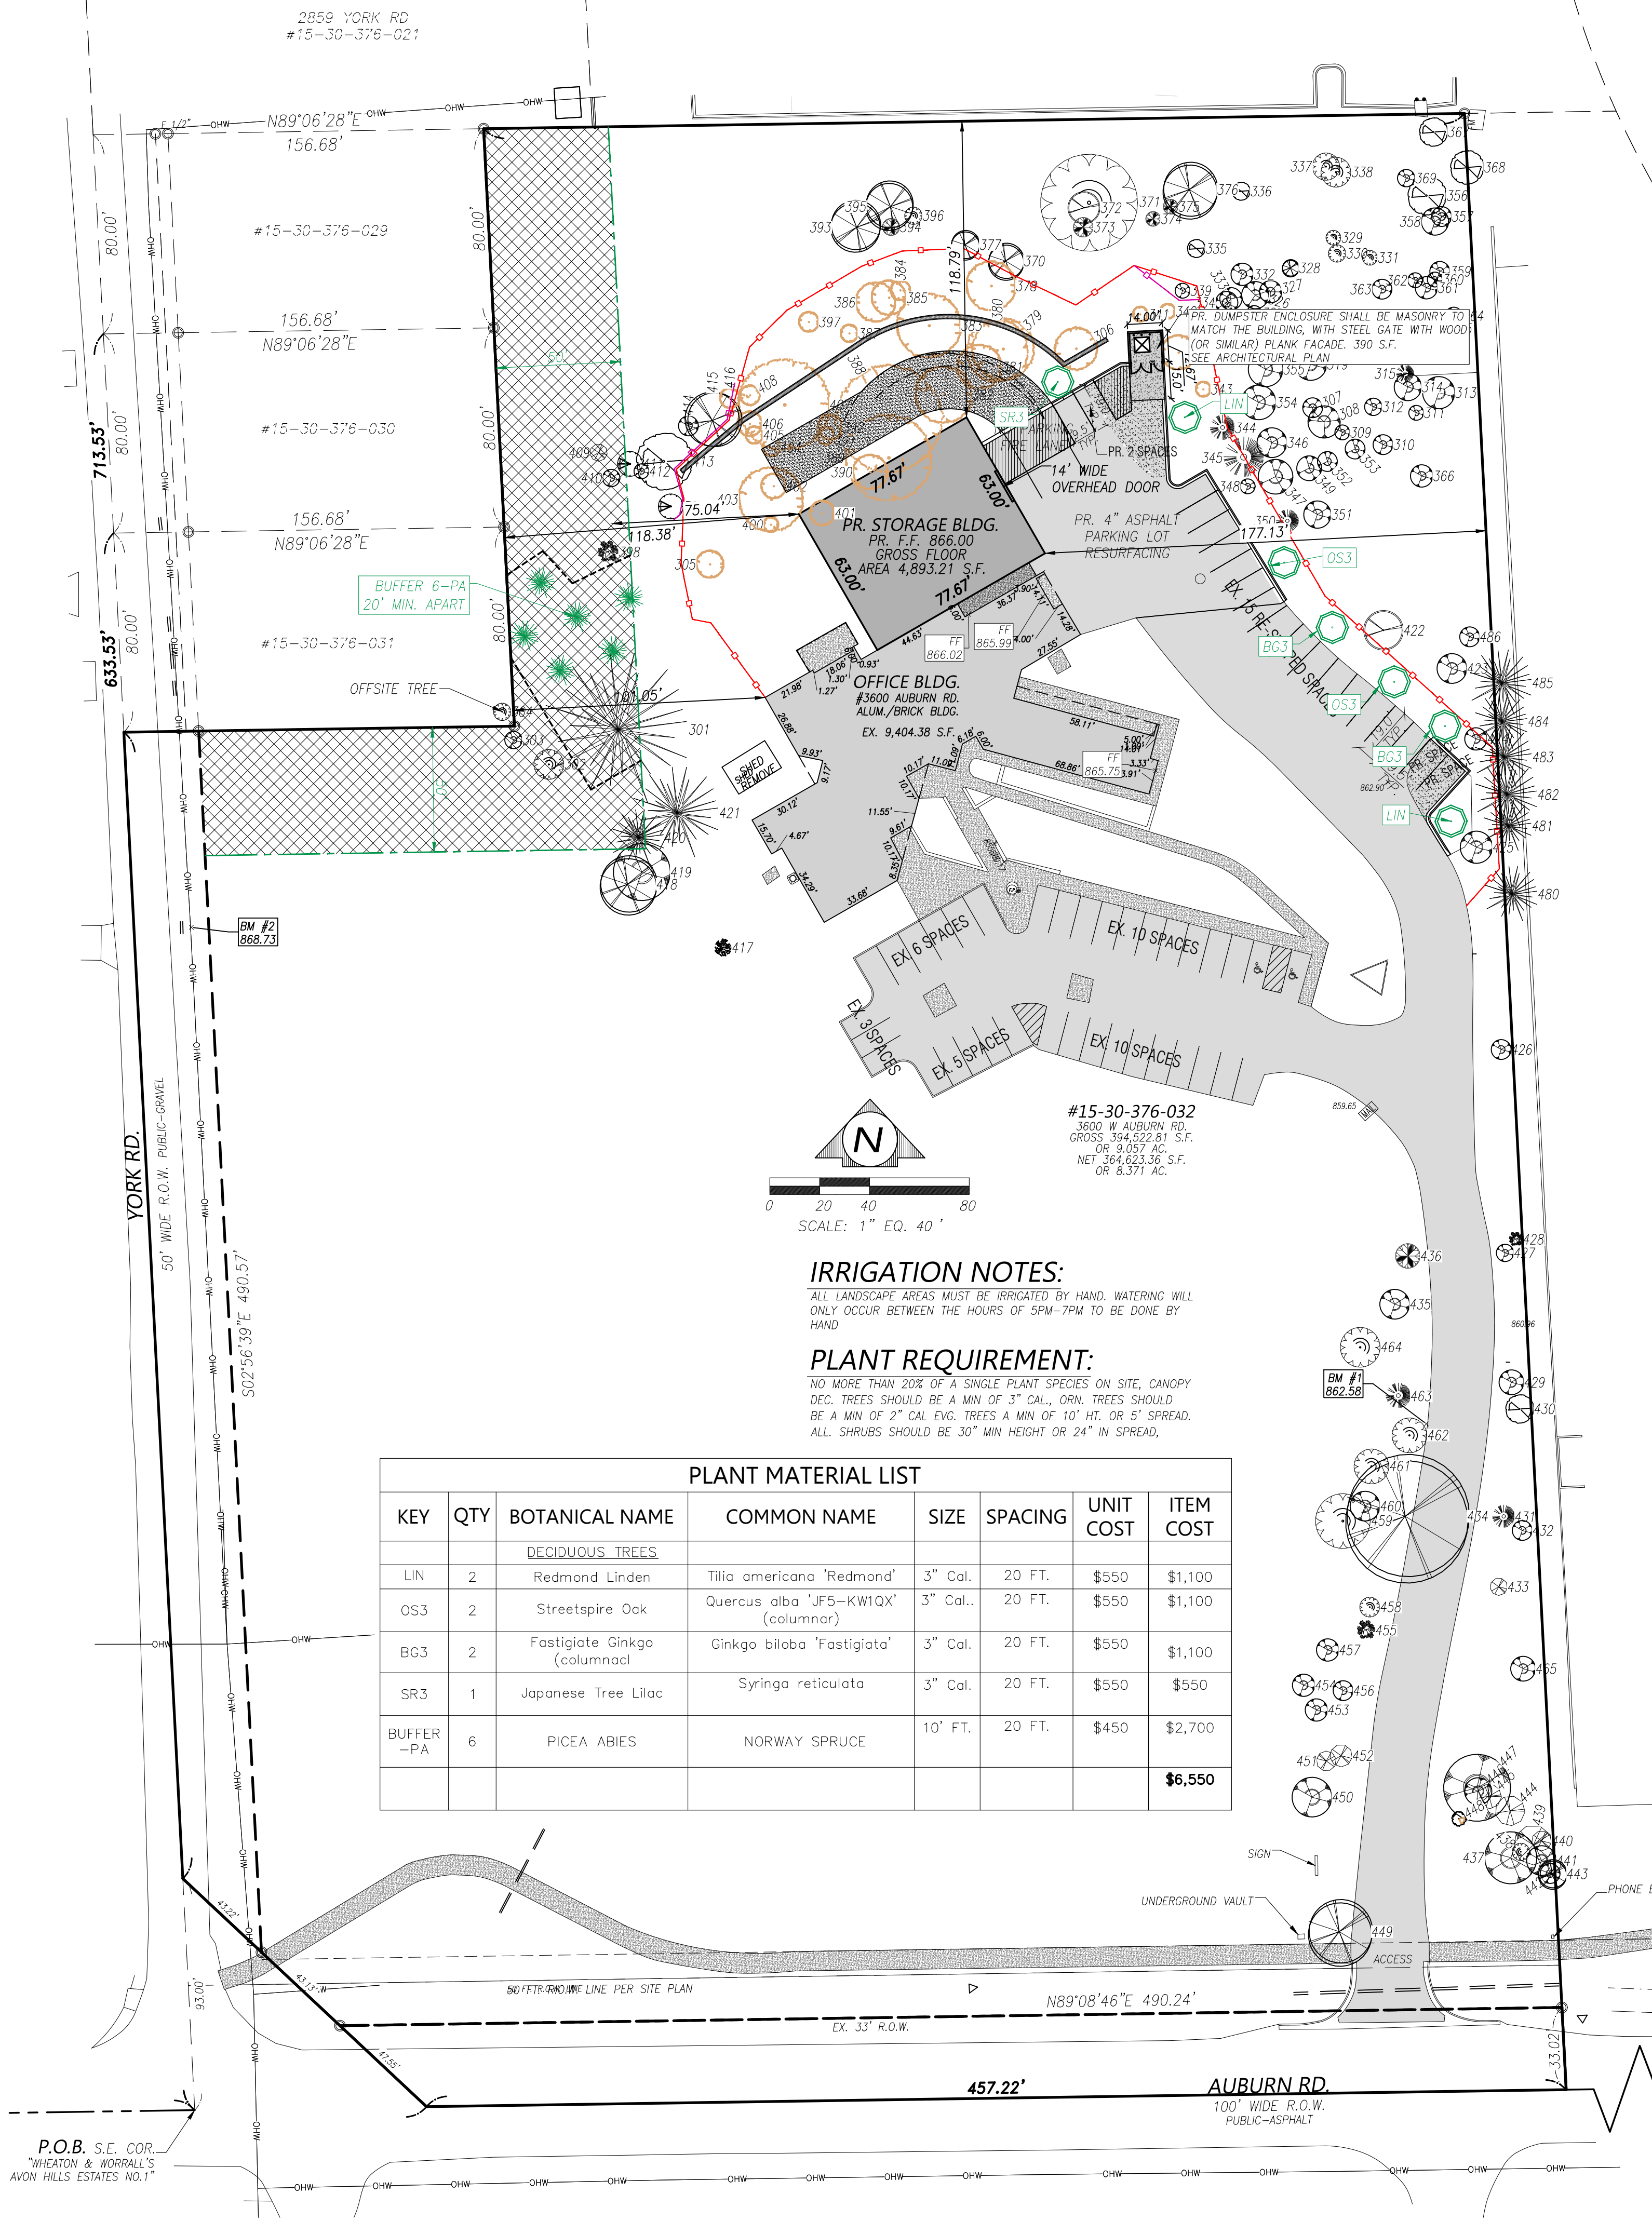

PLANT MATERIAL LIST							
KEY	QTY	BOTANICAL NAME	COMMON NAME	SIZE	SPACING	UNIT COST	ITEM COST
		<u>DECIDUOUS TREES</u>					
LIN	2	Redmond Linden	Tilia americana 'Redmond'	3" Cal.	20 FT.	\$550	\$1,100
OS3	2	Streetspire Oak	Quercus alba 'JF5-KW1QX' (columnar)	3" Cal..	20 FT.	\$550	\$1,100
BG3	2	Fastigate Ginkgo (columnar)	Ginkgo biloba 'Fastigiata'	3" Cal.	20 FT.	\$550	\$1,100
SR3	1	Japanese Tree Lilac	Syringa reticulata	3" Cal.	20 FT.	\$550	\$550
BUFFER -PA	6	PICEA ABIES	NORWAY SPRUCE	10' FT.	20 FT.	\$450	\$2,700
							\$6,550

IRRIGATION NOTES:

ALL LANDSCAPE AREAS MUST BE IRRIGATED BY HAND. WATERING WILL ONLY OCCUR DURING THE HOURS OF 5PM-7PM TO BE DONE BY HAND

PLANT REQUIREMENT:

NO MORE THAN 20% OF A SINGLE PLANT SPECIES ON SITE, CANOPY DEC. TREES SHOULD BE A MIN OF 3" CAL., ORN. TREES SHOULD BE A MIN OF 2" CAL EVC. TREES A MIN OF 10' HT. OR 5' SPREAD. ALL SHRUBS SHOULD BE 30" MIN HEIGHT OR 24" IN SPREAD,

[illegible]

CITY FILE #24-0393 SECTION 30

FIRE PROTECTION PLAN



BENCHMARK:

BM #1: EAST SIDE OF CONCRETE BASE ON
LIGHT POLE LOCATED ON THE WEST SIDE
OF DRIVE 240' NORTH OF ENTRANCE.
ELEVATION: 862.58 NAVD88 DATUM

BM #2: MAG NAIL IN THE EAST FACE OF
UTILITY POLE LOCATED ON THE EAST SIDE
OF YORK RD. MIDDLE OF SITE.
ELEVATION: 868.73 NAVD88 DATUM

SITE NOTES:

ZONING: CITY EC & R-4:
EMPLOYMENT CENTER &
ONE-FAMILY RESIDENTIAL DISTRICT

AREA & WIDTH:

50 E. NONRESIDENTIAL LOT REQUIREMENTS, THE MINIMUM LOT AREA AND MINIMUM LOT WIDTH SHALL BE DETERMINED BY THE USE MEETING ALL MINIMUM VARY REQUIREMENTS AND ALL THE REQUIREMENTS OF THIS ORDINANCE, IN C/D DISTRICTS, PARCELS WITH LESS AREA OR WIDTH THAN THE MINIMUM REQUIREMENTS OF THIS ORDINANCE SHALL BE SUBJECT TO ALL OF THE FOLLOWING EXCEPT:

1. THE PARCEL IS ACCESSED THROUGH EXISTING ACCESS POINTS; ADDITIONAL ACCESS POINTS MAY ONLY BE CONSTRUCTED UPON APPROVAL BY THE PLANNING COMMISSION.

2. A COVENANT RESTRICTION PROHIBITING ADDITIONAL INGRESS/EGRESS DROVES FROM ABUTTING PUBLIC THOROUGHFARES WITHOUT PLANNING COMMISSION APPROVAL, SHALL BE RECORDED AT OAKLAND COUNTY.

3. ACCESS TO THE PARCEL SHALL BE PROVIDED TO NEIGHBORING PARCELS, IF FEASIBLE.

4. ANY PARCEL CREATED AS A RESULT OF THIS ORDINANCE SHALL NOT BE ENTITLED TO A SEPARATE FREESTANDING MONUMENT SIGN.

MAX. HEIGHT:
STORIES:

3 STORIES ^Q OR 42' ^Q

Q. INCREASED BUILDING HEIGHT, THE MAXIMUM HEIGHT FOR BUILDINGS IN THE O-1 AND EC DISTRICTS MAY EXCEED THE MAXIMUM HEIGHT IN SECTION 138-5-10 IN ACCORDANCE WITH THE FOLLOWING REQUIREMENTS:

1. HEIGHT MODIFICATIONS FOR PROJECTS LOCATED ON SITES WITH LESS THAN FIVE ACRES SHALL REQUIRE CONDITIONAL USE APPROVAL, IN ACCORDANCE WITH THE PROCEDURES OF ARTICLE 2, CHAPTER 3 (CONDITIONAL USE APPROVAL).
2. HEIGHT MODIFICATIONS FOR PROJECTS LOCATED ON SITES WITH FIVE OR MORE ACRES OF LAND ARE SUBJECT TO PLANNING COMMISSION APPROVAL.
3. FOR THOSE BUILDINGS WITH A PITCHED ROOF, THE MAXIMUM HEIGHT MAY NOT EXCEED 55 FEET AS MEASURED TO THE ROOF SYSTEM.
4. ANY STRUCTURE IN THE O OR EC DISTRICT ABUTTING LAND PLANNED FOR ONE-FAMILY RESIDENTIAL LAND USES ON THE MASTER LAND USE PLAN FUTURE LAND USE MAP SHALL INCREASE THE REQUIRED HURD ABUTTING THE RESIDENTIAL DISTRICT BY TWO FEET FOR EVERY FOOT OF HEIGHT IN EXCESS OF THE MAXIMUM HEIGHT OF THE HIGHEST BUILT FOR FLAT ROOF SYSTEMS OR TO THE MID-POINT OF PITCHED ROOFS.

MINIMUM SETBACK:


FRONT SETBACK: 25 FT.
SIDE: 25 FT.⁰ / TOTAL: 50 FT.
REAR: 30 FT

**3 FULL WORKING DAYS
BEFORE YOU DIG CALL**

811

Know what's below

Call before you dig
MISS DIG System, Inc.
1-800-482-7171 www.missdig.net
(TOLL FREE)

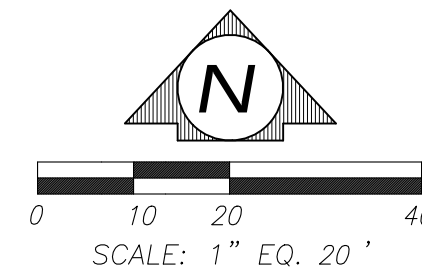

LEGEND:

- | | |
|--|-----------------------------|
| | FOUND IRON |
| | SET IRON |
| | RECORD DISTANCE |
| | MEASURED DISTANCE |
| | EXISTING GRAVEL |
| | EXISTING BUILDING |
| | EXISTING CONCRETE |
| | EXISTING ASPHALT |
| | EXISTING STORM SEWER |
| | EXISTING SANITARY SEWER |
| | EXISTING WATERMAIN |
| | EXISTING OVERHEAD WIRES |
| | EXISTING FENCE |
| | EXISTING UTILITY POLE |
| | EXISTING WATER SHUT OFF |
| | EXISTING GATE VALVE |
| | EXISTING HYDRANT |
| | EXISTING WELL |
| | EXISTING GAS SHUT OFF |
| | EXISTING SANITARY STRUCTURE |
| | EXISTING STORM STRUCTURE |
| | EXISTING DOWN SPOUT |
| | EXISTING UTILITY PEDESTAL |
| | EXISTING GRADE |
| | PR. GRADE |
| | PR. CONCRETE |
| | PR. BUILDING |
| | PR. SILT FENCE |
| | PR. DRAINAGE ARROW |
| | PR. MAJOR CONTOURS |
| | PR. MINOR CONTOURS |

FIRE DEPARTMENT NOTES:

CONSTRUCTION SITES SHALL BE SAFEGUARDED IN ACCORDANCE WITH IFC CHAPTER 14.


OPEN BURNING IS NOT PERMITTED, INCLUDING THE BURNING OF TRASH, DEBRIS, OR LAND CLEARING MATERIALS. OPEN BURNING FOR WARMING SAND AND/OR WATER FOR PREPARATION OF MORTAR SHALL BE WITHIN CITY OF ROCHESTER HILLS BURN PERMIT GUIDELINES. CONTACT ROCHESTER HILLS FIRE DEPARTMENT FOR PERMIT INFORMATION.

A KNOX KEY SYSTEM SHALL BE INSTALLED, IN A LOCATION APPROVED BY THE FIRE CODE OFFICIAL. ORDERING INFORMATION IS AVAILABLE FROM THE KNOX COMPANY AT "KNOXBOX.COM".

FIRE LANES SHALL BE CONSPICUOUSLY POSTED ON BOTH SIDES OF THE FIRE LANE, WITH FIRE LANE SIGNS SPACED NOT MORE THAN 100 FT. APART, FIRE LANE SIGNS SHALL READ "NO STOPPING, STANDING, PARKING, FIRE LANE", AND IN CONFORMANCE WITH THE MICHIGAN MANUAL OF UNIFORM TRAFFIC CONTROL DEVICES.

PROVIDE A "NO PARKING FIRE DEPARTMENT CONNECTION" SIGN OVER THE FIRE DEPARTMENT CONNECTION.

A WHITE/CLEAR STrobe LIGHT SHALL BE TIED INTO THE FIRE ALARM SYSTEM AND INSTALLED OVER THE FIRE DEPARTMENT CONNECTION.

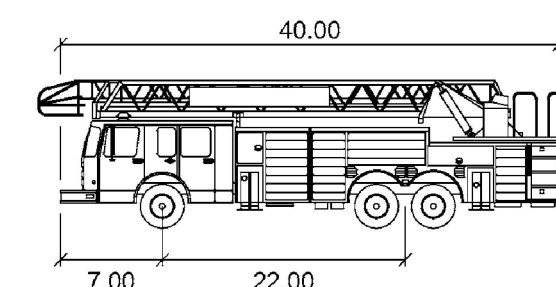

Fire Truck

	feet
Width	: 8.5
Track	: 8.5
Lock to Lock Time	: 6.0
Steering Angle	: 33.3


FIRE PROTECTION PLAN

FILE PROTECTION PLAN
A PART OF THE SOUTHWEST FRACTIONAL 1/4 OF SECTION 30, T.3N., R.11E., CITY
OF ROCHESTER HILLS, MICHIGAN, OAKLAND COUNTY, MICHIGAN
COMMONLY KNOWN AS: 3600 AUBURN RD., ROCHESTER HILLS, MI 48307; PARCEL
ID#15-30-376-032

PREPARED FOR:
AUBURN ROAD 3600 LLC

MONTMORENCY RD.
STER HILLS, MI 48307
(248) 875-3531

SEAL

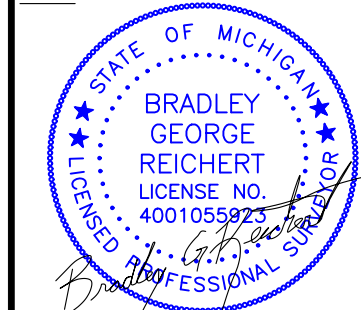

NO.	DATE	DESCRIPTION	BY
SCALE: 1"=20'		DRAWN: B.G.R.	
DATE: 11/18/24		CHECK: G.H.R.	
JOB # 23-140		SHEET: FIRE	




J2024-0393
PSP2024-003
Revision #2

Received
3/25/2025

City of Rochester
Planning & Economic
Development

CITY FILE #24-0393 SECTION 30

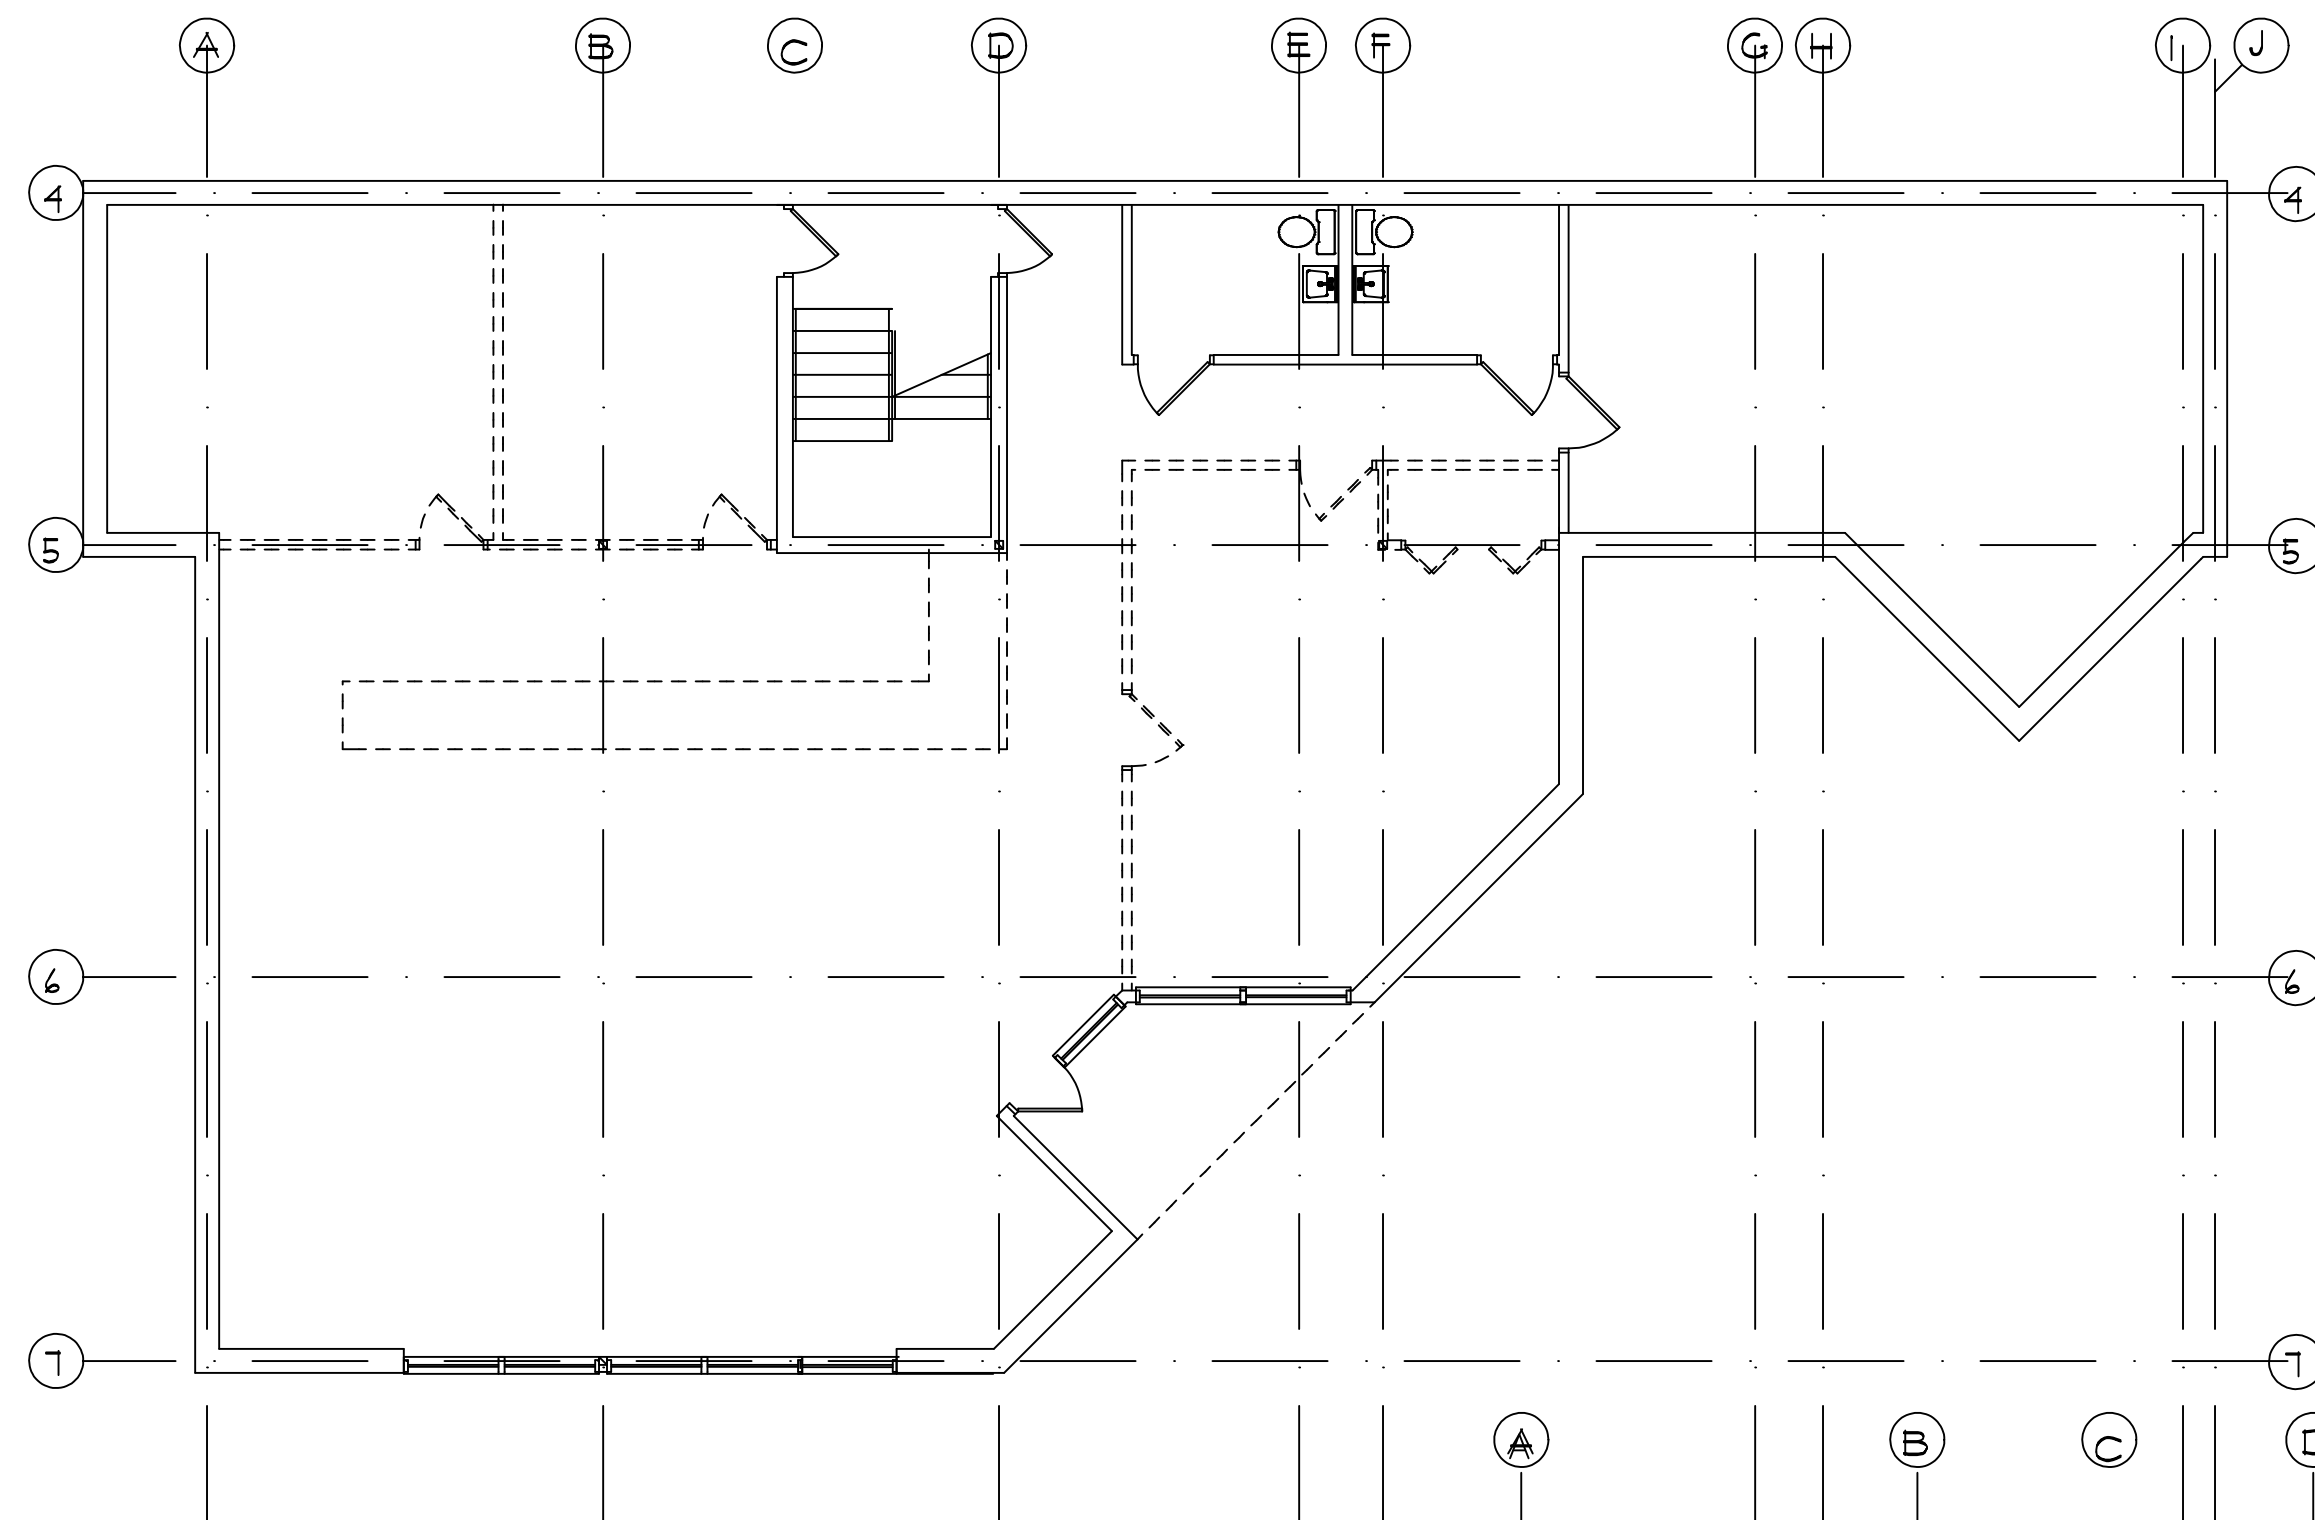

LOWER LEVEL FLOOR PLAN

SCALE: 1/8"=1'-0"

This project is being reviewed under the 2021 Michigan Building Code which goes into effect on April 9, 2025.


CODE EVALUATION

USE GROUP B & S-2
CONSTRUCTION CLASS IIB
BUILDING IS NOT SPRINKLED
ALLOWABLE FLOOR AREA PER TABEL 506.2

USE GROUP CLASSIFICATION

B	23,000 SF ALLOWABLE SF
S-1	11,500 SF ALLOWABLE SF (MOST RESTRICTIVE)
TOTAL SF BUILDING 16,589 SF TOTAL ACTUAL SF	

NO REVISIONS TO EXISTING SITE LIGHTING

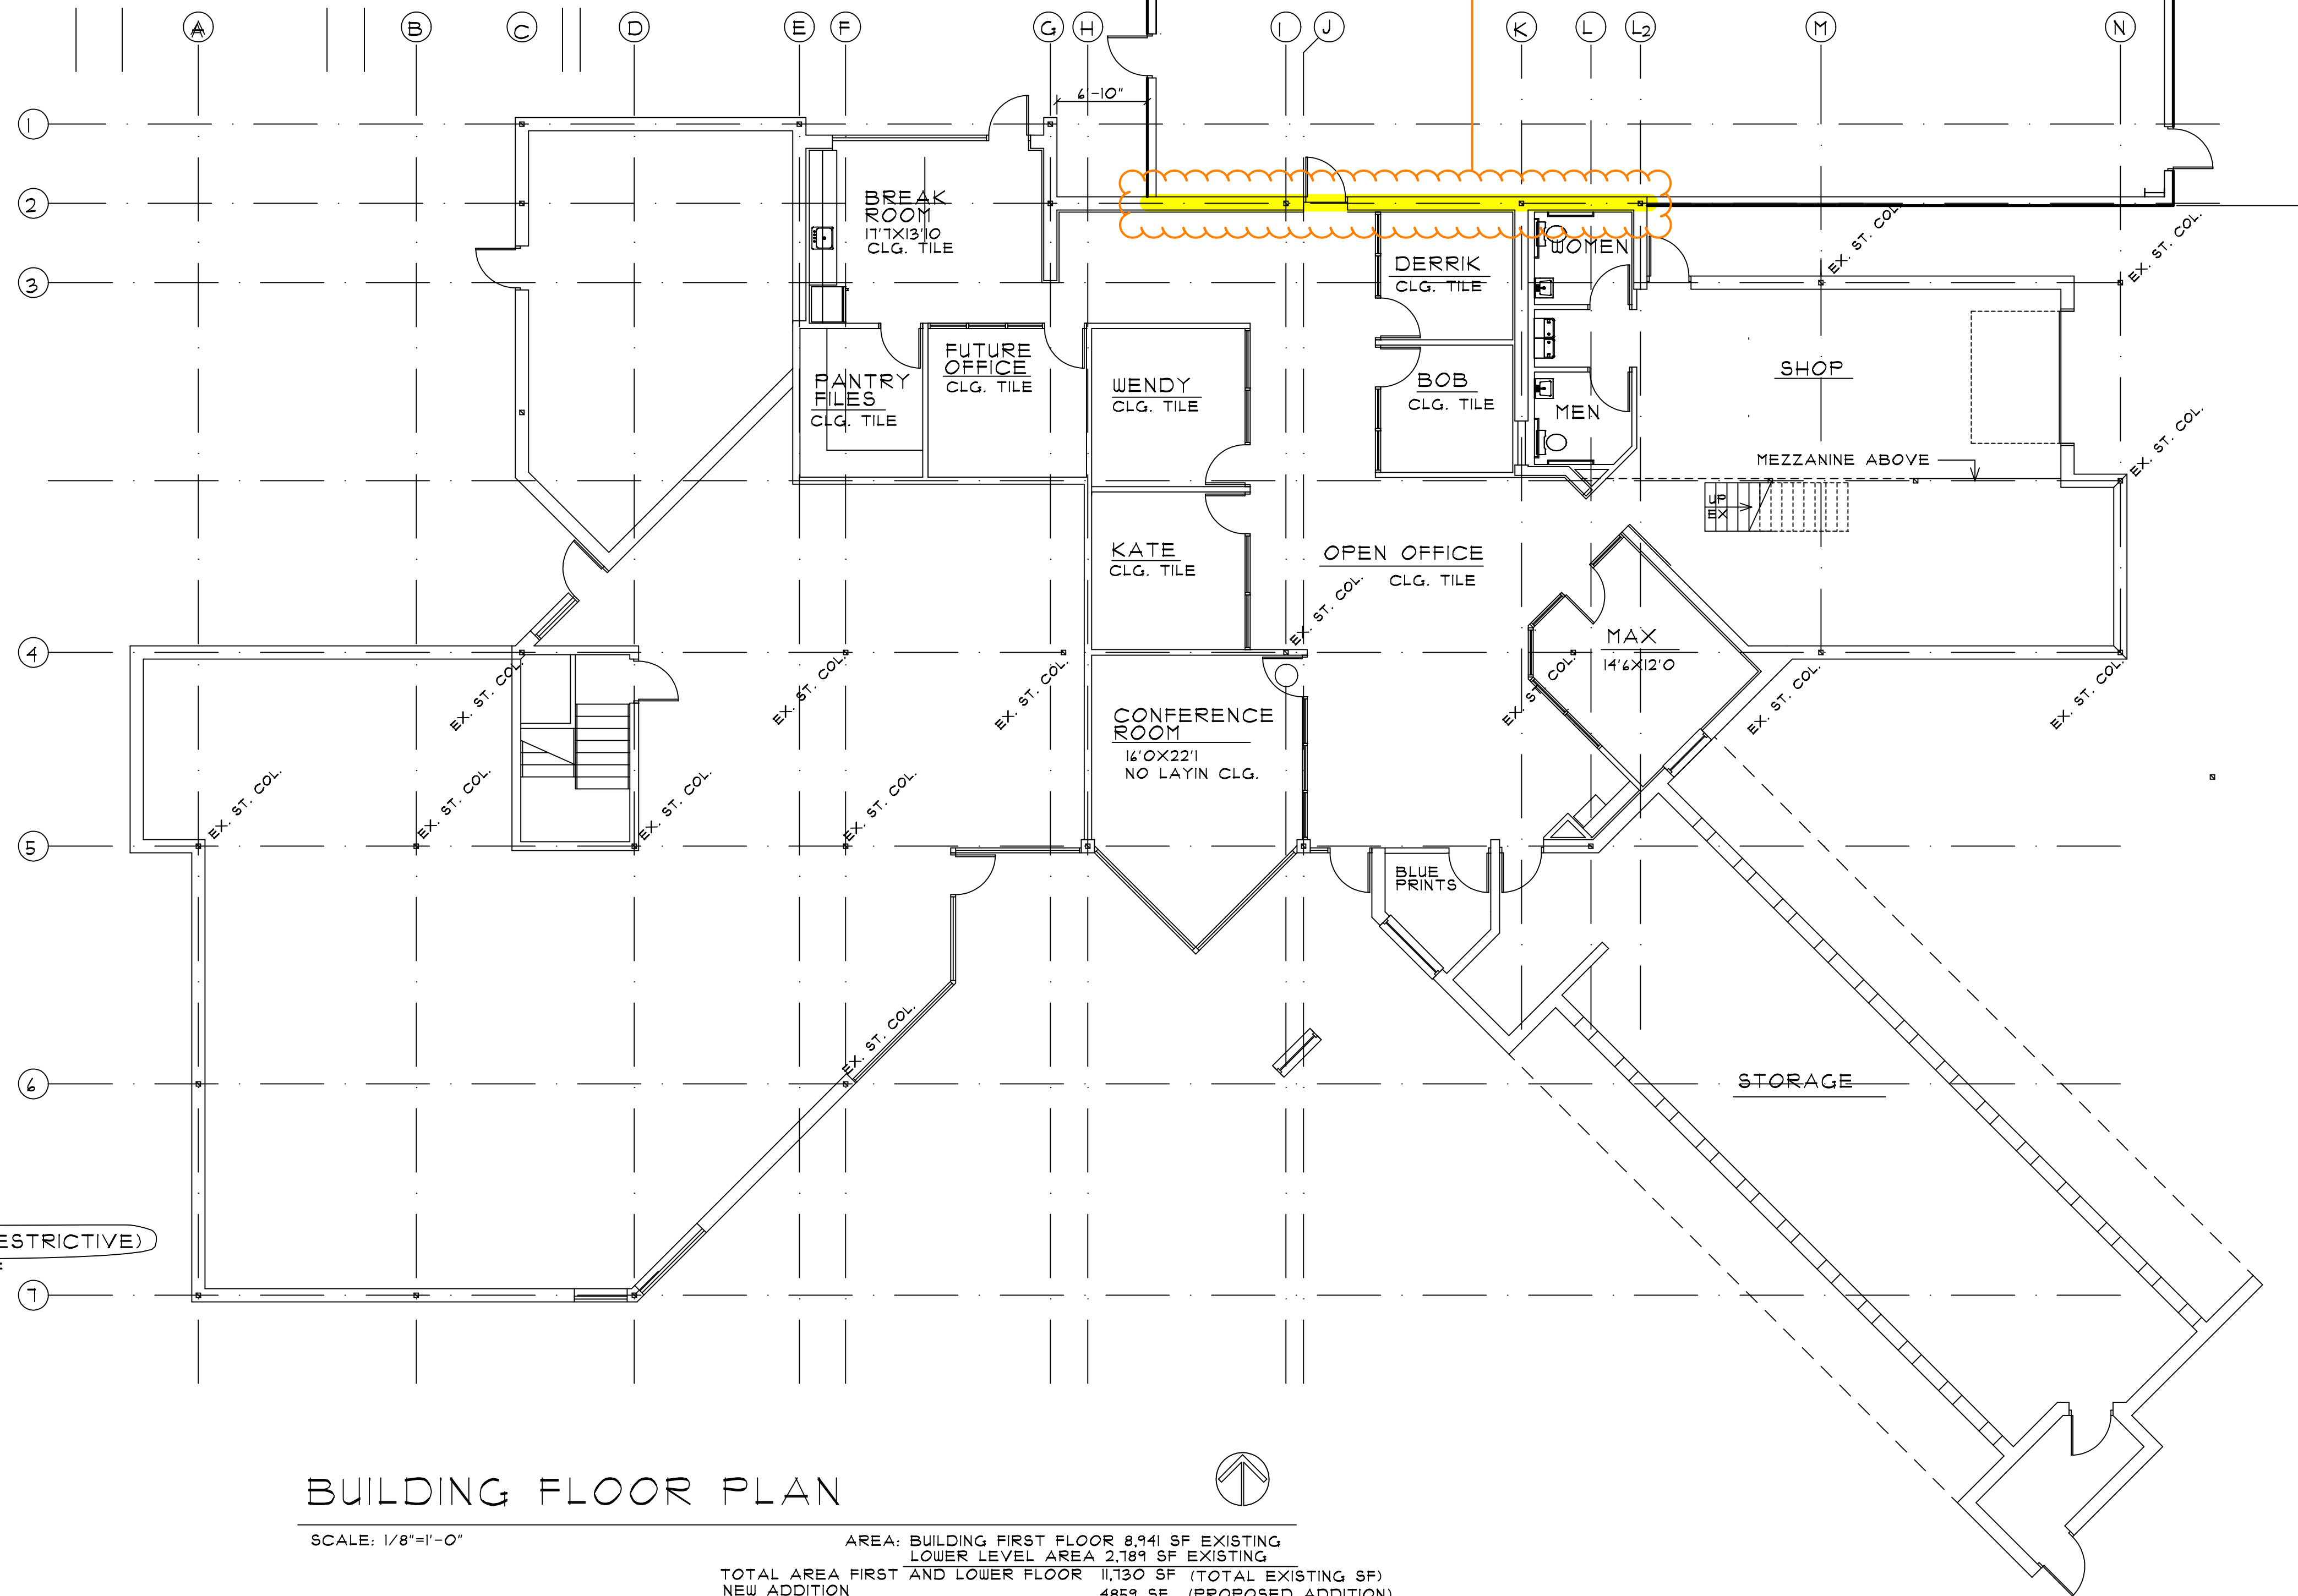

BUILDING FLOOR PLAN

SCALE: 1/8"=1'-0"

AREA: BUILDING FIRST FLOOR 8,941 SF EXISTING
LOWER LEVEL AREA 2,189 SF EXISTING
TOTAL AREA FIRST AND LOWER FLOOR 11,130 SF (TOTAL EXISTING SF)
NEW ADDITION 4859 SF (PROPOSED ADDITION)



A 2 hour fire-resistant separation is required between occupancies per Section 508.3.1.
The fire area of the first floor of the building exceeds the allowable for a S-1 occupancy per Section 903.2.1, item #1, therefore the building shall be sprinklered or the mixed occupancies shall be separated.
If a fire-resistant separation is selected, Table 508.4 indicates no separation requirement between a B and S-1 occupancy. However, there is a 2 hour fire separation required between a B and a less hazardous S-2 occupancy. This Plans Examiner feels this is an inaccuracy in the building code that creates an unsafe conditions for the occupants and the more restrictive separation will be required.



HEINS & KWAPIS
ARCHITECTS P.C.

128 E. THIRD STREET
ROCHESTER, MICHIGAN
48307
PH: 248-651-8766
FAX: 248-651-8969
heinsandkwapis@bogloba.net

PROPOSED
RENOBATION AND ADDITION
3600 W. AUBURN ROAD
CASTLE COMMERCIAL CARPENTRY

3-11-2025
1-17-2025
12-3-2024
4-10-2024
6-6-2024

5-13-2024
4-2-2024

REVISION

DRAWN BY:

CHECKED BY:

3-22-2024

DATE:

SEAL

SHEET NO.

A 100


JOB NUMBER

24-001-C



J2024-0393
PSP2024-0039
Revision #2

Received
3/25/2025
City of Rochester Hills
Planning & Economic
Development

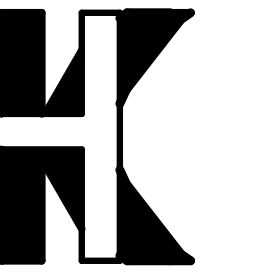

HEINS & KWAPIS
ARCHITECTS P.C.

126 E. THIRD STREET
ROCHESTER, MICHIGAN
48307
PH: 248-651-8788
FAX: 248-651-8989
heinsandkwapis@bogloba.net

PROPOSED
RENOVATION AND ADDITION
3600 W. AUBURN ROAD
CASTLE COMMERCIAL CARPENTRY

3-11-2025
REVISION: 12-3-2024
DRAWN BY:
CHECKED BY:
DATE: 8-22-2024






SEAL

SHEET NO.

A 200

JOB NUMBER

24-001-C

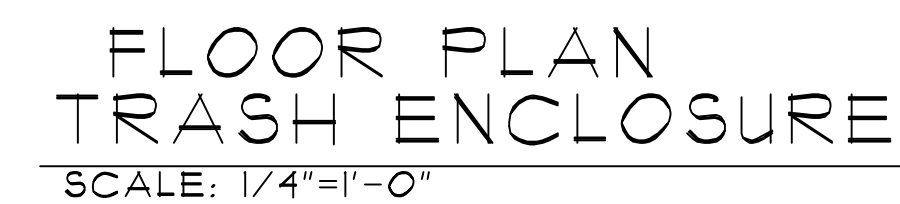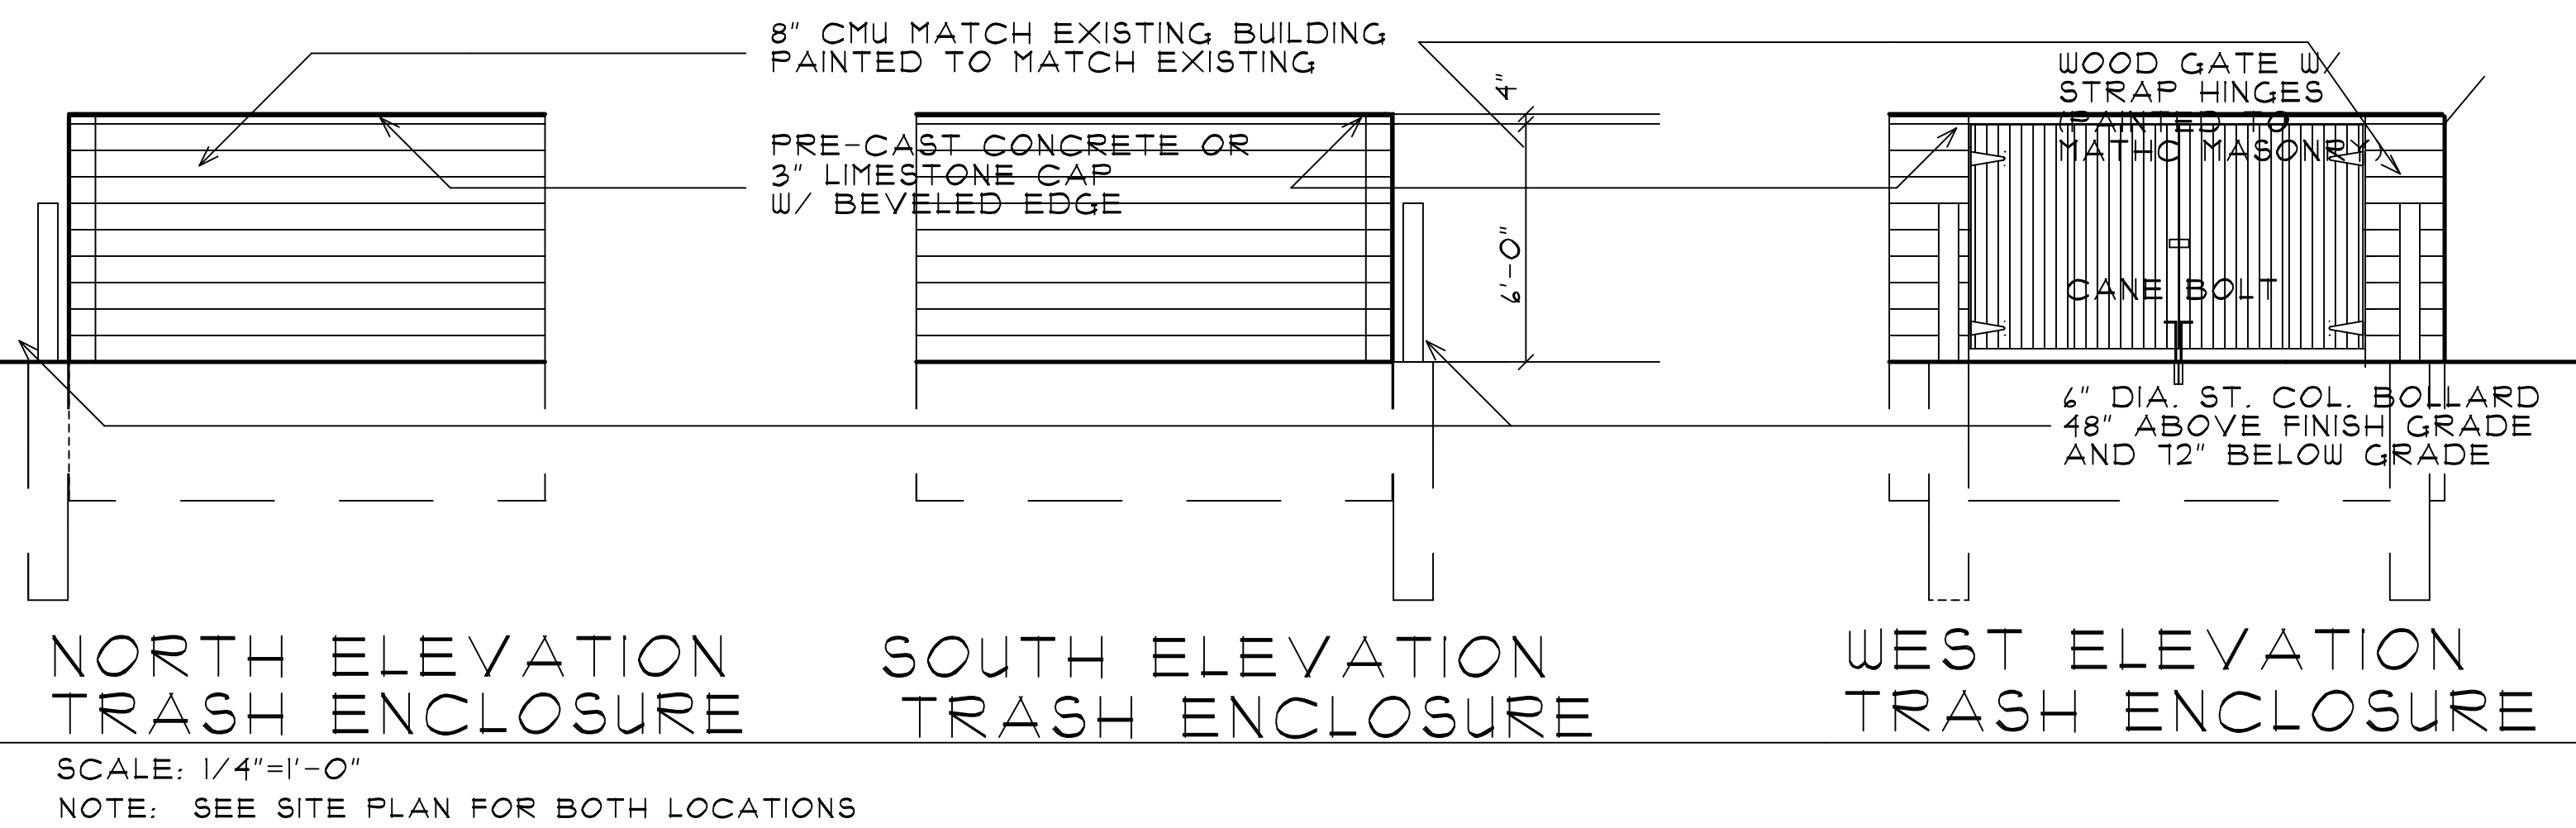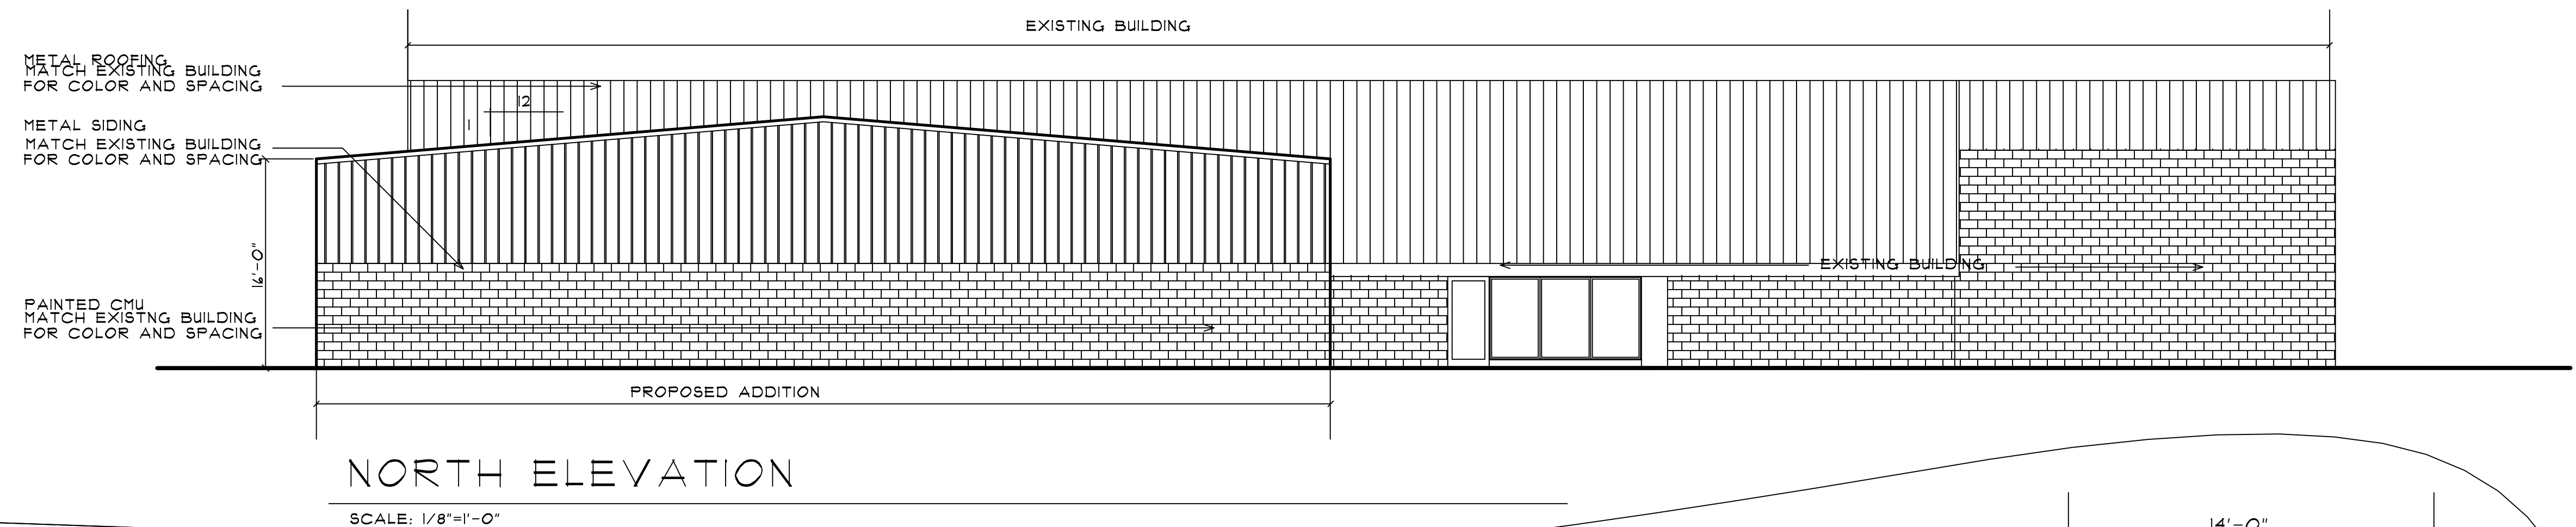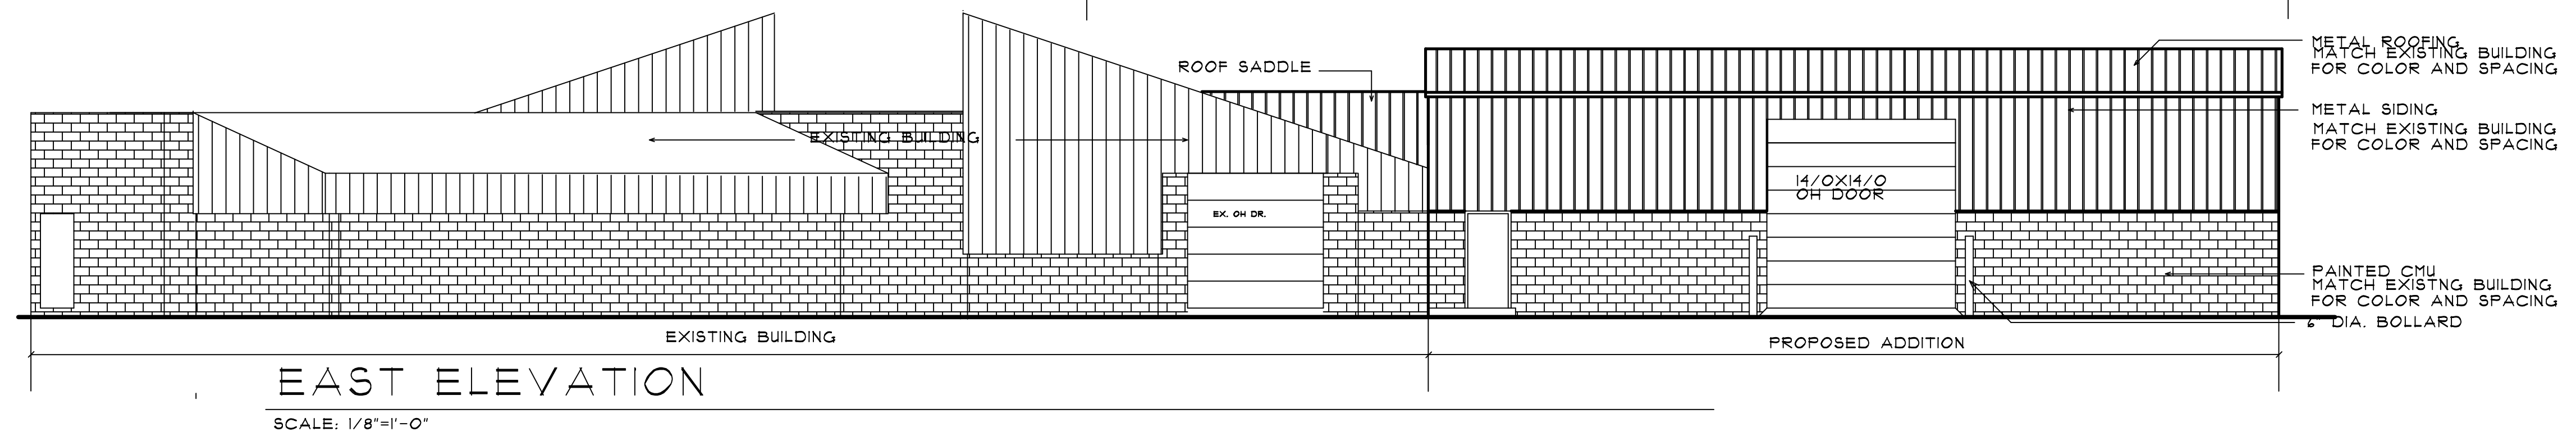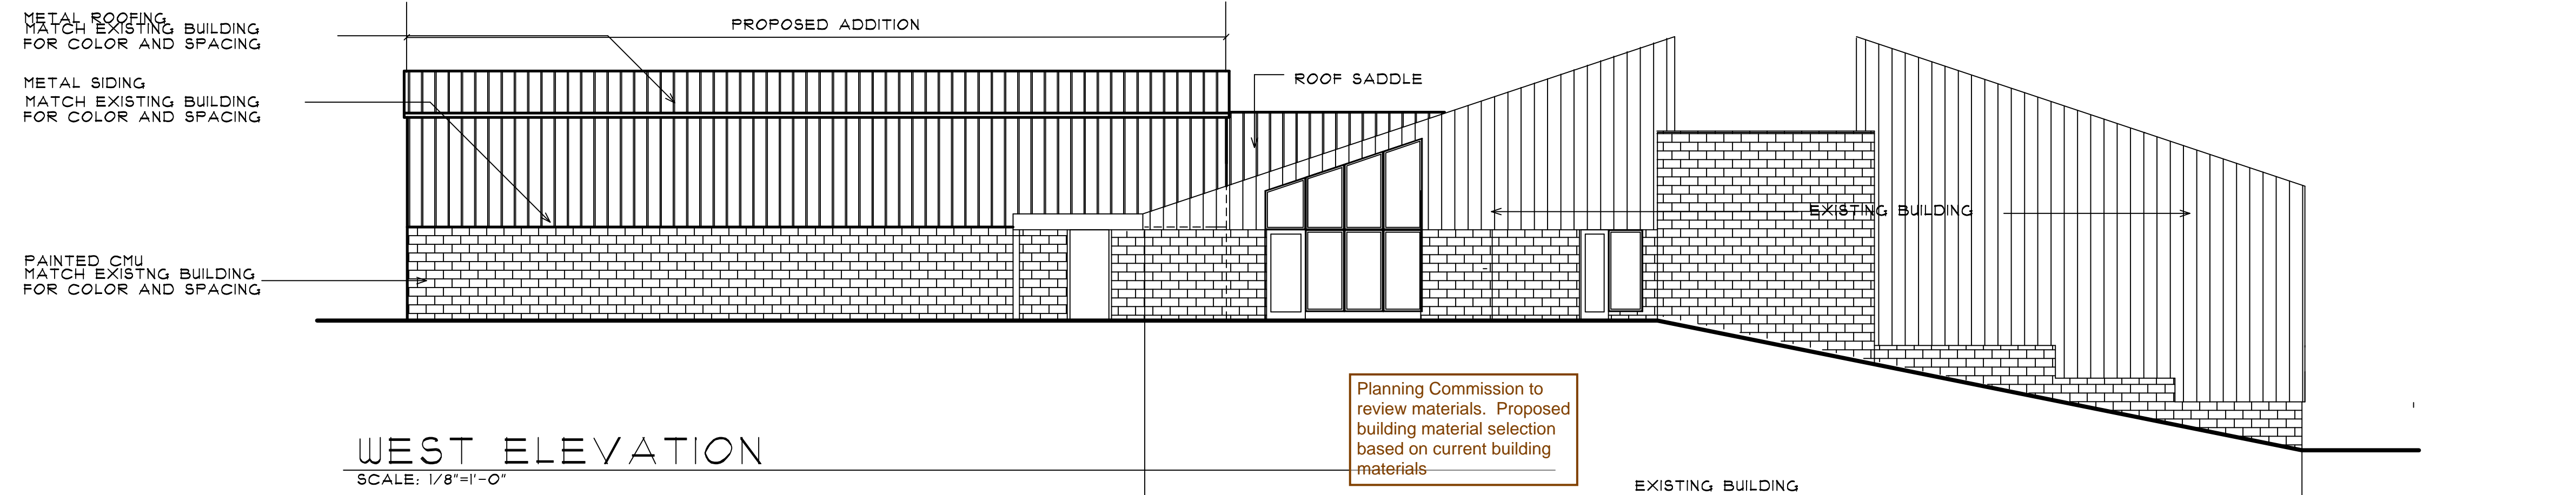

J2024-0393
PSP2024-0039
Revision #2

Received
3/25/2025
City of Rochester Hills
Planning & Economic
Development

Sent Via Email Only

March 26, 2025

Chris McLeod, Planning Manager
Department of Planning and
Economic Development
City of Rochester Hills
1000 Rochester Hills Drive
Rochester Hills, MI 48309-3033

**Subject: 3600 Auburn Road Development
3600 Auburn Road (Sidwell No. 15-30-376-032)
Site Plan Review #1
Site Plans dated March 25, 2025
ASTI File No. A25-1482.08**

Applicant: Auburn Road 3600 LLC

Dear Mr. McLeod:

The above-referenced project proposes to construct and addition to an existing commercial building, a drive extension near the proposed building, and resurface a portion of an existing parking lot on approximately nine acres of land located at 3600 Auburn Road. The site includes one wetland not regulated by the City of Rochester Hills and also not likely regulated by the Michigan Department of Environment, Great Lakes, and Energy (EGLE).

ASTI has reviewed the site plans, dated March 25, 2025 (Current Plans), for conformance to the Wetland and Watercourse Protection Ordinance and the Natural Features Setback Ordinance and offers the following comments for your consideration.

COMMENTS

1. **Applicability of Chapter (§126-500).** The Wetland and Watercourse Protection Ordinance is applicable to the subject site because the subject site is not included within a site plan which has received final approval, or a preliminary subdivision plat which received approval prior to January 17, 1990, which approval remains in effect and in good standing, and the proposed activity has not been previously authorized.
2. **Wetland and Watercourse Determinations (§126-531).** This Section lists specific requirements for completion of a Wetland and Watercourse Boundary Determination.
 - a. This review has been undertaken in the context of a Wetland and Watercourse Boundary Determination completed on-site by ASTI on March 6, 2025. All flagging is shown on the Current Plans with alpha-numeric flagging as placed in the field by ASTI. *The Current Plans do not indicate that ASTI completed the delineation or what date it was completed; this must be shown on revised plans. Revised plans should also show the total wetland area including the open water portion of the wetland (1.5 acres) on all applicable sheets.*

The Applicant should be advised that wetland delineations are only considered valid by the City and EGLE for a period of three years.

- b. One wetland was found on-site as shown on the Current Plans (Wetland A). Wetland A's quality assessments is below.

Wetland A

Wetland A is a forested and emergent/open water wetland. Vegetation within the forested portion of Wetland A was dominated by the common native tree species of box elder, cottonwood, and green ash; the shrub layer was dominated by the non-native species of glossy buckthorn. The herbaceous understory was generally very sparse at the time of the inspection and was dominated by the common native species of eastern wood sedge (*Carex blanda*) and calico aster (*Symphotrichum lateriflorum*) and the non-native species of garlic mustard (*Allaria petiolata*), generally in equal distribution. The tree layer of the forested portion of Wetland A was dominated by common native species; the shrub layer was dominated by non-native species and the herbaceous layer was generally equal in distribution of non-native and native species. Overall, Wetland A was dominated by native wetland species estimated at 65%.

Primary wetland hydrology indicators, such as surface water, a high-water table, soil saturation, and oxidized rhizospheres on living roots were observed throughout Wetland A. Soils within Wetland A were comprised of sandy loams and appeared to be in a natural state. Along with observations of surface water, these hydrological indicators show Wetland A is likely in contact with groundwater to some depth.

Wetland A is isolated and does not extend off-site. Review of historic aerial photography dating to the 1940s indicates Wetland A has been persistent for decades and may be a groundwater recharge wetland. However, Wetland A is very small (1.5 total acres) and, thus, does not likely provide significant wildlife habitat, water filtration (except site-specific), flood protection, or other recognized wetland functions. Based on these factors, it is ASTI's opinion that Wetland A of low ecological quality and function.

3. **Use Permit Required (§126-561).** This Section establishes general parameters for activity requiring permits, as well as limitations on nonconforming activity. This review of the Current Plans has been undertaken in the context of those general parameters, as well as the specific requirements listed below.
 - a. Wetland A is not regulated by the City and likely not regulated by EGLE, because it is isolated and less than two acres in size. The applicant is advised to obtain EGLE concurrence regarding EGLE-regulation prior to impacting Wetland A.
4. **Use Permit Approval Criteria (§126-565).** This Section lists criteria that shall govern the approval or denial of an application for a Wetland and Watercourse Use Permit. The following items must be addressed on a revised and dated Wetland and Watercourse Use Permit application and additional documentation submitted for further review:
 - a. A Wetland and Watercourse Use Permit from the City is not required for this project as proposed on the Current Plans. It is also not likely that a Part 303/301 permit from EGLE will also be required. However, EGLE should be contacted to confirm this assertion. Any applicable permits from EGLE and any other applicable agencies must be obtained by the applicant prior to construction activities.

5. **Natural Features Setback (§21.23).** This Section establishes the general requirements for Natural Features Setbacks and the review criteria for setback reductions and modifications.
- a. All Natural Features Setbacks are shown on the plans to ASTI's satisfaction. The on-site natural features Setbacks were generally of the same low quality ecological character as Wetland A and should be considered to be of low quality and function. Moreover, Wetland A is not regulated by the City and, thus, the Natural Features Setbacks regulations per applicable City ordinances are not applicable to this project as proposed.

RECOMMENDATION

ASTI recommends the City approve the Current Plans on the condition that the items in Comment 2.a are addressed on final plans.

Respectfully submitted,

ASTI ENVIRONMENTAL



Kyle Hottinger
Wetland Ecologist
Professional Wetland Scientist #2927



*Assessment • Remediation • Compliance
Restoration • Incentives*

10448 Citation Drive, Suite 100
Brighton, MI 48116

Phone: 800-395-ASTI
Fax: 810.225.3800

www.asti-env.com

Sent Via Email Only

March 10, 2025

Chris McLeod, Planning Manager
Department of Planning and
Economic Development
City of Rochester Hills
1000 Rochester Hills Drive
Rochester Hills, MI 48309-3033

**Subject: Wetland and Watercourse Boundary Determination
3600 Auburn Road (Sidwell No. 15-30-376-032)
City of Rochester Hills, Oakland County, Michigan
ASTI File No. A25-1482.06**

Applicant: 3600 Auburn Road LLC

Dear Mr. McLeod:

The City of Rochester Hills requested that a Wetland and Watercourse Boundary Determination be completed for the property at 3600 Auburn Road (Sidwell No. 15-30-376-032) located within the City of Rochester Hills, Oakland County, Michigan (Property).

ASTI Environmental (ASTI) completed a Wetland and Watercourse Boundary Determination in accordance with the City of Rochester Hills Wetland and Watercourse Protection Ordinance for the Property on March 6, 2025. One wetland not regulated by the City of Rochester Hills and not likely regulated by the Michigan Department of Environment, Great Lakes, and Energy (EGLE) was observed on the Property (Figure 1 – *Approximate Wetland Boundaries*). ASTI offers the following comments for your consideration.

COMMENTS

1. Wetland and Watercourse Determinations (§ 126-531). This Section lists specific requirements for completion of a Wetland and Watercourse Boundary Determination.

This Determination has been completed in the context of those requirements.

2. Data Used (§ 126-532). This Section lists sources available for use in investigating or determining location, boundaries, and features of watercourses and wetlands.

The United States Geological Survey (USGS) Rochester, Michigan 7.5' Quadrangle Maps, the USDA Web Soil Survey (WSS), the National Wetland Inventory Map (NWI), the EGLE Wetlands Map Viewer website, and digital aerial photographs were all used to support the wetland determination and subsequent regulatory status of ASTI's determination. All reviewed data indicated the presence of wetland in the southern portion of the Property.

The WSS indicates the Property is comprised of the soil complexes of Fox sandy loam (till plain, 2-6% slopes), Thetford loamy fine sand (0-3% slopes), Urban land-Marlette complex (0-8% slopes), and Urban land-Spinks complex (0-8% slopes). According to the WSS, none of these soil complexes are hydric soils.

3. Additional Investigation (§ 126-533). This Section stipulates that the City may request information or documentation as necessary to facilitate determination of watercourse or wetland boundaries in relation to proposed activity.

See Section 4 below.

4. Criteria and Evidence (§ 126-534). This Section lists criteria that shall govern the determination of wetland and watercourse boundaries. A discussion of these criteria, as they apply to the Property, can be found below:

ASTI investigated the Property for the presence of lakes, ponds, wetlands, and watercourses. This work is based on MCL 324 Part 301, Inland Lakes and Streams, Part 303, Wetlands Protection, and the City of Rochester Hills Wetland and Watercourse Protection Ordinance.

The delineation protocol used by ASTI for this delineation is based on the US Army Corps of Engineers' *Wetland Delineation Manual*, 1987, the *Regional Supplement to the Corps of Engineer Wetland Delineation Manual: Midwest Region*, and related guidance/documents, as appropriate. Wetland vegetation, hydrology, and soils were used to locate wetland boundaries.

One wetland was found on the Property as discussed below.

Wetland A

Wetland A is a forested and emergent/open water wetland approximately 1.8 acres in size located in the south-central portion of the Property (Figure 1). Vegetation within the forested portion of Wetland A was dominated by box elder (*Acer negundo*), green ash

(*Fraxinus pennsylvanica*), cottonwood (*Populus deltoides*), and glossy buckthorn (*Frangula alnus*); the remaining portion of Wetland A was comprised of open water (~0.6 acres). Soils within Wetland A were comprised of sandy loams and are considered hydric because criteria for depleted matrix were met. Indicators of wetland hydrology observed within Wetland A included saturated soils, surface water, water-stained leaves, and oxidized rhizospheres on living roots.

Dominant vegetation observed within the upland adjacent to Wetland A included glossy buckthorn, box elder, black cherry (*Prunus serotina*), and honeysuckle (*Lonicera maackii*). Upland soils were comprised of sand loams and loamy sands that did not meet hydric soil criteria. No indicators of wetland hydrology were observed.

It is ASTI's opinion that Wetland A is not regulated by the City under the City's Wetland and Watercourse Protection Ordinance and not likely regulated by EGLE under Part 303 because it is less than two acres in size and is not connected to, or within 500 feet of, an inland lake or stream as defined under Part 301 and Article IV.

Please note that the acreage of Wetland A as detailed in this report and Figure 1 is approximate and that the exact acreage of Wetland A will be determined through a professional survey to be completed by the applicant of the on-site flagging as placed by ASTI in the field. ASTI will review the City-regulatory status of Wetland A based on this survey through review of site plans for the Property as provided to the City by the applicant.

On-site Flagging

Wetland boundaries were marked in the field with pink and black striped flagging and numbered as follows:

Wetland A = A-1 through A-35

Please note all wetland flagging should be located in the field by a professional surveyor to determine the exact on-site acreage of Wetland A.

Wetland and Watercourse Quality Assessments

Wetland A

Wetland A is a forested and emergent/open water wetland. Vegetation within the forested portion of Wetland A was dominated by the common native tree species of box elder, cottonwood, and green ash; the shrub layer was dominated by the non-native species of glossy buckthorn. The herbaceous understory was generally very sparse at the time of the inspection and was dominated by the common native species of eastern wood sedge (*Carex blanda*) and calico aster (*Symphotrichum lateriflorum*) and the non-native species of garlic mustard (*Allaria petiolata*), generally in equal distribution. The tree layer of the forested portion of Wetland A was dominated by common native species; the shrub layer was dominated by non-native species and the herbaceous layer was generally equal in distribution of non-native and native species. Overall, Wetland A was dominated by native wetland species estimated at 60% with significant non-native species inclusions (40%).

Primary wetland hydrology indicators, such as surface water, a high-water table, soil saturation, and oxidized rhizospheres on living roots were observed throughout Wetland A. Soils within Wetland A were comprised of sandy loams and appeared to be in a natural state. Along with observations of surface water, these hydrological indicators show Wetland A is likely in contact with groundwater to some depth.

Wetland A is isolated and does not extend off-site. Review of historic aerial photography dating to the 1940s indicates Wetland A has been persistent for decades and may be a groundwater recharge wetland. However, Wetland A is very small (~1.8 acres) and, thus, does not have the capability of providing significant wildlife habitat, water filtration (except site-specific), flood protection, or other recognized wetland functions. Based on these factors, it is ASTI's opinion that Wetland A is of low ecological quality and function.

SUMMARY

Based upon the data, information, criteria, and evidence noted above, ASTI finds that the Property contains one wetland (Wetland A) that is not regulated by the City under the City's Natural Resource Ordinance, Article IV, Wetland and Watercourse Protection, and not likely to be regulated by EGLE under Part 303, Wetland Protection. Any impacts Wetland A will not require a Wetland Use Permit from the City. However, please note that EGLE has the final authority on the extent of regulated wetlands, lakes, and streams in the State of Michigan. Any proposed impact to the areas that ASTI has identified as unregulated by EGLE should be verified with EGLE prior to any proposed impacts.

Respectfully submitted,

ASTI ENVIRONMENTAL



Kyle A. Hottinger
Wetland Ecologist
Professional Wetland Scientist #2927

Attachments: Figure 1 – Approximate Wetland Boundaries
Completed USACE Wetland Data Sheets



U.S. Army Corps of Engineers WETLAND DETERMINATION DATA SHEET – Midwest Region See ERDC/EL TR-10-16; the proponent agency is CECW-CO-R	OMB Control #: 0710-0024, Exp: 9/30/2027 Requirement Control Symbol EXEMPT: (Authority: AR 335-15, paragraph 5-2a)
--	---

Project/Site: 3600 Auburn Road (Sidwell No. 15-30-376-032) City/County: Rochester Hills-Oakland Co. Sampling Date: 3-6-25
Applicant/Owner: 3600 Auburn Road LLC State: MI Sampling Point: UP1
Investigator(s): ASTI-KAH Section, Township, Range: Sec 30 T3N R11E
Landform (hillside, terrace, etc.): depression Local relief (concave, convex, none): concave
Slope (%): 1-3 Lat: 42.6362 Long: -83.2034 Datum: WGS84
Soil Map Unit Name: Fox sandy loam (till plain, 2-6% slopes) NWI classification: none
Are climatic / hydrologic conditions on the site typical for this time of year? Yes x No (If no, explain in Remarks.)
Are Vegetation , Soil , or Hydrology significantly disturbed? Are "Normal Circumstances" present? Yes x No
Are Vegetation , Soil , or Hydrology naturally problematic? (If needed, explain any answers in Remarks.)

SUMMARY OF FINDINGS – Attach site map showing sampling point locations, transects, important features, etc.

Hydrophytic Vegetation Present? Yes <u>X</u> No <u> </u> Hydric Soil Present? Yes <u> </u> No <u>X</u> Wetland Hydrology Present? Yes <u> </u> No <u>X</u>	Is the Sampled Area within a Wetland? Yes <u> </u> No <u>X</u>
Remarks: Representative conditions in the NE portion of the site.	

VEGETATION – Use scientific names of plants.

<u>Tree Stratum</u> (Plot size: <u>30'</u>) 1. <u>Prunus serotina</u> Absolute % Cover <u>20</u> Dominant Species? <u>Yes</u> Indicator Status <u>FACU</u> 2. <u>Acer negundo</u> <u>20</u> <u>Yes</u> <u>FAC</u> 3. <u> </u> <u> </u> <u> </u> <u> </u> 4. <u> </u> <u> </u> <u> </u> <u> </u> 5. <u> </u> <u> </u> <u> </u> <u> </u> <u>40</u> =Total Cover	Dominance Test worksheet: Number of Dominant Species That Are OBL, FACW, or FAC: <u>4</u> (A) Total Number of Dominant Species Across All Strata: <u>7</u> (B) Percent of Dominant Species That Are OBL, FACW, or FAC: <u>57.1%</u> (A/B)
<u>Sapling/Shrub Stratum</u> (Plot size: <u>15'</u>) 1. <u>Frangula alnus</u> <u>40</u> <u>Yes</u> <u>FACW</u> 2. <u>Lonicera maackii</u> <u>30</u> <u>Yes</u> <u>UPL</u> 3. <u>Prunus serotina</u> <u>10</u> <u>No</u> <u>FACU</u> 4. <u> </u> <u> </u> <u> </u> <u> </u> 5. <u> </u> <u> </u> <u> </u> <u> </u> <u>80</u> =Total Cover	
<u>Herb Stratum</u> (Plot size: <u>5'</u>) 1. <u>Lonicera maackii</u> <u>5</u> <u>Yes</u> <u>UPL</u> 2. <u>Frangula alnus</u> <u>5</u> <u>Yes</u> <u>FACW</u> 3. <u>Alliaria petiolata</u> <u>10</u> <u>Yes</u> <u>FAC</u> 4. <u> </u> <u> </u> <u> </u> <u> </u> 5. <u> </u> <u> </u> <u> </u> <u> </u> 6. <u> </u> <u> </u> <u> </u> <u> </u> 7. <u> </u> <u> </u> <u> </u> <u> </u> 8. <u> </u> <u> </u> <u> </u> <u> </u> 9. <u> </u> <u> </u> <u> </u> <u> </u> 10. <u> </u> <u> </u> <u> </u> <u> </u> <u>20</u> =Total Cover	Prevalence Index worksheet: Total % Cover of: Multiply by: OBL species <u>0</u> x 1 = <u>0</u> FACW species <u>45</u> x 2 = <u>90</u> FAC species <u>30</u> x 3 = <u>90</u> FACU species <u>30</u> x 4 = <u>120</u> UPL species <u>35</u> x 5 = <u>175</u> Column Totals: <u>140</u> (A) <u>475</u> (B) Prevalence Index = B/A = <u>3.39</u>
<u>Woody Vine Stratum</u> (Plot size: <u>15'</u>) 1. <u> </u> <u>0</u> <u> </u> <u> </u> 2. <u> </u> <u> </u> <u> </u> <u> </u> <u> </u> =Total Cover	
Remarks: (Include photo numbers here or on a separate sheet.)	

SOIL

Sampling Point: UP1

Profile Description: (Describe to the depth needed to document the indicator or confirm the absence of indicators.)								
Depth (inches)	Matrix		Redox Features				Texture	Remarks
	Color (moist)	%	Color (moist)	%	Type ¹	Loc ²		
0-12	10YR 5/6	100					Sandy	
12-18	10YR 5/6	90	10YR 4/6	10	C	M	Sandy	Faint redox concentrations

¹Type: C=Concentration, D=Depletion, RM=Reduced Matrix, MS=Masked Sand Grains. ²Location: PL=Pore Lining, M=Matrix.

Hydric Soil Indicators: <input type="checkbox"/> Histosol (A1) <input type="checkbox"/> Histic Epipedon (A2) <input type="checkbox"/> Black Histic (A3) <input type="checkbox"/> Hydrogen Sulfide (A4) <input type="checkbox"/> Stratified Layers (A5) <input type="checkbox"/> 2 cm Muck (A10) <input type="checkbox"/> Depleted Below Dark Surface (A11) <input type="checkbox"/> Thick Dark Surface (A12) <input type="checkbox"/> Iron Monosulfide (A18) <input type="checkbox"/> Sandy Mucky Mineral (S1) <input type="checkbox"/> 5 cm Mucky Peat or Peat (S3)	<input type="checkbox"/> Sandy Gleyed Matrix (S4) <input type="checkbox"/> Sandy Redox (S5) <input type="checkbox"/> Stripped Matrix (S6) <input type="checkbox"/> Dark Surface (S7) <input type="checkbox"/> Loamy Mucky Mineral (F1) <input type="checkbox"/> Loamy Gleyed Matrix (F2) <input type="checkbox"/> Depleted Matrix (F3) <input type="checkbox"/> Redox Dark Surface (F6) <input type="checkbox"/> Depleted Dark Surface (F7) <input type="checkbox"/> Redox Depressions (F8)	Indicators for Problematic Hydric Soils³: <input type="checkbox"/> Iron-Manganese Masses (F12) <input type="checkbox"/> Red Parent Material (F21) <input type="checkbox"/> Very Shallow Dark Surface (F22) <input type="checkbox"/> Other (Explain in Remarks)
--	--	--

³Indicators of hydrophytic vegetation and wetland hydrology must be present, unless disturbed or problematic.

Restrictive Layer (if observed): Type: _____ none Depth (inches): _____	Hydric Soil Present? Yes _____ No <u>X</u>
Remarks:	

HYDROLOGY

Wetland Hydrology Indicators: <u>Primary Indicators (minimum of one is required; check all that apply)</u>				<u>Secondary Indicators (minimum of two required)</u>			
<input type="checkbox"/> Surface Water (A1)	<input type="checkbox"/> Water-Stained Leaves (B9)	<input type="checkbox"/> Surface Soil Cracks (B6)					
<input type="checkbox"/> High Water Table (A2)	<input type="checkbox"/> Aquatic Fauna (B13)	<input type="checkbox"/> Drainage Patterns (B10)					
<input type="checkbox"/> Saturation (A3)	<input type="checkbox"/> True Aquatic Plants (B14)	<input type="checkbox"/> Dry-Season Water Table (C2)					
<input type="checkbox"/> Water Marks (B1)	<input type="checkbox"/> Hydrogen Sulfide Odor (C1)	<input type="checkbox"/> Crayfish Burrows (C8)					
<input type="checkbox"/> Sediment Deposits (B2)	<input type="checkbox"/> Oxidized Rhizospheres on Living Roots (C3)	<input type="checkbox"/> Saturation Visible on Aerial Imagery (C9)					
<input type="checkbox"/> Drift Deposits (B3)	<input type="checkbox"/> Presence of Reduced Iron (C4)	<input type="checkbox"/> Stunted or Stressed Plants (D1)					
<input type="checkbox"/> Algal Mat or Crust (B4)	<input type="checkbox"/> Recent Iron Reduction in Tilled Soils (C6)	<input type="checkbox"/> Geomorphic Position (D2)					
<input type="checkbox"/> Iron Deposits (B5)	<input type="checkbox"/> Thin Muck Surface (C7)	<input type="checkbox"/> FAC-Neutral Test (D5)					
<input type="checkbox"/> Inundation Visible on Aerial Imagery (B7)	<input type="checkbox"/> Gauge or Well Data (D9)						
<input type="checkbox"/> Sparsely Vegetated Concave Surface (B8)	<input type="checkbox"/> Other (Explain in Remarks)						

Field Observations: Surface Water Present? Yes _____ No <u>x</u> Depth (inches): _____ Water Table Present? Yes _____ No <u>x</u> Depth (inches): _____ Saturation Present? Yes _____ No <u>x</u> Depth (inches): _____ (includes capillary fringe)	Wetland Hydrology Present? Yes _____ No <u>X</u>
Remarks:	

Describe Recorded Data (stream gauge, monitoring well, aerial photos, previous inspections), if available:

U.S. Army Corps of Engineers WETLAND DETERMINATION DATA SHEET – Midwest Region See ERDC/EL TR-10-16; the proponent agency is CECW-CO-R	OMB Control #: 0710-0024, Exp: 9/30/2027 Requirement Control Symbol EXEMPT: (Authority: AR 335-15, paragraph 5-2a)
--	---

Project/Site: 3600 Auburn Road (Sidwell No. 15-30-376-032) City/County: Rochester Hills-Oakland Co. Sampling Date: 3-6-25
Applicant/Owner: 3600 Auburn Road LLC State: MI Sampling Point: UP2
Investigator(s): ASTI-KAH Section, Township, Range: Sec 30 T3N R11E
Landform (hillside, terrace, etc.): plain Local relief (concave, convex, none): flat
Slope (%): 1-3 Lat: 42.6360 Long: -83.2044 Datum: WGS84
Soil Map Unit Name: Fox sandy loam (till plain, 2-6% slopes) NWI classification: none
Are climatic / hydrologic conditions on the site typical for this time of year? Yes x No (If no, explain in Remarks.)
Are Vegetation , Soil , or Hydrology significantly disturbed? Are "Normal Circumstances" present? Yes x No
Are Vegetation , Soil , or Hydrology naturally problematic? (If needed, explain any answers in Remarks.)

SUMMARY OF FINDINGS – Attach site map showing sampling point locations, transects, important features, etc.

Hydrophytic Vegetation Present? Yes <u>X</u> No <u> </u> Hydric Soil Present? Yes <u> </u> No <u>X</u> Wetland Hydrology Present? Yes <u> </u> No <u>X</u>	Is the Sampled Area within a Wetland? Yes <u> </u> No <u>X</u>
Remarks: Representative conditions in the north-central portion of the site.	

VEGETATION – Use scientific names of plants.

Tree Stratum (Plot size: <u>30'</u>) 1. <u>Prunus serotina</u> Absolute % Cover <u>10</u> Dominant Species? <u>No</u> Indicator Status <u>FACU</u> 2. <u>Acer negundo</u> <u>30</u> <u>Yes</u> <u>FAC</u> 3. <u>Juglans nigra</u> <u>10</u> <u>No</u> <u>FACU</u> 4. <u>Populus deltoides</u> <u>20</u> <u>Yes</u> <u>FAC</u> 5. <u> </u> <u> </u> <u> </u> <u> </u> 70 =Total Cover	Dominance Test worksheet: Number of Dominant Species That Are OBL, FACW, or FAC: <u>5</u> (A) Total Number of Dominant Species Across All Strata: <u>7</u> (B) Percent of Dominant Species That Are OBL, FACW, or FAC: <u>71.4%</u> (A/B)
Sapling/Shrub Stratum (Plot size: <u>15'</u>) 1. <u>Populus deltoides</u> <u>10</u> <u>No</u> <u>FAC</u> 2. <u>Lonicera maackii</u> <u>40</u> <u>Yes</u> <u>UPL</u> 3. <u>Acer negundo</u> <u>15</u> <u>Yes</u> <u>FAC</u> 4. <u> </u> <u> </u> <u> </u> <u> </u> 5. <u> </u> <u> </u> <u> </u> <u> </u> 65 =Total Cover	
Herb Stratum (Plot size: <u>5'</u>) 1. <u>Rosa multiflora</u> <u>5</u> <u>Yes</u> <u>FACU</u> 2. <u>Carex blanda</u> <u>5</u> <u>Yes</u> <u>FAC</u> 3. <u>Alliaria petiolata</u> <u>5</u> <u>Yes</u> <u>FAC</u> 4. <u> </u> <u> </u> <u> </u> <u> </u> 5. <u> </u> <u> </u> <u> </u> <u> </u> 6. <u> </u> <u> </u> <u> </u> <u> </u> 7. <u> </u> <u> </u> <u> </u> <u> </u> 8. <u> </u> <u> </u> <u> </u> <u> </u> 9. <u> </u> <u> </u> <u> </u> <u> </u> 10. <u> </u> <u> </u> <u> </u> <u> </u> 15 =Total Cover	Prevalence Index worksheet: Total % Cover of: Multiply by: OBL species <u>0</u> x 1 = <u>0</u> FACW species <u>0</u> x 2 = <u>0</u> FAC species <u>85</u> x 3 = <u>255</u> FACU species <u>25</u> x 4 = <u>100</u> UPL species <u>40</u> x 5 = <u>200</u> Column Totals: <u>150</u> (A) <u>555</u> (B) Prevalence Index = B/A = <u>3.70</u>
Woody Vine Stratum (Plot size: <u>15'</u>) 1. <u> </u> <u>0</u> <u> </u> <u> </u> 2. <u> </u> <u> </u> <u> </u> <u> </u> =Total Cover	
Remarks: (Include photo numbers here or on a separate sheet.)	

SOIL

Sampling Point: UP2

Profile Description: (Describe to the depth needed to document the indicator or confirm the absence of indicators.)								
Depth (inches)	Matrix		Redox Features				Texture	Remarks
	Color (moist)	%	Color (moist)	%	Type ¹	Loc ²		
0-5	10YR 4/3	100					Sandy	
5-18	10YR 5/8	95	10YR 4/3	5	C	M	Sandy	Prominent redox concentrations

¹Type: C=Concentration, D=Depletion, RM=Reduced Matrix, MS=Masked Sand Grains. ²Location: PL=Pore Lining, M=Matrix.

Hydric Soil Indicators: <input type="checkbox"/> Histosol (A1) <input type="checkbox"/> Histic Epipedon (A2) <input type="checkbox"/> Black Histic (A3) <input type="checkbox"/> Hydrogen Sulfide (A4) <input type="checkbox"/> Stratified Layers (A5) <input type="checkbox"/> 2 cm Muck (A10) <input type="checkbox"/> Depleted Below Dark Surface (A11) <input type="checkbox"/> Thick Dark Surface (A12) <input type="checkbox"/> Iron Monosulfide (A18) <input type="checkbox"/> Sandy Mucky Mineral (S1) <input type="checkbox"/> 5 cm Mucky Peat or Peat (S3)	<input type="checkbox"/> Sandy Gleyed Matrix (S4) <input type="checkbox"/> Sandy Redox (S5) <input type="checkbox"/> Stripped Matrix (S6) <input type="checkbox"/> Dark Surface (S7) <input type="checkbox"/> Loamy Mucky Mineral (F1) <input type="checkbox"/> Loamy Gleyed Matrix (F2) <input type="checkbox"/> Depleted Matrix (F3) <input type="checkbox"/> Redox Dark Surface (F6) <input type="checkbox"/> Depleted Dark Surface (F7) <input type="checkbox"/> Redox Depressions (F8)	Indicators for Problematic Hydric Soils³: <input type="checkbox"/> Iron-Manganese Masses (F12) <input type="checkbox"/> Red Parent Material (F21) <input type="checkbox"/> Very Shallow Dark Surface (F22) <input type="checkbox"/> Other (Explain in Remarks)
--	--	--

³Indicators of hydrophytic vegetation and wetland hydrology must be present, unless disturbed or problematic.

Restrictive Layer (if observed): Type: _____ none Depth (inches): _____	Hydric Soil Present? Yes _____ No <u>X</u>
Remarks:	

HYDROLOGY

Wetland Hydrology Indicators: <u>Primary Indicators (minimum of one is required; check all that apply)</u>				<u>Secondary Indicators (minimum of two required)</u>			
<input type="checkbox"/> Surface Water (A1)	<input type="checkbox"/> Water-Stained Leaves (B9)	<input type="checkbox"/> Surface Soil Cracks (B6)					
<input type="checkbox"/> High Water Table (A2)	<input type="checkbox"/> Aquatic Fauna (B13)	<input type="checkbox"/> Drainage Patterns (B10)					
<input type="checkbox"/> Saturation (A3)	<input type="checkbox"/> True Aquatic Plants (B14)	<input type="checkbox"/> Dry-Season Water Table (C2)					
<input type="checkbox"/> Water Marks (B1)	<input type="checkbox"/> Hydrogen Sulfide Odor (C1)	<input type="checkbox"/> Crayfish Burrows (C8)					
<input type="checkbox"/> Sediment Deposits (B2)	<input type="checkbox"/> Oxidized Rhizospheres on Living Roots (C3)	<input type="checkbox"/> Saturation Visible on Aerial Imagery (C9)					
<input type="checkbox"/> Drift Deposits (B3)	<input type="checkbox"/> Presence of Reduced Iron (C4)	<input type="checkbox"/> Stunted or Stressed Plants (D1)					
<input type="checkbox"/> Algal Mat or Crust (B4)	<input type="checkbox"/> Recent Iron Reduction in Tilled Soils (C6)	<input type="checkbox"/> Geomorphic Position (D2)					
<input type="checkbox"/> Iron Deposits (B5)	<input type="checkbox"/> Thin Muck Surface (C7)	<input type="checkbox"/> FAC-Neutral Test (D5)					
<input type="checkbox"/> Inundation Visible on Aerial Imagery (B7)	<input type="checkbox"/> Gauge or Well Data (D9)						
<input type="checkbox"/> Sparsely Vegetated Concave Surface (B8)	<input type="checkbox"/> Other (Explain in Remarks)						

Field Observations: Surface Water Present? Yes _____ No <u>x</u> Depth (inches): _____ Water Table Present? Yes _____ No <u>x</u> Depth (inches): _____ Saturation Present? Yes _____ No <u>x</u> Depth (inches): _____ (includes capillary fringe)	Wetland Hydrology Present? Yes _____ No <u>X</u>
Remarks:	

Describe Recorded Data (stream gauge, monitoring well, aerial photos, previous inspections), if available:

U.S. Army Corps of Engineers WETLAND DETERMINATION DATA SHEET – Midwest Region See ERDC/EL TR-10-16; the proponent agency is CECW-CO-R	OMB Control #: 0710-0024, Exp: 9/30/2027 Requirement Control Symbol EXEMPT: (Authority: AR 335-15, paragraph 5-2a)
--	---

Project/Site: 3600 Auburn Road (Sidwell No. 15-30-376-032) City/County: Rochester Hills-Oakland Co. Sampling Date: 3-6-25
Applicant/Owner: 3600 Auburn Road LLC State: MI Sampling Point: UP3
Investigator(s): ASTI-KAH Section, Township, Range: Sec 30 T3N R11E
Landform (hillside, terrace, etc.): slope Local relief (concave, convex, none): slope
Slope (%): 3-5 Lat: 42.6351 Long: -83.2043 Datum: WGS84
Soil Map Unit Name: Thetford loamy fine sand (0-3% slopes) NWI classification: none
Are climatic / hydrologic conditions on the site typical for this time of year? Yes x No (If no, explain in Remarks.)
Are Vegetation , Soil , or Hydrology significantly disturbed? Are "Normal Circumstances" present? Yes x No
Are Vegetation , Soil , or Hydrology naturally problematic? (If needed, explain any answers in Remarks.)

SUMMARY OF FINDINGS – Attach site map showing sampling point locations, transects, important features, etc.

Hydrophytic Vegetation Present? Yes <u>X</u> No <u> </u> Hydric Soil Present? Yes <u> </u> No <u>X</u> Wetland Hydrology Present? Yes <u> </u> No <u>X</u>	Is the Sampled Area within a Wetland? Yes <u> </u> No <u>X</u>
Remarks: Representative conditions adjacent to Wetland A in the west-central portion of the site.	

VEGETATION – Use scientific names of plants.

<u>Tree Stratum</u> (Plot size: <u>30'</u>) 1. <u>Prunus serotina</u> Absolute % Cover <u>30</u> Dominant Species? <u>Yes</u> Indicator Status <u>FACU</u> 2. <u>Acer negundo</u> <u>30</u> <u>Yes</u> <u>FAC</u> 3. <u>Populus deltoides</u> <u>15</u> <u>Yes</u> <u>FAC</u> 4. <u> </u> <u> </u> <u> </u> <u> </u> 5. <u> </u> <u> </u> <u> </u> <u> </u> <u>75</u> =Total Cover	Dominance Test worksheet: Number of Dominant Species That Are OBL, FACW, or FAC: <u>5</u> (A) Total Number of Dominant Species Across All Strata: <u>8</u> (B) Percent of Dominant Species That Are OBL, FACW, or FAC: <u>62.5%</u> (A/B)
<u>Sapling/Shrub Stratum</u> (Plot size: <u>15'</u>) 1. <u>Prunus serotina</u> <u>10</u> <u>No</u> <u>FACU</u> 2. <u>Lonicera maackii</u> <u>20</u> <u>Yes</u> <u>UPL</u> 3. <u>Acer negundo</u> <u>10</u> <u>No</u> <u>FAC</u> 4. <u>Frangula alnus</u> <u>20</u> <u>Yes</u> <u>FACW</u> 5. <u> </u> <u> </u> <u> </u> <u> </u> <u>60</u> =Total Cover	
<u>Herb Stratum</u> (Plot size: <u>5'</u>) 1. <u>Lonicera maackii</u> <u>10</u> <u>Yes</u> <u>UPL</u> 2. <u>Geum canadense</u> <u>5</u> <u>Yes</u> <u>FAC</u> 3. <u>Alliaria petiolata</u> <u>10</u> <u>Yes</u> <u>FAC</u> 4. <u> </u> <u> </u> <u> </u> <u> </u> 5. <u> </u> <u> </u> <u> </u> <u> </u> 6. <u> </u> <u> </u> <u> </u> <u> </u> 7. <u> </u> <u> </u> <u> </u> <u> </u> 8. <u> </u> <u> </u> <u> </u> <u> </u> 9. <u> </u> <u> </u> <u> </u> <u> </u> 10. <u> </u> <u> </u> <u> </u> <u> </u> <u>25</u> =Total Cover	Prevalence Index worksheet: Total % Cover of: Multiply by: OBL species <u>0</u> x 1 = <u>0</u> FACW species <u>20</u> x 2 = <u>40</u> FAC species <u>70</u> x 3 = <u>210</u> FACU species <u>40</u> x 4 = <u>160</u> UPL species <u>30</u> x 5 = <u>150</u> Column Totals: <u>160</u> (A) <u>560</u> (B) Prevalence Index = B/A = <u>3.50</u>
<u>Woody Vine Stratum</u> (Plot size: <u>15'</u>) 1. <u> </u> <u>0</u> <u> </u> <u> </u> 2. <u> </u> <u> </u> <u> </u> <u> </u> <u> </u> =Total Cover	Hydrophytic Vegetation Indicators: <u> </u> 1 - Rapid Test for Hydrophytic Vegetation <u>X</u> 2 - Dominance Test is >50% <u> </u> 3 - Prevalence Index is ≤3.0 ¹ <u> </u> 4 - Morphological Adaptations ¹ (Provide supporting data in Remarks or on a separate sheet) <u> </u> Problematic Hydrophytic Vegetation ¹ (Explain) ¹ Indicators of hydric soil and wetland hydrology must be present, unless disturbed or problematic.
Remarks: (Include photo numbers here or on a separate sheet.)	Hydrophytic Vegetation Present? Yes <u>X</u> No <u> </u>

SOIL

Sampling Point: UP3

Profile Description: (Describe to the depth needed to document the indicator or confirm the absence of indicators.)								
Depth (inches)	Matrix		Redox Features				Texture	Remarks
	Color (moist)	%	Color (moist)	%	Type ¹	Loc ²		
0-5	10YR 4/3	100					Sandy	
5-18	10YR 6/8	80	10YR 4/3	20	C	M	Sandy	Prominent redox concentrations

¹Type: C=Concentration, D=Depletion, RM=Reduced Matrix, MS=Masked Sand Grains. ²Location: PL=Pore Lining, M=Matrix.

Hydric Soil Indicators:	Indicators for Problematic Hydric Soils ³ :
<input type="checkbox"/> Histosol (A1)	<input type="checkbox"/> Iron-Manganese Masses (F12)
<input type="checkbox"/> Histic Epipedon (A2)	<input type="checkbox"/> Red Parent Material (F21)
<input type="checkbox"/> Black Histic (A3)	<input type="checkbox"/> Very Shallow Dark Surface (F22)
<input type="checkbox"/> Hydrogen Sulfide (A4)	<input type="checkbox"/> Other (Explain in Remarks)
<input type="checkbox"/> Stratified Layers (A5)	
<input type="checkbox"/> 2 cm Muck (A10)	
<input type="checkbox"/> Depleted Below Dark Surface (A11)	
<input type="checkbox"/> Thick Dark Surface (A12)	
<input type="checkbox"/> Iron Monosulfide (A18)	
<input type="checkbox"/> Sandy Mucky Mineral (S1)	
<input type="checkbox"/> 5 cm Mucky Peat or Peat (S3)	

³Indicators of hydrophytic vegetation and wetland hydrology must be present, unless disturbed or problematic.

Restrictive Layer (if observed): Type: _____ none _____ Depth (inches): _____	Hydric Soil Present? Yes _____ No <u>X</u>
Remarks:	

HYDROLOGY

Wetland Hydrology Indicators:			
Primary Indicators (minimum of one is required; check all that apply)		Secondary Indicators (minimum of two required)	
<input type="checkbox"/> Surface Water (A1)	<input type="checkbox"/> Water-Stained Leaves (B9)	<input type="checkbox"/> Surface Soil Cracks (B6)	
<input type="checkbox"/> High Water Table (A2)	<input type="checkbox"/> Aquatic Fauna (B13)	<input type="checkbox"/> Drainage Patterns (B10)	
<input type="checkbox"/> Saturation (A3)	<input type="checkbox"/> True Aquatic Plants (B14)	<input type="checkbox"/> Dry-Season Water Table (C2)	
<input type="checkbox"/> Water Marks (B1)	<input type="checkbox"/> Hydrogen Sulfide Odor (C1)	<input type="checkbox"/> Crayfish Burrows (C8)	
<input type="checkbox"/> Sediment Deposits (B2)	<input type="checkbox"/> Oxidized Rhizospheres on Living Roots (C3)	<input type="checkbox"/> Saturation Visible on Aerial Imagery (C9)	
<input type="checkbox"/> Drift Deposits (B3)	<input type="checkbox"/> Presence of Reduced Iron (C4)	<input type="checkbox"/> Stunted or Stressed Plants (D1)	
<input type="checkbox"/> Algal Mat or Crust (B4)	<input type="checkbox"/> Recent Iron Reduction in Tilled Soils (C6)	<input type="checkbox"/> Geomorphic Position (D2)	
<input type="checkbox"/> Iron Deposits (B5)	<input type="checkbox"/> Thin Muck Surface (C7)	<input type="checkbox"/> FAC-Neutral Test (D5)	
<input type="checkbox"/> Inundation Visible on Aerial Imagery (B7)	<input type="checkbox"/> Gauge or Well Data (D9)		
<input type="checkbox"/> Sparsely Vegetated Concave Surface (B8)	<input type="checkbox"/> Other (Explain in Remarks)		

Field Observations: Surface Water Present? Yes _____ No <u>x</u> Depth (inches): _____ Water Table Present? Yes _____ No <u>x</u> Depth (inches): _____ Saturation Present? Yes _____ No <u>x</u> Depth (inches): _____ (includes capillary fringe)	Wetland Hydrology Present? Yes _____ No <u>X</u>
Remarks:	

Describe Recorded Data (stream gauge, monitoring well, aerial photos, previous inspections), if available:

U.S. Army Corps of Engineers WETLAND DETERMINATION DATA SHEET – Midwest Region See ERDC/EL TR-10-16; the proponent agency is CECW-CO-R	OMB Control #: 0710-0024, Exp: 9/30/2027 Requirement Control Symbol EXEMPT: (Authority: AR 335-15, paragraph 5-2a)
--	---

Project/Site: 3600 Auburn Road (Sidwell No. 15-30-376-032) City/County: Rochester Hills-Oakland Co. Sampling Date: 3-6-25
Applicant/Owner: 3600 Auburn Road LLC State: MI Sampling Point: UP4
Investigator(s): ASTI-KAH Section, Township, Range: Sec 30 T3N R11E
Landform (hillside, terrace, etc.): plain Local relief (concave, convex, none): flat
Slope (%): 1-3 Lat: 42.6351 Long: -83.2043 Datum: WGS84
Soil Map Unit Name: Urban land-Spinks complex (0-8% slopes) NWI classification: none
Are climatic / hydrologic conditions on the site typical for this time of year? Yes x No (If no, explain in Remarks.)
Are Vegetation , Soil , or Hydrology significantly disturbed? Are "Normal Circumstances" present? Yes x No
Are Vegetation , Soil , or Hydrology naturally problematic? (If needed, explain any answers in Remarks.)

SUMMARY OF FINDINGS – Attach site map showing sampling point locations, transects, important features, etc.

Hydrophytic Vegetation Present? Yes <u> </u> No <u>X</u> Hydric Soil Present? Yes <u> </u> No <u>X</u> Wetland Hydrology Present? Yes <u> </u> No <u>X</u>	Is the Sampled Area within a Wetland? Yes <u> </u> No <u>X</u>
Remarks: Conditions adjacent to Wetland A in the SW portion of the site.	

VEGETATION – Use scientific names of plants.

<u>Tree Stratum</u> (Plot size: <u>30'</u>) 1. <u>Prunus serotina</u> Absolute % Cover <u>10</u> Dominant Species? <u>Yes</u> Indicator Status <u>FACU</u> 2. <u>Pinus sylvestris</u> <u>15</u> <u>Yes</u> <u>UPL</u> 3. <u> </u> <u> </u> <u> </u> <u> </u> 4. <u> </u> <u> </u> <u> </u> <u> </u> 5. <u> </u> <u> </u> <u> </u> <u> </u> <u>25</u> =Total Cover	Dominance Test worksheet: Number of Dominant Species That Are OBL, FACW, or FAC: <u>3</u> (A) Total Number of Dominant Species Across All Strata: <u>6</u> (B) Percent of Dominant Species That Are OBL, FACW, or FAC: <u>50.0%</u> (A/B)
<u>Sapling/Shrub Stratum</u> (Plot size: <u>15'</u>) 1. <u>Prunus serotina</u> <u>10</u> <u>No</u> <u>FACU</u> 2. <u>Lonicera maackii</u> <u>10</u> <u>No</u> <u>UPL</u> 3. <u>Frangula alnus</u> <u>60</u> <u>Yes</u> <u>FACW</u> 4. <u> </u> <u> </u> <u> </u> <u> </u> 5. <u> </u> <u> </u> <u> </u> <u> </u> <u>80</u> =Total Cover	
<u>Herb Stratum</u> (Plot size: <u>5'</u>) 1. <u>Lonicera maackii</u> <u>10</u> <u>Yes</u> <u>UPL</u> 2. <u>Frangula alnus</u> <u>5</u> <u>Yes</u> <u>FACW</u> 3. <u>Alliaria petiolata</u> <u>10</u> <u>Yes</u> <u>FAC</u> 4. <u> </u> <u> </u> <u> </u> <u> </u> 5. <u> </u> <u> </u> <u> </u> <u> </u> 6. <u> </u> <u> </u> <u> </u> <u> </u> 7. <u> </u> <u> </u> <u> </u> <u> </u> 8. <u> </u> <u> </u> <u> </u> <u> </u> 9. <u> </u> <u> </u> <u> </u> <u> </u> 10. <u> </u> <u> </u> <u> </u> <u> </u> <u>25</u> =Total Cover	
<u>Woody Vine Stratum</u> (Plot size: <u>15'</u>) 1. <u> </u> <u>0</u> <u> </u> <u> </u> 2. <u> </u> <u> </u> <u> </u> <u> </u> <u> </u> =Total Cover	Prevalence Index worksheet: Total % Cover of: Multiply by: OBL species <u>0</u> x 1 = <u>0</u> FACW species <u>65</u> x 2 = <u>130</u> FAC species <u>10</u> x 3 = <u>30</u> FACU species <u>20</u> x 4 = <u>80</u> UPL species <u>35</u> x 5 = <u>175</u> Column Totals: <u>130</u> (A) <u>415</u> (B) Prevalence Index = B/A = <u>3.19</u>
Hydrophytic Vegetation Indicators: <u> </u> 1 - Rapid Test for Hydrophytic Vegetation <u> </u> 2 - Dominance Test is >50% <u> </u> 3 - Prevalence Index is ≤3.0 ¹ <u> </u> 4 - Morphological Adaptations ¹ (Provide supporting data in Remarks or on a separate sheet) <u> </u> Problematic Hydrophytic Vegetation ¹ (Explain) ¹ Indicators of hydric soil and wetland hydrology must be present, unless disturbed or problematic.	
Hydrophytic Vegetation Present? Yes <u> </u> No <u>X</u>	
Remarks: (Include photo numbers here or on a separate sheet.)	

SOIL

Sampling Point: UP4

Profile Description: (Describe to the depth needed to document the indicator or confirm the absence of indicators.)								
Depth (inches)	Matrix		Redox Features				Texture	Remarks
	Color (moist)	%	Color (moist)	%	Type ¹	Loc ²		
0-17	10YR 3/2	100					Sandy	
17-19	10YR 3/2	80	10YR 7/8	20	C	M	Sandy	Prominent redox concentrations

¹Type: C=Concentration, D=Depletion, RM=Reduced Matrix, MS=Masked Sand Grains. ²Location: PL=Pore Lining, M=Matrix.

Hydric Soil Indicators: <input type="checkbox"/> Histosol (A1) <input type="checkbox"/> Histic Epipedon (A2) <input type="checkbox"/> Black Histic (A3) <input type="checkbox"/> Hydrogen Sulfide (A4) <input type="checkbox"/> Stratified Layers (A5) <input type="checkbox"/> 2 cm Muck (A10) <input type="checkbox"/> Depleted Below Dark Surface (A11) <input type="checkbox"/> Thick Dark Surface (A12) <input type="checkbox"/> Iron Monosulfide (A18) <input type="checkbox"/> Sandy Mucky Mineral (S1) <input type="checkbox"/> 5 cm Mucky Peat or Peat (S3)	<input type="checkbox"/> Sandy Gleyed Matrix (S4) <input type="checkbox"/> Sandy Redox (S5) <input type="checkbox"/> Stripped Matrix (S6) <input type="checkbox"/> Dark Surface (S7) <input type="checkbox"/> Loamy Mucky Mineral (F1) <input type="checkbox"/> Loamy Gleyed Matrix (F2) <input type="checkbox"/> Depleted Matrix (F3) <input type="checkbox"/> Redox Dark Surface (F6) <input type="checkbox"/> Depleted Dark Surface (F7) <input type="checkbox"/> Redox Depressions (F8)
--	--

Indicators for Problematic Hydric Soils³:
☐ Iron-Manganese Masses (F12)
☐ Red Parent Material (F21)
☐ Very Shallow Dark Surface (F22)
☐ Other (Explain in Remarks)

³Indicators of hydrophytic vegetation and wetland hydrology must be present, unless disturbed or problematic.

Restrictive Layer (if observed): Type: _____ none _____ Depth (inches): _____	Hydric Soil Present? Yes _____ No <u>X</u>
Remarks:	

HYDROLOGY

Wetland Hydrology Indicators: <u>Primary Indicators (minimum of one is required; check all that apply)</u>				<u>Secondary Indicators (minimum of two required)</u>			
<input type="checkbox"/> Surface Water (A1)	<input type="checkbox"/> Water-Stained Leaves (B9)	<input type="checkbox"/> Surface Soil Cracks (B6)					
<input type="checkbox"/> High Water Table (A2)	<input type="checkbox"/> Aquatic Fauna (B13)	<input type="checkbox"/> Drainage Patterns (B10)					
<input type="checkbox"/> Saturation (A3)	<input type="checkbox"/> True Aquatic Plants (B14)	<input type="checkbox"/> Dry-Season Water Table (C2)					
<input type="checkbox"/> Water Marks (B1)	<input type="checkbox"/> Hydrogen Sulfide Odor (C1)	<input type="checkbox"/> Crayfish Burrows (C8)					
<input type="checkbox"/> Sediment Deposits (B2)	<input type="checkbox"/> Oxidized Rhizospheres on Living Roots (C3)	<input type="checkbox"/> Saturation Visible on Aerial Imagery (C9)					
<input type="checkbox"/> Drift Deposits (B3)	<input type="checkbox"/> Presence of Reduced Iron (C4)	<input type="checkbox"/> Stunted or Stressed Plants (D1)					
<input type="checkbox"/> Algal Mat or Crust (B4)	<input type="checkbox"/> Recent Iron Reduction in Tilled Soils (C6)	<input type="checkbox"/> Geomorphic Position (D2)					
<input type="checkbox"/> Iron Deposits (B5)	<input type="checkbox"/> Thin Muck Surface (C7)	<input type="checkbox"/> FAC-Neutral Test (D5)					
<input type="checkbox"/> Inundation Visible on Aerial Imagery (B7)	<input type="checkbox"/> Gauge or Well Data (D9)						
<input type="checkbox"/> Sparsely Vegetated Concave Surface (B8)	<input type="checkbox"/> Other (Explain in Remarks)						

Field Observations: Surface Water Present? Yes _____ No <u>x</u> Depth (inches): _____ Water Table Present? Yes _____ No <u>x</u> Depth (inches): _____ Saturation Present? Yes _____ No <u>x</u> Depth (inches): _____ (includes capillary fringe)	Wetland Hydrology Present? Yes _____ No <u>X</u>
Describe Recorded Data (stream gauge, monitoring well, aerial photos, previous inspections), if available:	
Remarks:	

U.S. Army Corps of Engineers WETLAND DETERMINATION DATA SHEET – Midwest Region See ERDC/EL TR-10-16; the proponent agency is CECW-CO-R	OMB Control #: 0710-0024, Exp: 9/30/2027 Requirement Control Symbol EXEMPT: (Authority: AR 335-15, paragraph 5-2a)
--	---

Project/Site: <u>3600 Auburn Road (Sidwell No. 15-30-376-032)</u>	City/County: <u>Rochester Hills-Oakland Co.</u>	Sampling Date: <u>3-6-25</u>
Applicant/Owner: <u>3600 Auburn Road LLC</u>	State: <u>MI</u>	Sampling Point: <u>UP5</u>
Investigator(s): <u>ASTI-KAH</u>	Section, Township, Range: <u>Sec 30 T3N R11E</u>	
Landform (hillside, terrace, etc.): <u>slight slope</u>	Local relief (concave, convex, none): <u>slope</u>	
Slope (%): <u>2-4</u> Lat: <u>42.6352</u>	Long: <u>-83.2035</u>	Datum: <u>WGS84</u>
Soil Map Unit Name: <u>Fox sandy loam (till plain, 2-6% slopes)</u>	NW1 classification: <u>none</u>	

Are climatic / hydrologic conditions on the site typical for this time of year? Yes x No (If no, explain in Remarks.)

Are Vegetation , Soil , or Hydrology significantly disturbed? Are "Normal Circumstances" present? Yes x No

Are Vegetation , Soil , or Hydrology naturally problematic? (If needed, explain any answers in Remarks.)

SUMMARY OF FINDINGS – Attach site map showing sampling point locations, transects, important features, etc.

Hydrophytic Vegetation Present? Yes <u>X</u> No <u> </u> Hydric Soil Present? Yes <u> </u> No <u>X</u> Wetland Hydrology Present? Yes <u> </u> No <u>X</u>	Is the Sampled Area within a Wetland? Yes <u> </u> No <u>X</u>
Remarks: Conditions adjacent to Wetland A in the east-central portion of the site.	

VEGETATION – Use scientific names of plants.

Tree Stratum (Plot size: <u>30'</u>) 1. <u>Acer negundo</u> 2. <u>Acer saccharinum</u> 3. <u> </u> 4. <u> </u> 5. <u> </u> <div style="text-align: right;"><u>30</u> =Total Cover</div> Sapling/Shrub Stratum (Plot size: <u>15'</u>) 1. <u>Prunus serotina</u> 2. <u>Lonicera maackii</u> 3. <u>Frangula alnus</u> 4. <u> </u> 5. <u> </u> <div style="text-align: right;"><u>65</u> =Total Cover</div> Herb Stratum (Plot size: <u>5'</u>) 1. <u>Lonicera maackii</u> 2. <u>Alliaria petiolata</u> 3. <u> </u> 4. <u> </u> 5. <u> </u> 6. <u> </u> 7. <u> </u> 8. <u> </u> 9. <u> </u> 10. <u> </u> <div style="text-align: right;"><u>35</u> =Total Cover</div> Woody Vine Stratum (Plot size: <u>15'</u>) 1. <u> </u> 2. <u> </u> <div style="text-align: right;"><u>0</u> =Total Cover</div>	Dominance Test worksheet: Number of Dominant Species That Are OBL, FACW, or FAC: <u>4</u> (A) Total Number of Dominant Species Across All Strata: <u>6</u> (B) Percent of Dominant Species That Are OBL, FACW, or FAC: <u>66.7%</u> (A/B)																
	Prevalence Index worksheet: <table style="width: 100%; border-collapse: collapse;"> <tr> <th style="text-align: left;">Total % Cover of:</th> <th style="text-align: left;">Multiply by:</th> </tr> <tr> <td>OBL species <u>0</u></td> <td>x 1 = <u>0</u></td> </tr> <tr> <td>FACW species <u>50</u></td> <td>x 2 = <u>100</u></td> </tr> <tr> <td>FAC species <u>25</u></td> <td>x 3 = <u>75</u></td> </tr> <tr> <td>FACU species <u>5</u></td> <td>x 4 = <u>20</u></td> </tr> <tr> <td>UPL species <u>50</u></td> <td>x 5 = <u>250</u></td> </tr> <tr> <td>Column Totals: <u>130</u> (A)</td> <td><u>445</u> (B)</td> </tr> <tr> <td colspan="2">Prevalence Index = B/A = <u>3.42</u></td> </tr> </table>	Total % Cover of:	Multiply by:	OBL species <u>0</u>	x 1 = <u>0</u>	FACW species <u>50</u>	x 2 = <u>100</u>	FAC species <u>25</u>	x 3 = <u>75</u>	FACU species <u>5</u>	x 4 = <u>20</u>	UPL species <u>50</u>	x 5 = <u>250</u>	Column Totals: <u>130</u> (A)	<u>445</u> (B)	Prevalence Index = B/A = <u>3.42</u>	
Total % Cover of:	Multiply by:																
OBL species <u>0</u>	x 1 = <u>0</u>																
FACW species <u>50</u>	x 2 = <u>100</u>																
FAC species <u>25</u>	x 3 = <u>75</u>																
FACU species <u>5</u>	x 4 = <u>20</u>																
UPL species <u>50</u>	x 5 = <u>250</u>																
Column Totals: <u>130</u> (A)	<u>445</u> (B)																
Prevalence Index = B/A = <u>3.42</u>																	
	Hydrophytic Vegetation Indicators: <u> </u> 1 - Rapid Test for Hydrophytic Vegetation <u>X</u> 2 - Dominance Test is >50% <u> </u> 3 - Prevalence Index is ≤3.0 ¹ <u> </u> 4 - Morphological Adaptations ¹ (Provide supporting data in Remarks or on a separate sheet) <u> </u> Problematic Hydrophytic Vegetation ¹ (Explain) ¹ Indicators of hydric soil and wetland hydrology must be present, unless disturbed or problematic.																
Remarks: (Include photo numbers here or on a separate sheet.)	Hydrophytic Vegetation Present? Yes <u>X</u> No <u> </u>																

SOIL

Sampling Point: UP5

Profile Description: (Describe to the depth needed to document the indicator or confirm the absence of indicators.)								
Depth (inches)	Matrix		Redox Features				Texture	Remarks
	Color (moist)	%	Color (moist)	%	Type ¹	Loc ²		
0-16	10YR 3/2	100					Sandy	
16-18	10YR 7/4	85	10YR 3/2	20	C	M	Loamy/Clayey	Prominent redox concentrations

¹Type: C=Concentration, D=Depletion, RM=Reduced Matrix, MS=Masked Sand Grains. ²Location: PL=Pore Lining, M=Matrix.

Hydric Soil Indicators: <input type="checkbox"/> Histosol (A1) <input type="checkbox"/> Histic Epipedon (A2) <input type="checkbox"/> Black Histic (A3) <input type="checkbox"/> Hydrogen Sulfide (A4) <input type="checkbox"/> Stratified Layers (A5) <input type="checkbox"/> 2 cm Muck (A10) <input type="checkbox"/> Depleted Below Dark Surface (A11) <input type="checkbox"/> Thick Dark Surface (A12) <input type="checkbox"/> Iron Monosulfide (A18) <input type="checkbox"/> Sandy Mucky Mineral (S1) <input type="checkbox"/> 5 cm Mucky Peat or Peat (S3)	<input type="checkbox"/> Sandy Gleyed Matrix (S4) <input type="checkbox"/> Sandy Redox (S5) <input type="checkbox"/> Stripped Matrix (S6) <input type="checkbox"/> Dark Surface (S7) <input type="checkbox"/> Loamy Mucky Mineral (F1) <input type="checkbox"/> Loamy Gleyed Matrix (F2) <input type="checkbox"/> Depleted Matrix (F3) <input type="checkbox"/> Redox Dark Surface (F6) <input type="checkbox"/> Depleted Dark Surface (F7) <input type="checkbox"/> Redox Depressions (F8)	Indicators for Problematic Hydric Soils³: <input type="checkbox"/> Iron-Manganese Masses (F12) <input type="checkbox"/> Red Parent Material (F21) <input type="checkbox"/> Very Shallow Dark Surface (F22) <input type="checkbox"/> Other (Explain in Remarks)
--	--	--

³Indicators of hydrophytic vegetation and wetland hydrology must be present, unless disturbed or problematic.

Restrictive Layer (if observed): Type: _____ none _____ Depth (inches): _____	Hydric Soil Present? Yes _____ No <u>X</u>
--	---

Remarks:

HYDROLOGY

Wetland Hydrology Indicators:			
<u>Primary Indicators (minimum of one is required; check all that apply)</u>		<u>Secondary Indicators (minimum of two required)</u>	
<input type="checkbox"/> Surface Water (A1)	<input type="checkbox"/> Water-Stained Leaves (B9)	<input type="checkbox"/> Surface Soil Cracks (B6)	
<input type="checkbox"/> High Water Table (A2)	<input type="checkbox"/> Aquatic Fauna (B13)	<input type="checkbox"/> Drainage Patterns (B10)	
<input type="checkbox"/> Saturation (A3)	<input type="checkbox"/> True Aquatic Plants (B14)	<input type="checkbox"/> Dry-Season Water Table (C2)	
<input type="checkbox"/> Water Marks (B1)	<input type="checkbox"/> Hydrogen Sulfide Odor (C1)	<input type="checkbox"/> Crayfish Burrows (C8)	
<input type="checkbox"/> Sediment Deposits (B2)	<input type="checkbox"/> Oxidized Rhizospheres on Living Roots (C3)	<input type="checkbox"/> Saturation Visible on Aerial Imagery (C9)	
<input type="checkbox"/> Drift Deposits (B3)	<input type="checkbox"/> Presence of Reduced Iron (C4)	<input type="checkbox"/> Stunted or Stressed Plants (D1)	
<input type="checkbox"/> Algal Mat or Crust (B4)	<input type="checkbox"/> Recent Iron Reduction in Tilled Soils (C6)	<input type="checkbox"/> Geomorphic Position (D2)	
<input type="checkbox"/> Iron Deposits (B5)	<input type="checkbox"/> Thin Muck Surface (C7)	<input type="checkbox"/> FAC-Neutral Test (D5)	
<input type="checkbox"/> Inundation Visible on Aerial Imagery (B7)	<input type="checkbox"/> Gauge or Well Data (D9)		
<input type="checkbox"/> Sparsely Vegetated Concave Surface (B8)	<input type="checkbox"/> Other (Explain in Remarks)		

Field Observations: Surface Water Present? Yes _____ No <u>x</u> Depth (inches): _____ Water Table Present? Yes _____ No <u>x</u> Depth (inches): _____ Saturation Present? Yes _____ No <u>x</u> Depth (inches): _____ (includes capillary fringe)	Wetland Hydrology Present? Yes _____ No <u>X</u>
--	--

Describe Recorded Data (stream gauge, monitoring well, aerial photos, previous inspections), if available:

Remarks:

U.S. Army Corps of Engineers WETLAND DETERMINATION DATA SHEET – Midwest Region See ERDC/EL TR-10-16; the proponent agency is CECW-CO-R	OMB Control #: 0710-0024, Exp: 9/30/2027 Requirement Control Symbol EXEMPT: (Authority: AR 335-15, paragraph 5-2a)
--	---

Project/Site: <u>3600 Auburn Road (Sidwell No. 15-30-376-032)</u>	City/County: <u>Rochester Hills-Oakland Co.</u>	Sampling Date: <u>3-6-25</u>
Applicant/Owner: <u>3600 Auburn Road LLC</u>	State: <u>MI</u>	Sampling Point: <u>WT1</u>
Investigator(s): <u>ASTI-KAH</u>	Section, Township, Range: <u>Sec 30 T3N R11E</u>	
Landform (hillside, terrace, etc.): <u>depression</u>	Local relief (concave, convex, none): <u>concave</u>	
Slope (%): <u>2-4</u> Lat: <u>42.6345</u>	Long: <u>-83.2044</u>	Datum: <u>WGS84</u>
Soil Map Unit Name: <u>Thetford loamy fine sand (0-3% slopes)</u>	NW1 classification: <u>PFO1C</u>	

Are climatic / hydrologic conditions on the site typical for this time of year? Yes x No (If no, explain in Remarks.)

Are Vegetation , Soil , or Hydrology significantly disturbed? Are "Normal Circumstances" present? Yes x No

Are Vegetation , Soil , or Hydrology naturally problematic? (If needed, explain any answers in Remarks.)

SUMMARY OF FINDINGS – Attach site map showing sampling point locations, transects, important features, etc.

Hydrophytic Vegetation Present? Yes <u>X</u> No <u> </u> Hydric Soil Present? Yes <u>X</u> No <u> </u> Wetland Hydrology Present? Yes <u>X</u> No <u> </u>	Is the Sampled Area within a Wetland? Yes <u>X</u> No <u> </u>
Remarks: Wetland A - forested portion in the SW portion of the site.	

VEGETATION – Use scientific names of plants.

Tree Stratum	(Plot size: <u>30'</u>)	Absolute % Cover	Dominant Species?	Indicator Status	Dominance Test worksheet: Number of Dominant Species That Are OBL, FACW, or FAC: <u>5</u> (A) Total Number of Dominant Species Across All Strata: <u>5</u> (B) Percent of Dominant Species That Are OBL, FACW, or FAC: <u>100.0%</u> (A/B)
1. <u>Acer negundo</u>		<u>20</u>	<u>Yes</u>	<u>FAC</u>	
2. <u>Acer saccharinum</u>		<u>10</u>	<u>No</u>	<u>FACW</u>	
3. <u>Fraxinus pennsylvanica</u>		<u>15</u>	<u>Yes</u>	<u>FACW</u>	
4. <u>Populus deltoides</u>		<u>15</u>	<u>Yes</u>	<u>FAC</u>	
5. <u> </u>		<u> </u>	<u> </u>	<u> </u>	
		<u>60</u>	<u>=Total Cover</u>		
Sapling/Shrub Stratum (Plot size: <u>15'</u>)					
1. <u>Fraxinus pennsylvanica</u>		<u>25</u>	<u>Yes</u>	<u>FACW</u>	
2. <u>Cornus racemosa</u>		<u>5</u>	<u>No</u>	<u>FAC</u>	
3. <u>Frangula alnus</u>		<u>50</u>	<u>Yes</u>	<u>FACW</u>	
4. <u> </u>		<u> </u>	<u> </u>	<u> </u>	
5. <u> </u>		<u> </u>	<u> </u>	<u> </u>	
		<u>80</u>	<u>=Total Cover</u>		
Herb Stratum (Plot size: <u>5'</u>)					
1. <u> </u>		<u>0</u>	<u> </u>	<u> </u>	
2. <u> </u>		<u> </u>	<u> </u>	<u> </u>	
3. <u> </u>		<u> </u>	<u> </u>	<u> </u>	
4. <u> </u>		<u> </u>	<u> </u>	<u> </u>	
5. <u> </u>		<u> </u>	<u> </u>	<u> </u>	
6. <u> </u>		<u> </u>	<u> </u>	<u> </u>	
7. <u> </u>		<u> </u>	<u> </u>	<u> </u>	
8. <u> </u>		<u> </u>	<u> </u>	<u> </u>	
9. <u> </u>		<u> </u>	<u> </u>	<u> </u>	
10. <u> </u>		<u> </u>	<u> </u>	<u> </u>	
		<u> </u>	<u>=Total Cover</u>		
Woody Vine Stratum (Plot size: <u>15'</u>)					
1. <u> </u>		<u>0</u>	<u> </u>	<u> </u>	
2. <u> </u>		<u> </u>	<u> </u>	<u> </u>	
		<u> </u>	<u>=Total Cover</u>		

Remarks: (Include photo numbers here or on a separate sheet.)

Hydrophytic Vegetation Indicators: <u> </u> 1 - Rapid Test for Hydrophytic Vegetation <u>X</u> 2 - Dominance Test is >50% <u>X</u> 3 - Prevalence Index is ≤3.0 ¹ <u> </u> 4 - Morphological Adaptations ¹ (Provide supporting data in Remarks or on a separate sheet) <u> </u> Problematic Hydrophytic Vegetation ¹ (Explain) ¹ Indicators of hydric soil and wetland hydrology must be present, unless disturbed or problematic.	Hydrophytic Vegetation Present? Yes <u>X</u> No <u> </u>
--	---

SOIL

Sampling Point: WT1

[illegible]

HYDROLOGY

Wetland Hydrology Indicators:			
Primary Indicators (minimum of one is required; check all that apply)		Secondary Indicators (minimum of two required)	
<input checked="" type="checkbox"/> Surface Water (A1)	<input checked="" type="checkbox"/> Water-Stained Leaves (B9)	<input type="checkbox"/> Surface Soil Cracks (B6)	
<input checked="" type="checkbox"/> High Water Table (A2)	<input type="checkbox"/> Aquatic Fauna (B13)	<input type="checkbox"/> Drainage Patterns (B10)	
<input checked="" type="checkbox"/> Saturation (A3)	<input type="checkbox"/> True Aquatic Plants (B14)	<input type="checkbox"/> Dry-Season Water Table (C2)	
<input type="checkbox"/> Water Marks (B1)	<input type="checkbox"/> Hydrogen Sulfide Odor (C1)	<input type="checkbox"/> Crayfish Burrows (C8)	
<input type="checkbox"/> Sediment Deposits (B2)	<input checked="" type="checkbox"/> Oxidized Rhizospheres on Living Roots (C3)	<input type="checkbox"/> Saturation Visible on Aerial Imagery (C9)	
<input type="checkbox"/> Drift Deposits (B3)	<input type="checkbox"/> Presence of Reduced Iron (C4)	<input type="checkbox"/> Stunted or Stressed Plants (D1)	
<input type="checkbox"/> Algal Mat or Crust (B4)	<input type="checkbox"/> Recent Iron Reduction in Tilled Soils (C6)	<input checked="" type="checkbox"/> Geomorphic Position (D2)	
<input type="checkbox"/> Iron Deposits (B5)	<input type="checkbox"/> Thin Muck Surface (C7)	<input checked="" type="checkbox"/> FAC-Neutral Test (D5)	
<input type="checkbox"/> Inundation Visible on Aerial Imagery (B7)	<input type="checkbox"/> Gauge or Well Data (D9)		
<input type="checkbox"/> Sparsely Vegetated Concave Surface (B8)	<input type="checkbox"/> Other (Explain in Remarks)		
Field Observations:			
Surface Water Present?	Yes <input checked="" type="checkbox"/> No <input type="checkbox"/>	Depth (inches):	<input type="text" value="0.1"/>
Water Table Present?	Yes <input checked="" type="checkbox"/> No <input type="checkbox"/>	Depth (inches):	<input type="text" value="12"/>
Saturation Present?	Yes <input checked="" type="checkbox"/> No <input type="checkbox"/>	Depth (inches):	<input type="text" value="3"/>
(includes capillary fringe)		Wetland Hydrology Present? Yes <input checked="" type="checkbox"/> No <input type="checkbox"/>	
Describe Recorded Data (stream gauge, monitoring well, aerial photos, previous inspections), if available:			
Remarks:			



December 11, 2024

Jennifer MacDonald
City of Rochester Hills
1000 Rochester Hills Drive
Rochester Hills, MI 48309

Reference: **Auburn Road 3600, LLC - CAMS #202400797**
Part of the SW ¼ of Section 30, City of Rochester Hills

Dear Ms. MacDonald,

This office has received a set of plans for the Auburn Road 3600, LLC Project to be developed in part of the Southwest ¼ of Section 30, City of Rochester Hills.

Our stormwater system review indicates that the proposed project may have an involvement with the Chester Drain, which is a legally established County Drain under the jurisdiction of this office. Therefore, a storm drain permit may be required from this office. Please submit a set of plans through our online permitting portal at <https://www.oakgov.com/government/water-resources-commissioner/stormwater/drain-use-permit-applications>.

The water system is operated and maintained by the City of Rochester Hills and plans must be submitted to the City of Rochester Hills for review.

The sanitary sewer is within the Clinton Oakland Sewage Disposal System. Any proposed sewers of 8" or larger may require a permit through this office.

Any related earth disruption must conform to applicable requirements of Part 91, Soil Erosion and Sedimentation Control of the Natural Resource and Environmental Protection Act, Act 451 of the Public Acts of 1994. Applications should be submitted to our office for the required soil erosion permit.

Please note that all applicable permits and approvals from federal, state or local authorities, public utilities and private property owners must be obtained.

If there are any questions regarding this matter, please contact Dan Butkus at 248-897-2744.

Sincerely,

A handwritten signature in blue ink, appearing to read "Brian Bennett", is written over a light blue circular stamp.

Brian Bennett, P.E.
Assistant Chief Engineer




Site and Arch With Wetlands.pdf Markup Summary

Angie (6)




Subject: Underground Utilities
Author: Angie
Date: 4/3/2025 11:40:42 AM
Status:

The applicant will need to submit a Land Improvement Permit (LIP) application with engineer's estimate, fee and construction plans to proceed with the construction plan review process.

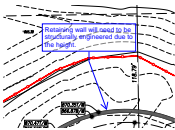

Subject: Underground Utilities
Author: Angie
Date: 4/1/2025 3:34:25 PM
Status:

Retaining wall will need to be structurally engineered due to the height.

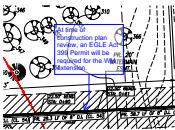


Subject: Underground Utilities
Author: Angie
Date: 4/1/2025 3:41:37 PM
Status:

At time of construction plan review, an EGLE Act 399 Permit will be required for the WM extension.




Subject: Underground Utilities
Author: Angie
Date: 4/1/2025 3:42:24 PM
Status:

Water main profiles must be provided at time of construction plan review.

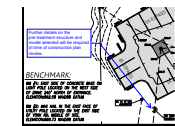

Subject: Underground Utilities
Author: Angie
Date: 4/3/2025 11:35:11 AM
Status:

Further details on the pre-treatment structure and model selected will be required at time of construction plan review.

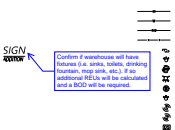

Subject: Underground Utilities
Author: Angie
Date: 4/3/2025 11:35:55 AM
Status:

Confirm if warehouse will have fixtures (i.e. sinks, toilets, drinking fountain, mop sink, etc.). If so additional REUs will be calculated and a BOD will be required.

C.McLeod (24)



Subject: Planning Department
Author: C.McLeod
Date: 4/9/2025 1:57:38 PM
Status:


Maintenance. The owner, tenant, occupant or person responsible for any property which was the subject of an approved site plan shall maintain the property and the improvements thereon in accordance with the approved site plan or an approved amendment thereof. This responsibility shall include the duty to maintain in a condition substantially similar as approved, including the duty to replace, if necessary, all improvements such as, but not by way of limitation, all greenbelts, planting, walls, fences, paving, trash receptacles, handicapped parking areas, etc.



Subject: Planning Department
Author: C.McLeod
Date: 4/9/2025 2:07:53 PM
Status:

Assessing Yes

Subject: Planning Department
Author: C.McLeod
Date: 4/9/2025 2:08:05 PM
Status:

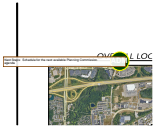

Subject: Group
Author: C.McLeod
Date: 4/9/2025 2:08:44 PM
Status:



Subject: Group
Author: C.McLeod
Date: 4/9/2025 2:09:22 PM
Status:

SP



Subject: Group
Author: C.McLeod
Date: 4/9/2025 2:09:28 PM
Status:

LB



Subject: Group
Author: C.McLeod
Date: 4/9/2025 2:09:32 PM
Status:

LIP



Subject: Group
Author: C.McLeod
Date: 4/9/2025 2:09:37 PM
Status:

BP



Subject: Group
Author: C.McLeod
Date: 4/9/2025 2:09:46 PM
Status:

PCM

\$6,550 for landscaping, \$2,700 for irrigation.

Subject: Planning Department
Author: C.McLeod
Date: 4/9/2025 2:17:02 PM
Status:

\$6,550 for landscaping, \$2,700 for irrigation.

A PART OF THE SOL
CORNERS OF SH-5




Subject: Group
Author: C.McLeod
Date: 4/9/2025 2:17:11 PM
Status:



Subject: Planning Department
Author: C.McLeod
Date: 4/9/2025 2:18:47 PM
Status:

25 trees (\$8,350) to be paid into the City Tree Fund

	<p>Subject: Planning Department Author: C.McLeod Date: 4/9/2025 4:06:35 PM Status:</p>	<p>Final wetland size to be determined by survey of wetland delineating markers. If surveyed area totals more than 2 acres, additional reviews may be necessary pursuant to Ordinance.</p>
	<p>Subject: Group Author: C.McLeod Date: 4/9/2025 2:10:40 PM Status:</p>	<p>Received 3/25/2025 City of Rochester Hills Planning & Economic Development</p>
	<p>Subject: Group Author: C.McLeod Date: 4/9/2025 2:10:49 PM Status:</p>	<p>Received 3/25/2025 City of Rochester Hills Planning & Economic Development</p>
	<p>Subject: Group Author: C.McLeod Date: 4/9/2025 2:10:53 PM Status:</p>	<p>Received 3/25/2025 City of Rochester Hills Planning & Economic Development</p>
	<p>Subject: Group Author: C.McLeod Date: 4/9/2025 2:10:58 PM Status:</p>	<p>Received 3/25/2025 City of Rochester Hills Planning & Economic Development</p>
	<p>Subject: Group Author: C.McLeod Date: 4/9/2025 2:13:36 PM Status:</p>	<p>PCM</p>
	<p>Subject: Planning Department Author: C.McLeod Date: 4/9/2025 2:15:20 PM Status:</p>	<p>Planning Commission to review level of screening being provided by existing vegetation. Proposed building addition is approximately 118 feet from abutting residential property line.</p>
	<p>Subject: Group Author: C.McLeod Date: 4/9/2025 2:11:02 PM Status:</p>	<p>Received 3/25/2025 City of Rochester Hills Planning & Economic Development</p>
	<p>Subject: Group Author: C.McLeod Date: 4/9/2025 2:11:07 PM Status:</p>	<p>Received 3/25/2025 City of Rochester Hills Planning & Economic Development</p>
	<p>Subject: Group Author: C.McLeod Date: 4/9/2025 2:11:11 PM Status:</p>	<p>Received 3/25/2025 City of Rochester Hills Planning & Economic Development</p>

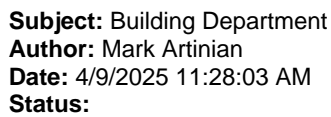

Subject: Building Department
Author: Mark Artinian
Date: 4/8/2025 4:42:01 PM
Status:

CODE EVALUATION:

USE GROUP 3 I S-2
CONSTRUCTION CLASS TB
BUILDING IS NOT SPRINKLED
ALLOWABLE FLOOR AREA PER TABLE 501

Subject: Natural Resources
Author: Matt Einheuser
Date: 4/4/2025 8:10:26 AM
Status:

