


TYPICAL WALL LEGEND:		PLAN SYMBOL LEGEND:	
<p>INTERIOR WALL PARTITIONS (HEIGHTS AS NOTED): LOW PARTITION WALL OF 5/8" GIP BOARD, 2x6 CONDENSATION BROKEN BOARD, 1/2" WATER RESISTANT GIP BOARD, OR AS NOTED ON 2-4" OR 6" METAL STUD FRAMING AT 16" O.C. PROVIDE PRE-MANUFACTURED M-WALL STRUCTURAL TUBE STEEL SUPPORTS WELDED TO BASE PLATES SECURED TO EXISTING FLOOR BY CLAMP-DETACH OR EQUAL, AS NECESSARY. LOCATE SUPPORTS AT END OF WALL AND AT 4'-0" O.C. TO 4'-0" O.C. MAX SPACING.</p> <p>NOTE: AT OPEN WALKWAYS MAKE WITH LOW PARTITION WALLS. EXTEND THE METAL STUDS FOR THE WALL ABOVE THE LOW PARTITION WALL TO THE UNDERLIE OF STRUCTURE AT EXPOSED COLLARS. SEE WALL SECTIONS, FINISH PLAN AND SCHEDULE.</p>	<p>EXISTING 1-HOUR RATED DEMISING WALL</p> <p>COORINATE TO EXISTING WALLS. PROVIDE 1/2" GIP BOARD, 2x6 CONDENSATION BROKEN BOARD, 1/2" WATER RESISTANT GIP BOARD, OR AS NOTED ON 2-4" OR 6" METAL STUD FRAMING AT 16" O.C. PROVIDE PRE-MANUFACTURED M-WALL STRUCTURAL TUBE STEEL SUPPORTS WELDED TO BASE PLATES SECURED TO EXISTING FLOOR BY CLAMP-DETACH OR EQUAL, AS NECESSARY. LOCATE SUPPORTS AT END OF WALL AND AT 4'-0" O.C. TO 4'-0" O.C. MAX SPACING.</p> <p>NOTE: AT OPEN WALKWAYS MAKE WITH LOW PARTITION WALLS. EXTEND THE METAL STUDS FOR THE WALL ABOVE THE LOW PARTITION WALL TO THE UNDERLIE OF STRUCTURE AT EXPOSED COLLARS. SEE WALL SECTIONS, FINISH PLAN AND SCHEDULE.</p>	<p>W</p> <p>EXISTING 1-HOUR RATED DEMISING WALL</p> <p>COORINATE TO EXISTING WALLS. PROVIDE 1/2" GIP BOARD, 2x6 CONDENSATION BROKEN BOARD, 1/2" WATER RESISTANT GIP BOARD, OR AS NOTED ON 2-4" OR 6" METAL STUD FRAMING AT 16" O.C. PROVIDE PRE-MANUFACTURED M-WALL STRUCTURAL TUBE STEEL SUPPORTS WELDED TO BASE PLATES SECURED TO EXISTING FLOOR BY CLAMP-DETACH OR EQUAL, AS NECESSARY. LOCATE SUPPORTS AT END OF WALL AND AT 4'-0" O.C. TO 4'-0" O.C. MAX SPACING.</p> <p>NOTE: AT OPEN WALKWAYS MAKE WITH LOW PARTITION WALLS. EXTEND THE METAL STUDS FOR THE WALL ABOVE THE LOW PARTITION WALL TO THE UNDERLIE OF STRUCTURE AT EXPOSED COLLARS. SEE WALL SECTIONS, FINISH PLAN AND SCHEDULE.</p>	<p>PLAN SYMBOL LEGEND:</p> <p>NOTE: SEE LIFE SAFETY PLAN FOR FIRE EXTINGUISHER LOCATIONS</p> <p>W</p> <p>EXISTING 1-HOUR RATED DEMISING WALL</p> <p>COORINATE TO EXISTING WALLS. PROVIDE 1/2" GIP BOARD, 2x6 CONDENSATION BROKEN BOARD, 1/2" WATER RESISTANT GIP BOARD, OR AS NOTED ON 2-4" OR 6" METAL STUD FRAMING AT 16" O.C. PROVIDE PRE-MANUFACTURED M-WALL STRUCTURAL TUBE STEEL SUPPORTS WELDED TO BASE PLATES SECURED TO EXISTING FLOOR BY CLAMP-DETACH OR EQUAL, AS NECESSARY. LOCATE SUPPORTS AT END OF WALL AND AT 4'-0" O.C. TO 4'-0" O.C. MAX SPACING.</p> <p>NOTE: AT OPEN WALKWAYS MAKE WITH LOW PARTITION WALLS. EXTEND THE METAL STUDS FOR THE WALL ABOVE THE LOW PARTITION WALL TO THE UNDERLIE OF STRUCTURE AT EXPOSED COLLARS. SEE WALL SECTIONS, FINISH PLAN AND SCHEDULE.</p>

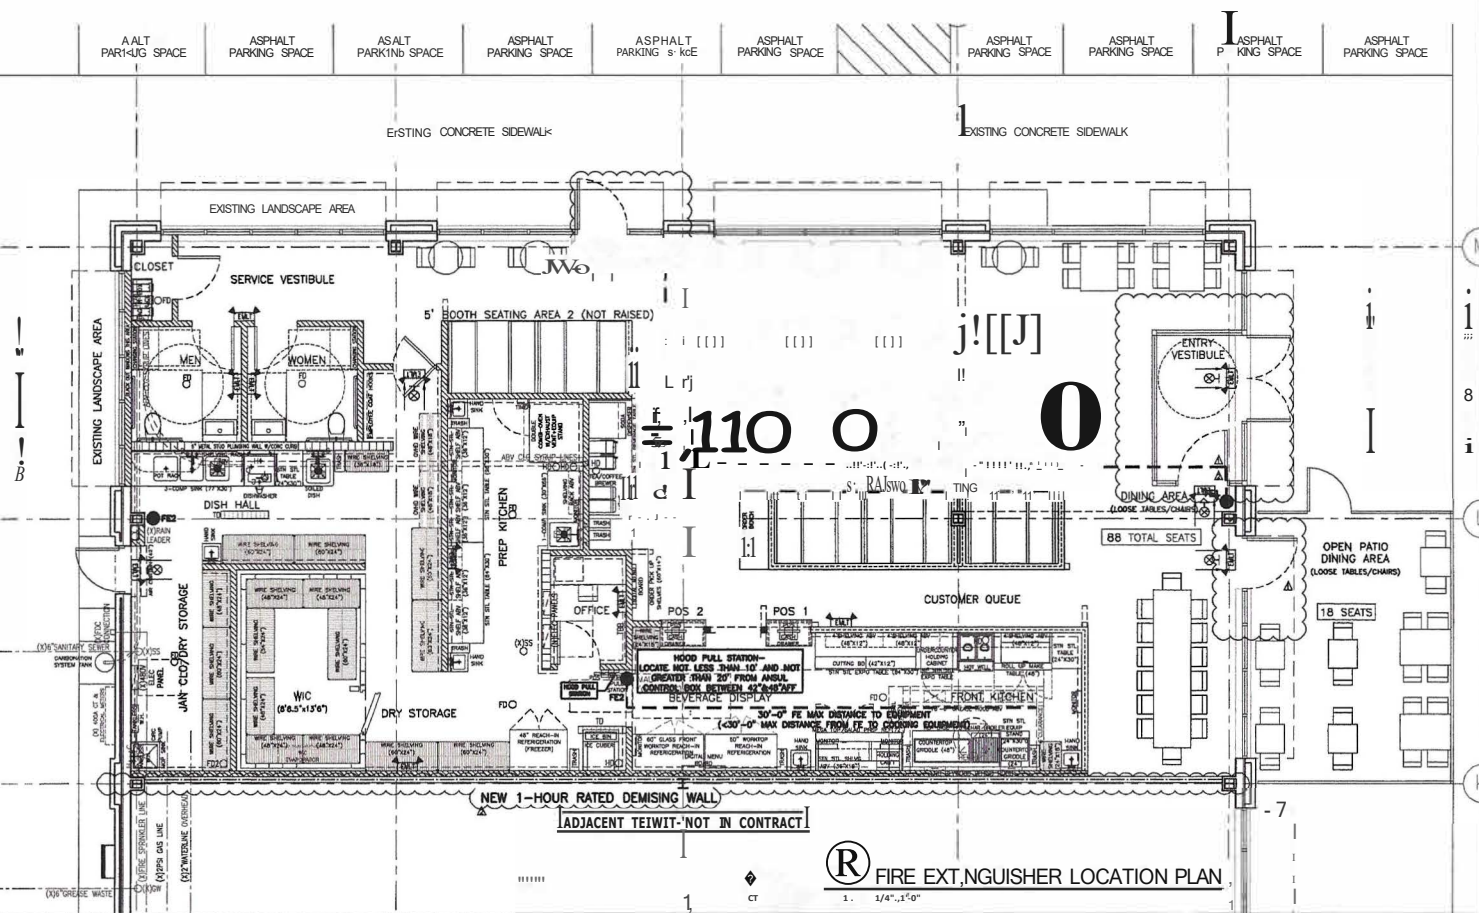

TAZIKI'S RESTAURANT
 GATEWAY II OF ROCHESTER HILLS
 3792 S. ROCHESTER ROAD
 ROCHESTER HILLS, MI 48307
 (± 3,000 RSF)
 (TOTAL RENTABLE AREA)

1
2
3
C.K.H. Architect, P.C.
 3330 Miami Lane
 Birmingham, Alabama 35243

ORIGINAL ISSUE DATE
02/26/2024
 CONSTRUCTION SET

REVISIONS
 03.26.2024 - LL Plan Review Response/ Owner Plan Review Response
 05.18.2024 - City of Rochester Hills Plan Review Response

SHEET NUMBER
A1.3

® FIRE EXTINGUISHER LOCATION PLAN
 1. 1/4" = 1'-0"