SITE PLAN PACKAGE

City of Rochester Hills

Project Name: OAKLEY PROPERTIES, LLC.

930 Mead Rd. Rochester Hills, MI Oakland County, Michigan

Note on plans agreement to submit to the Citys escrow account in the amount of \$10,000.00 for the City's use in future Pathway Construction.

SCOPE OF PROJECT DESCRIPTION

Landscape & Plant Nursery

CIVIL ENGINEER:
Sujak Engineering PLC
4031 Coolidge Hwy.
Troy, MI 48098


CONTACT:
Teon Sujak
Phone: (248) 885-8431
Fax: (248) 885-8432
sujakengineering@comcast.net

BUILDING ENG. / ARCHITECT: TBD PROPRIETOR / LANDSCAPE:
Oakley Properties, LLC.
512 Madison Ave.
Rochester, MI 48307

CONTACT:
TBD

CONTACT:
Ryan Youngblood
Phone: (248) 650-1990
Email: ry@ryoungblood.com
ryoungblood.com

SITE MAP

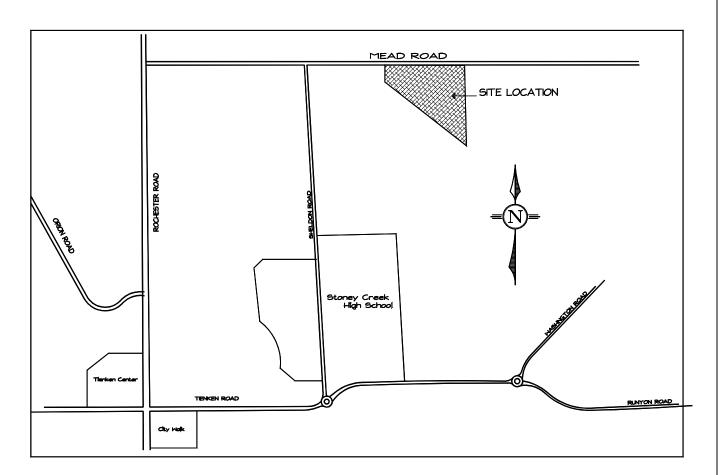



SHEET INDEX

Cover Sheet

- 1. Site Plan (Engineering)
- 2. Site Plan (Area Detail)
- 3. Tree Inventory
- 4. Landscape Plan Per Revision No. 1
- 5. Existing Building Floor Plan
- 6. Existing Building Elevation Plan
- 7. Existing Parking Lot Plan

Site Plan Review Reviewed for compliance to the City Ordinance, Building and Fire Codes						
Department	Reviewer	Approved				
Planning	Kristen Kapelanski 248-841-2572 Kapelanskik@rochesterhills.org	Yes				
Building	Mark Artinian 248-841-2446 ArtinianM@RochesterHills.org	Yes				
Engineering	Jason Boughton 248-841-2490 BoughtonJ@RochesterHills.org	Yes				
Nat. Resources	Matt Einheuser 248-841-2551 EinheuserM@RochesterHills.org	Yes				
Fire	Lt. Josh Boyce 248-841-2713 BoyceJ@RochesterHills.org	Yes				
City of Rochester Hills Planning & Economic Development Conditions and mark-ups noted throughout the plan set must be addressed prior to final approval.						

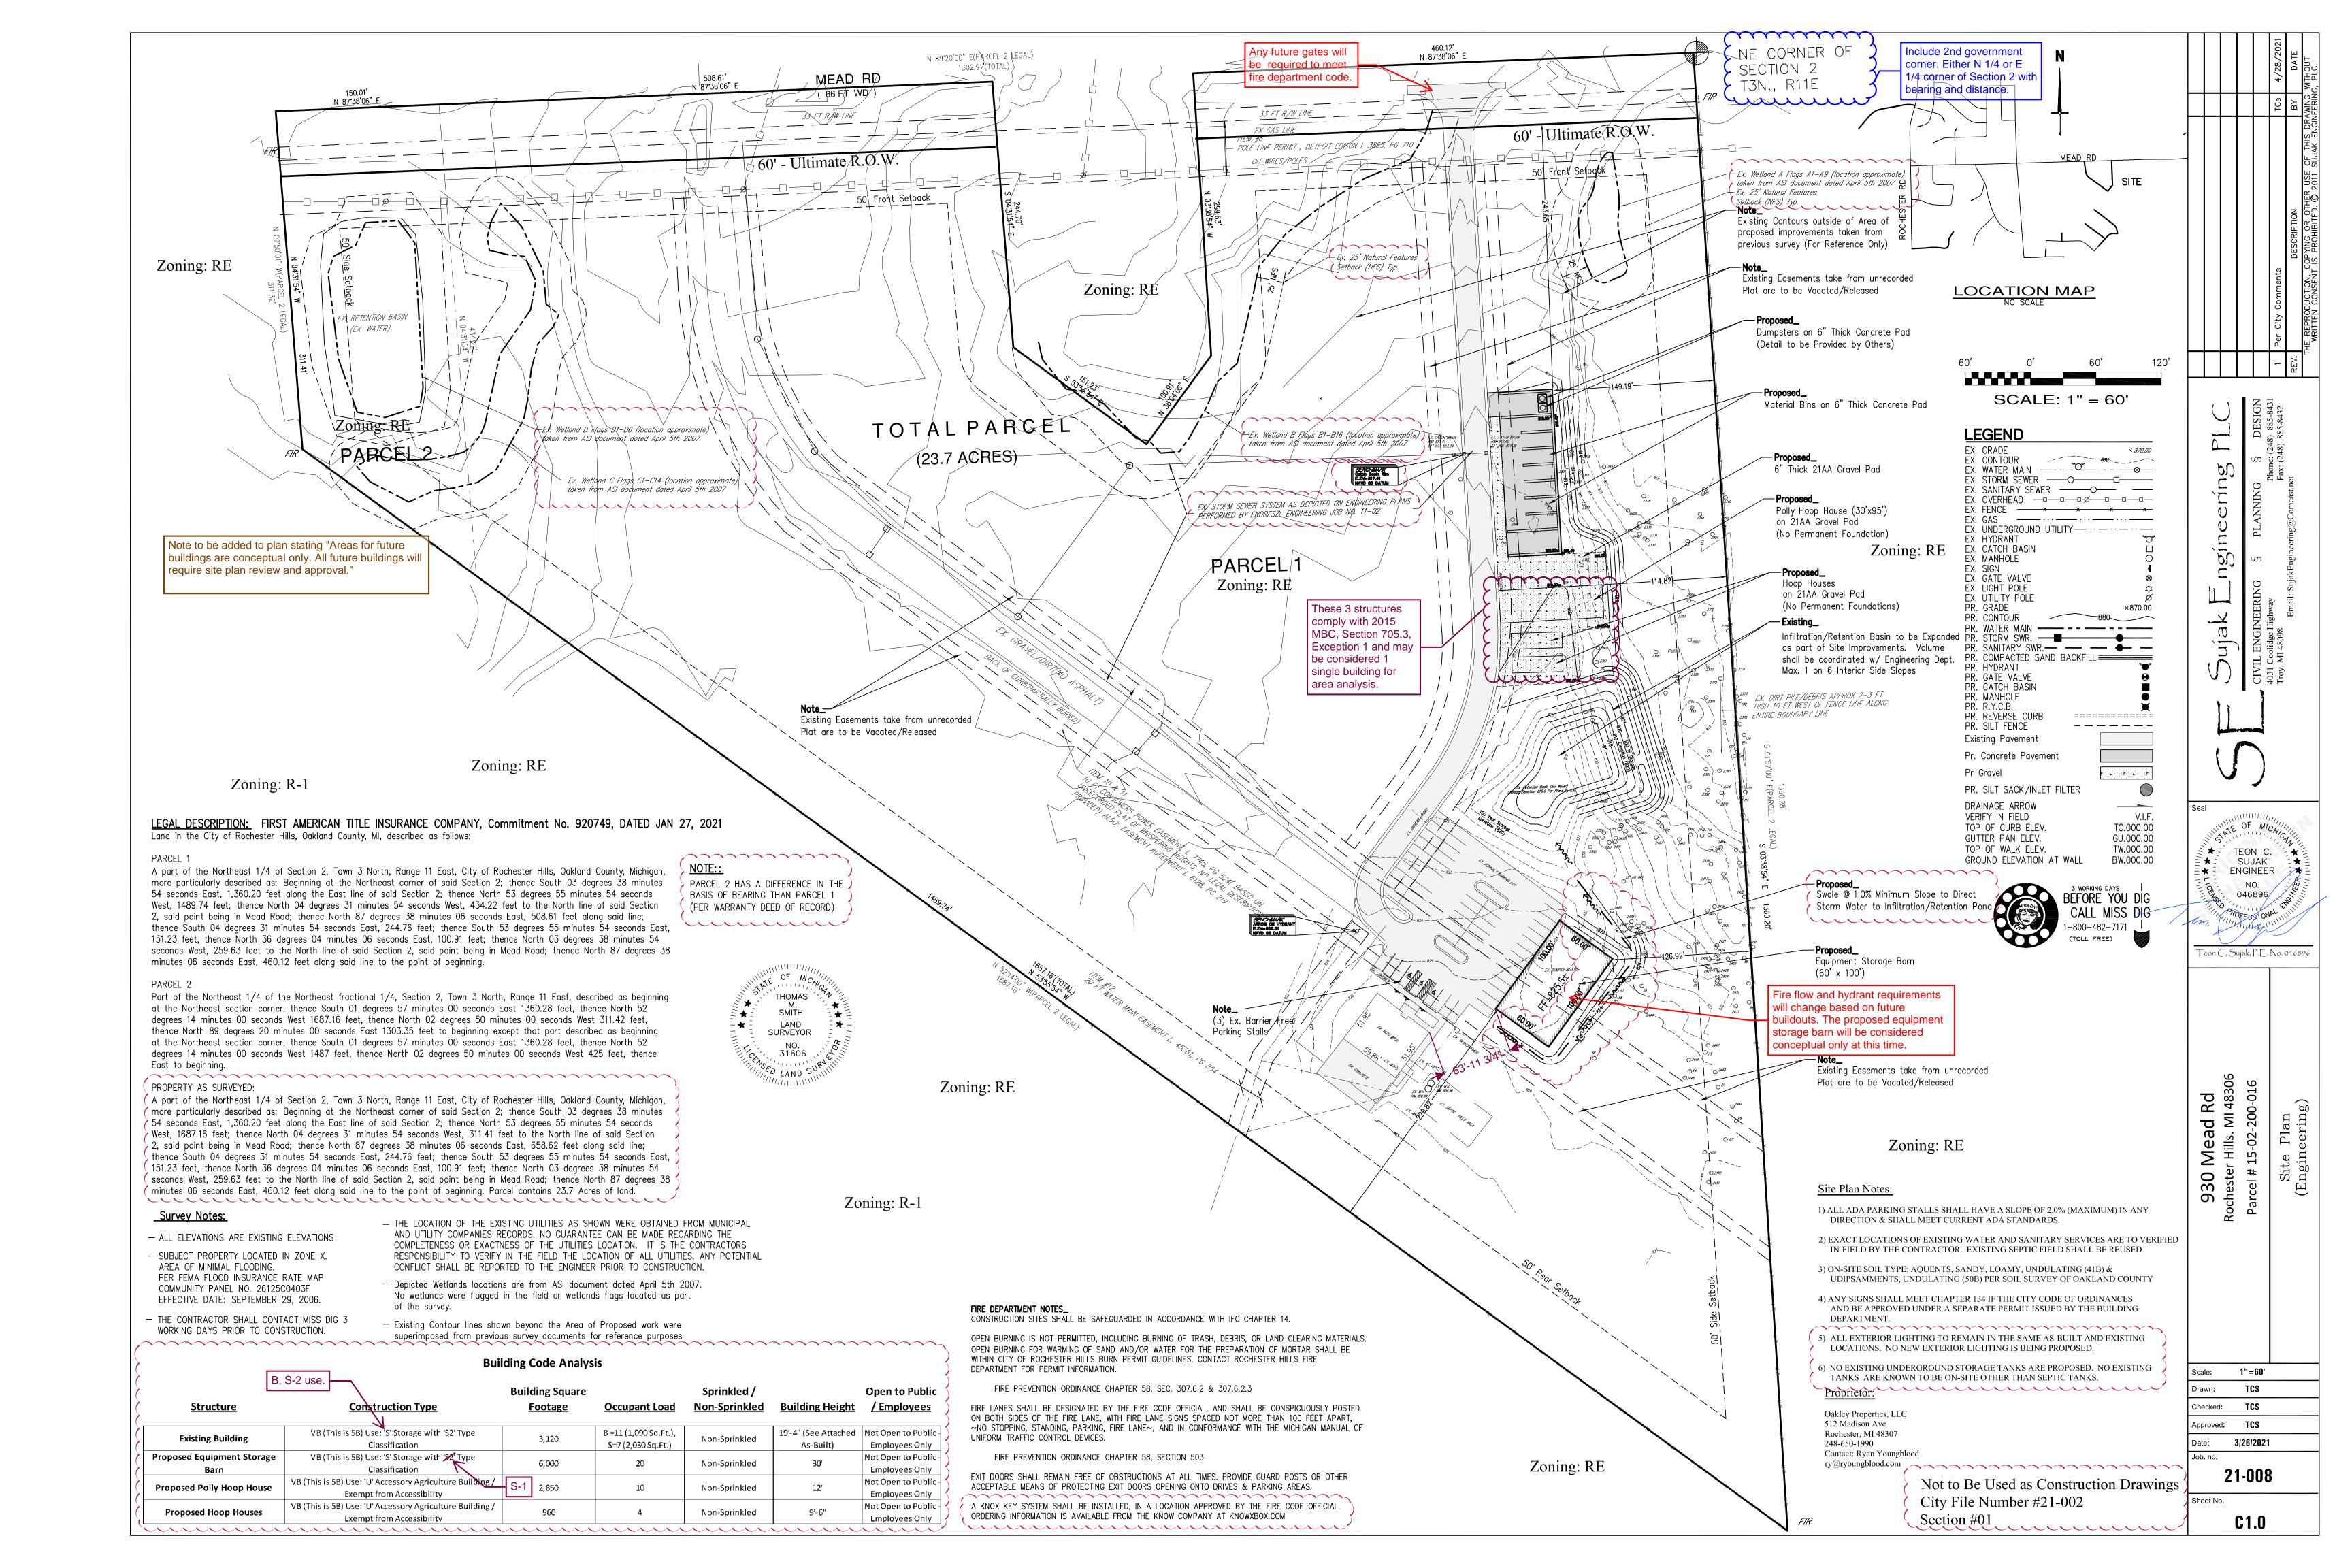

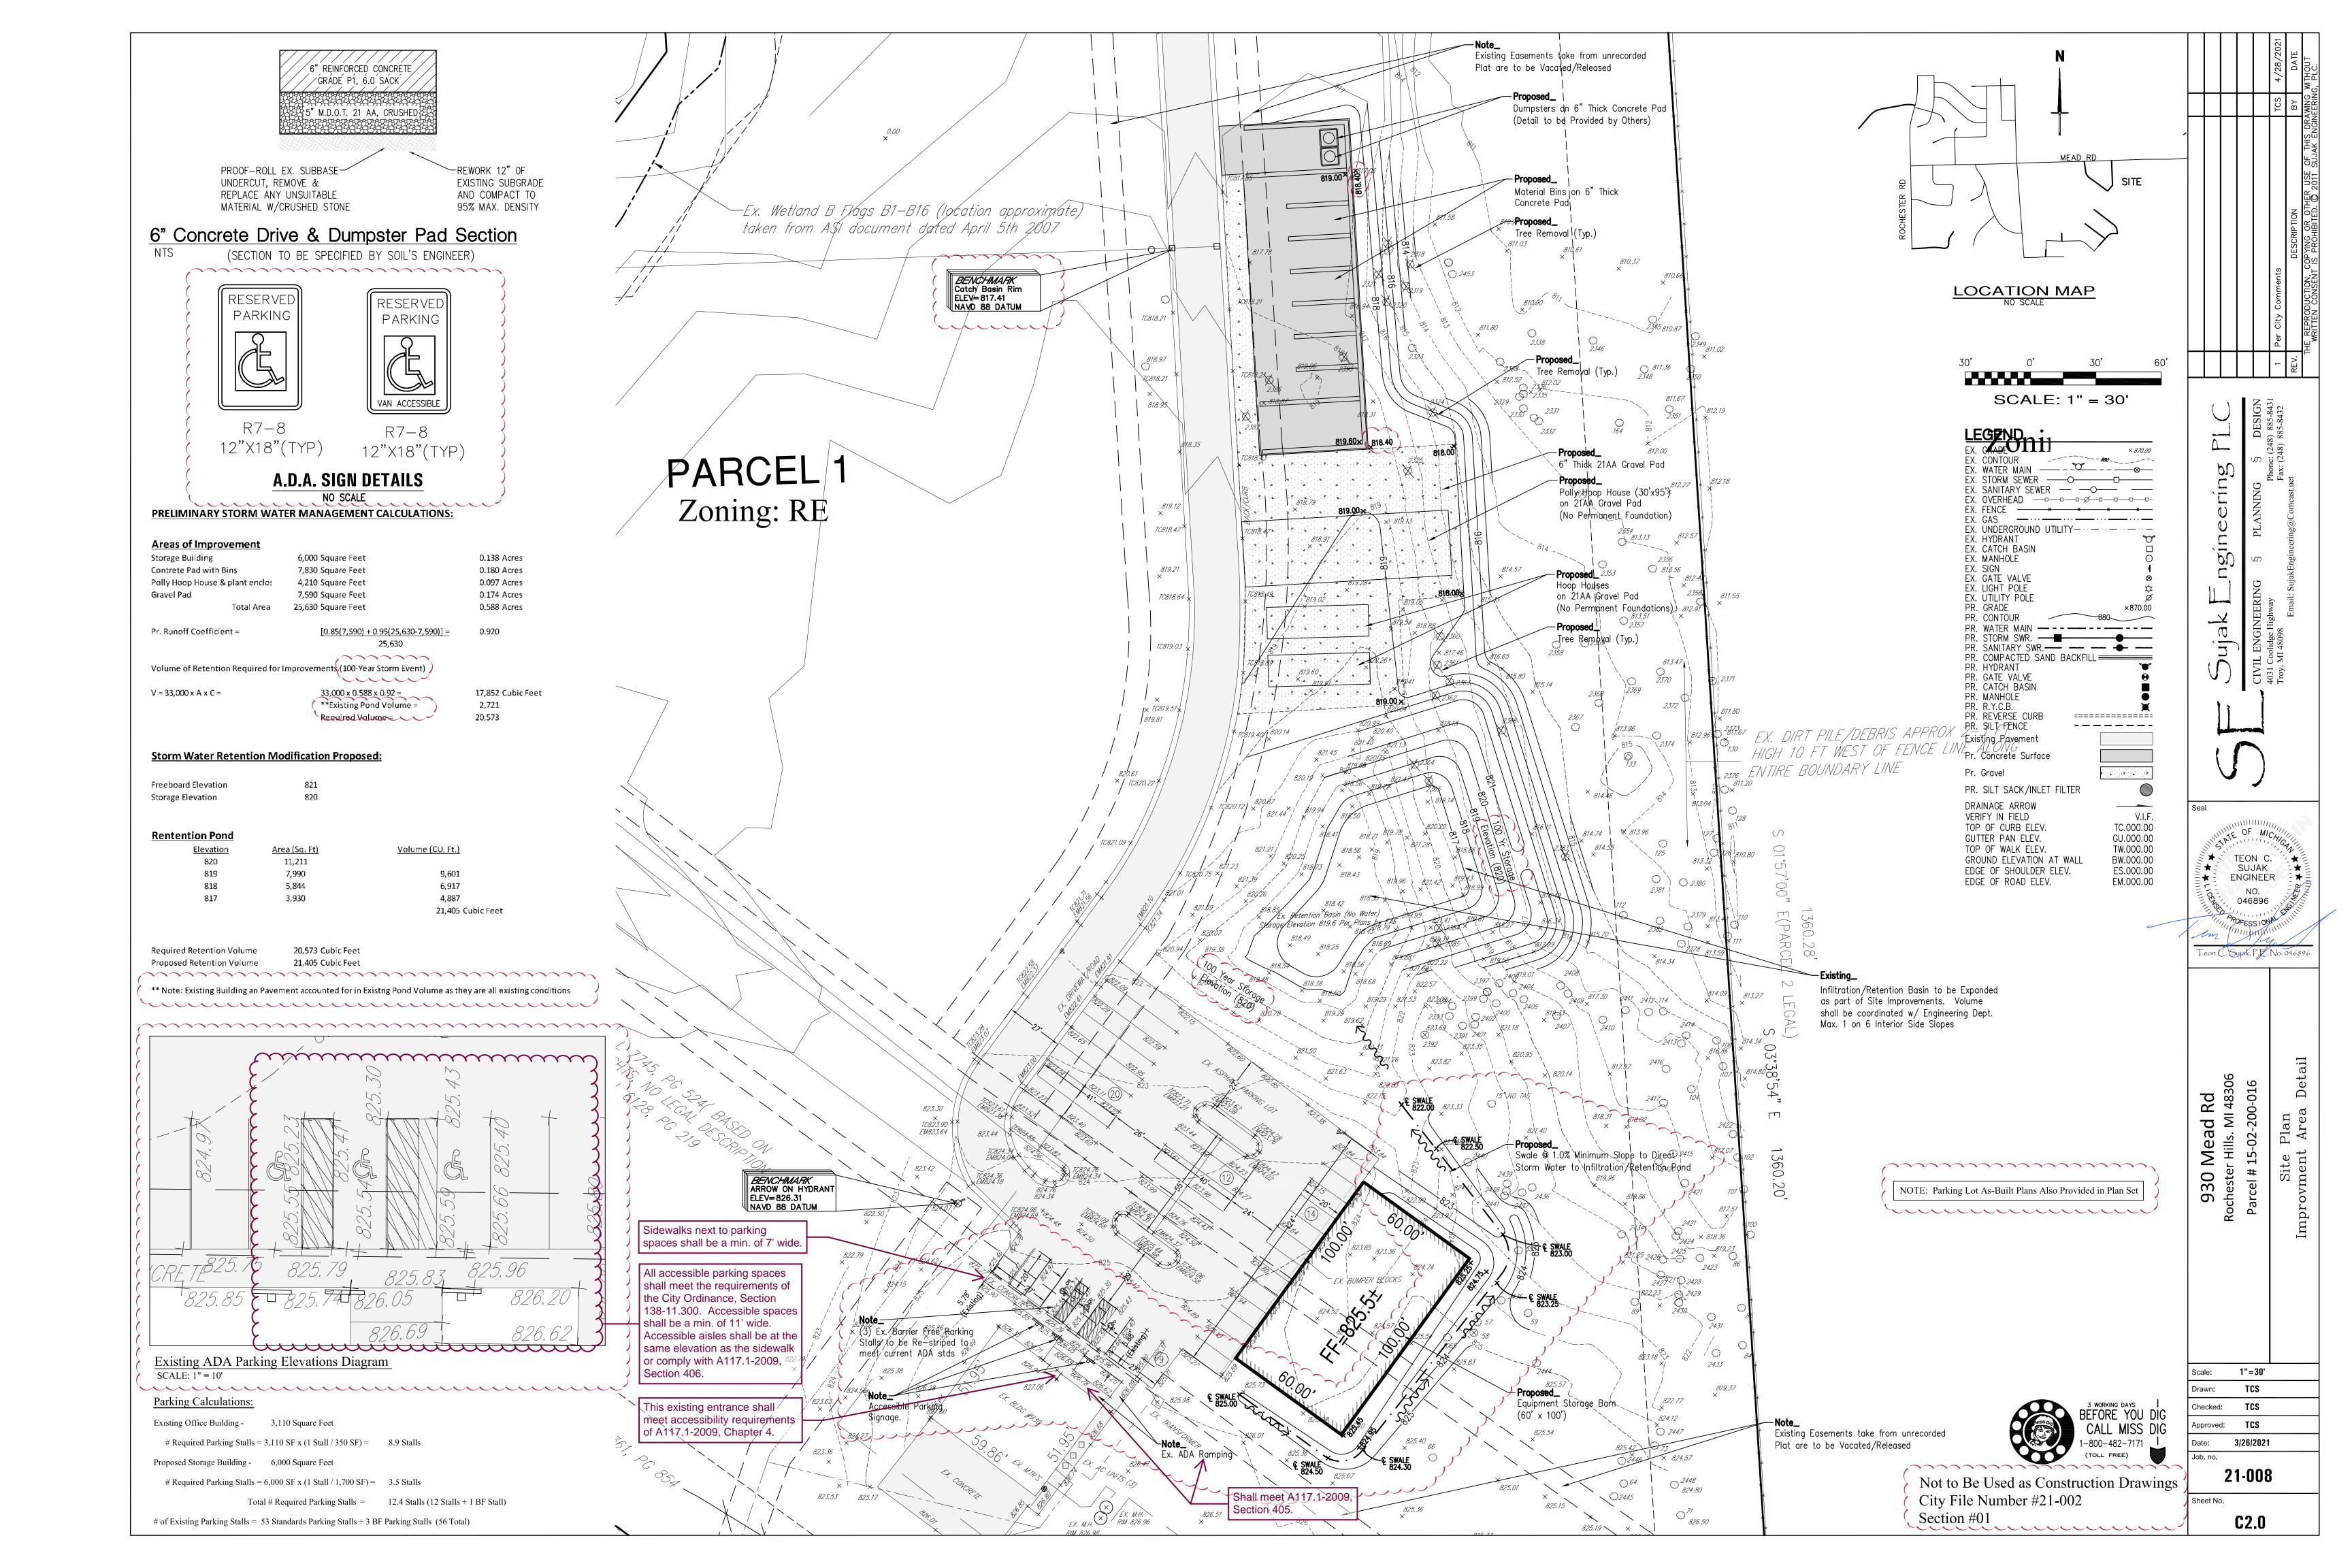

Tree	Size	Tree Type	Tree Type		
No.	(dia. breast ht.)	Scientific Name	Common Name	Condition	Comments
56	12"	Populus deltoides	Cottonwood	Poor	DL, OS, NC
57	14"	Populus deltoides	Cottonwood	Poor	DL, NC
58	18"	Populus deltoides	Cottonwood	Fair	
64	14"	Populus deltoides	Cottonwood	Fair	
66	17"	Populus deltoides	Cottonwood	Fair/Poor	BD
67	11"	Populus deltoides	Cottonwood	Fair	
68	11"	Sassafras albidum	Sassafras	Poor	DL, M
69	16"	Populus deltoides	Cottonwood	Fair/Poor	DL
71	29"	Populus deltoides	Cottonwood	Fair	
73	15"	Populus deltoides	Cottonwood	Poor	BD, DL, OS
75	9"	Populus deltoides	Cottonwood	Fair	
76	13"	Sassafras albidum	Sassafras	Poor	BD, L
77	15"	Sassafras albidum	Sassafras	Dead	Stem only
78	Downed				
81	5", 14"	Ulmus americana	American Elm	Fair/Poor	Vines
82	36"	Quercus alba	White Oak	Fair/Poor	DL
83	9"	Sassafras albidum	Sassafras	Very Poor	Severely leaning
84	11"	Prunus serotina	Black Cherry	Very Poor	Totally VC
85	23"	Sassafras albidum	Sassafras	Dead	Stem only
86	12"	Prunus serotina	Black Cherry	Very Poor	Totally VC
89	13"	Ulmus sp.	Elm	Fair/Poor	BD
100	26"	Quercus alba	White Oak	Fair/Poor	Fence wire thru tree stem
101	23"	Quercus rubra	Red Oak	Poor	DL, Vines
102	60"	Quercus alba	White Oak	Poor	Major SR, Vines
104	8"	Quercus rubra	Red Oak	Poor	NC, VC

106	9"	Ulmus sp.	Elm	Poor	NC, VC
107	10"	Ulmus sp.	Elm	Poor	DL, VC
109	10"	Prunus serotina	Black Cherry	Dead	
110	15", 17"	Prunus serotina	Black Cherry	Dead	
112	23"	Juglans nigra	Black Walnut	Fair/Poor	Some BD, some vines
114	13"	Ulmus sp.	Elm	Poor	DL, NC
125	16"	Quercus alba	White Oak	Poor	DL, OS
126	11"	Prunus avium	Sweet Cherry	Very Poor	Major BD, totally VC.
127	18"	Ulmus sp.	Elm	Fair/Poor	Some vines
130	32", 36""	Quercus alba	White Oak	Fair	
133	20"	Juglans nigra	Black Walnut	Fair	
142	9"	Acer negundo	Box Elder	Very Poor	Major DLs, BD
164	14"	Acer negundo	Box Elder	Very Poor	Major BD, M, VC
174	13"	Populus deltoides	Cottonwood	Poor	DL, OS, some BD
310	15"	Populus deltoides	Cottonwood	Fair	
1058	16"	Populus deltoides	Cottonwood	Fair	
1059	13", 16", 22"	Populus deltoides	Cottonwood	Poor	Some BD, DL, LV
1062	16"	Populus deltoides	Cottonwood	Fair	
1065	13", 18"	Populus deltoides	Cottonwood	Fair	
2201	23"	Populus deltoides	Cottonwood	Fair	
2202	13"	Populus deltoides	Cottonwood	Fair	
2317	8"	Acer negundo	Box Elder	Very Poor	Major TD, DL
2318	22"	Populus deltoides	Cottonwood	Fair	
2319	19"	Populus deltoides	Cottonwood	Fair/Poor	Some DL, OS
2320	7"	Malus sp.	Crabapple	Poor	BD, M, OS
2321	12"	Populus deltoides	Cottonwood	Poor	DL, OS, Vines
2322	9"	Populus deltoides	Cottonwood	Very Poor	Topped, DL, L
2323	21", 23"	Populus deltoides	Cottonwood	Fair	Some vines (Poison ivy)

			<u> </u>		
2324	8", 12"	Malus sp.	Crabapple	Very Poor	Major DL, VC
2325	17"	Acer negundo	Box Elder	Very Poor	Major DL, BD, OS
2326	14", 16"	Acer negundo	Box Elder	Very Poor	Major DL, BR, L, M
2327	18", 20"	Ulmus americana	American Elm	Dead	
2328	7", 9"	Malus sp.	Crabapple	Fair/Poor	DL
2329	7"	Malus sp.	Crabapple	Dead	
2330	6"	Malus sp.	Crabapple	Poor	BD, M
2331	7"	Malus sp.	Crabapple	Poor	BD, DL
2332	11"	Malus sp.	Crabapple	Fair/Poor	М
2333	14"	Malus sp.	Crabapple	Fair	
2334	9"	Malus sp.	Crabapple	Fair/Poor	м
2335	7"	Malus sp.	Crabapple	Poor	M, NC
2336	6"	Malus sp.	Crabapple	Poor	M, NC
2337	7"	Malus sp.	Crabapple	Poor	BD, DL
2338	6", 6", 9"	Malus sp.	Crabapple	Fair/Poor	Vines
2345	14"	Acer negundo	Box Elder	Very Poor	Growing parallel to ground, major BD, vines
2346	12"	Quercus alba	White Oak	Poor	Totally VC
2348	6"	Ulmus sp.	Elm	Poor	Totally VC
2349	9", 27"	Quercus rubra	Red Oak	Fair	
2350	6"	Quercus rubra	Red Oak	Very Poor	BD, NC, Vines
2351	4"	Quercus alba	White Oak	Fair	
2352	7", 9"	Malus sp.	Crabapple	Poor	Totally VC
2353	21"	Juglans nigra	Black Walnut	Fair	
2354	16"	Juglans nigra	Black Walnut	Fair	
2355	22"	Quercus rubra	Red Oak	Fair	
2356	15"	Ulmus sp.	Elm	Fair	
2360	6", 23"	Acer negundo	Box Elder	Very Poor	Many DL, M
2361	11", 12", 15"	Malus sp.	Crabapple	Fair/Poor	М

2362	10"	Acer negundo	Box Elder	Very Poor	Major BR, DL, M
2363	3", 5", 5", 6"	Malus sp.	Crabapple	Poor	VC
2364	10"	Malus sp.	Crabapple	Poor	DL, M, Vines
2365	10", 12"	Malus sp.	Crabapple	Fair/Poor	M, Vines
2366	17"	Acer negundo	Box Elder	Very Poor	Major BR, major DL
2367	10"	Malus sp.	Crabapple	Poor	BD, VC
2368	32"	Quercus rubra	Red Oak	Fair	
2369	17"	Quercus rubra	Red Oak	Fair	
2370	10"	Juglans nigra	Black Walnut	Fair	
2371	13"	Ulmus sp.	Elm	Dead	
2372	10"	Acer negundo	Box Elder	Very Poor	DL, L, VC
2373	6"	Prunus serotina	Black Cherry	Very Poor	DL, NC
2374	6"	Quercus rubra	Red Oak	Poor	NC, VC
2376	18"	Fraxinus sp.	Ash	Dead	
2378	5"	Quercus rubra	Red Oak	Fair/Poor	Vines
2379	4"	Quercus alba	White Oak	Poor	BD, Vines
2380	16"	Juglans nigra	Black Walnut	Fair/Poor	Vines.
2381	14"	Juglans nigra	Black Walnut	Poor	Major BD
2382	13"	Juglans nigra	Black Walnut	Fair/Poor	BD
2383	5", 7', 9"	Malus sp.	Crabapple	Poor	Totally VC
2384	3", 5", 6"	Malus sp.	Crabapple	Fair/Poor	DL
2385	7"	Ulmus sp.	Elm	Poor	DL, OS, L
2386	3",5",6",11",12",16",16"	Acer negundo	Box Elder	Poor	BR, DL
2387	9", 11"	Acer negundo	Box Elder	Poor	BD, DL, Vines
2389	7"	Juniperus virginiana	Redcedar	Good	
2390	13"	Acer negundo	Box Elder	Poor	BD, DL
2391	6"	Sassafras albidum	Sassafras	Fair/Poor	NC
2392	9"	Ulmus sp.	Elm	Very Poor	Many DL, major BD

2393	9"	Sassafras albidum	Sassafras	Fair	
2397	7"	Sassafras albidum	Sassafras	Fair	
2398	6"	Sassafras albidum	Sassafras	Fair/Poor	NC
2399	8"	Sassafras albidum	Sassafras	Fair	
2400	8"	Sassafras albidum	Sassafras	Fair	
2401	6"	Sassafras albidum	Sassafras	Fair	
2402	6"	Sassafras albidum	Sassafras	Fair/Poor	NC
2403	10"	Sassafras albidum	Sassafras	Fair/Poor	os
2404	7"	Malus sp.	Crabapple	Very Poor	DL, M, NC
2405	10"	Prunus serotina	Black Cherry	Fair	
2406	6"	Sassafras albidum	Sassafras	Fair	
2407	9"	Prunus serotina	Black Cherry	Fair	
2408	6"	Malus sp.	Crabapple	Poor	M, OS, Vines
2409	8"	Prunus serotina	Black Cherry	Very Poor	DL, NC
2410	7"	Quercus alba	White Oak	Fair	
2411	29"	Prunus serotina	Black Cherry	Fair	
2412	33"	Quercus rubra	Red Oak	Fair	
2413	18"	Quercus rubra	Red Oak	Fair	
2414	5"	Quercus rubra	Red Oak	Poor	NC, VC
2415	5"	Quercus rubra	Red Oak	Poor	M, NC, Vines
2416	6"	Quercus rubra	Red Oak	Fair/Poor	NC
2417	11"	Quercus rubra	Red Oak	Poor	BR, Vines
2420	16"	Quercus rubra	Red Oak	Fair	
2421	4"	Prunus serotina	Black Cherry	Very Poor	BR, DL, NC
2422	7"	Prunus serotina	Black Cherry	Very Poor	Totally VC, NC
2423	5"	Quercus rubra	Red Oak	Fair	
2424	14"	Quercus rubra	Red Oak	Fair/Poor	BD
2425	13"	Quercus rubra	Red Oak	Fair/Poor	NC

			,		
2426	5"	Quercus rubra	Red Oak	Fair/Poor	Vines
2427	12"	Quercus rubra	Red Oak	Fair	
2428	6"	Quercus rubra	Red Oak	Fair/Poor	NC
2429	11"	Quercus rubra	Red Oak	Fair/Poor	Some DL, Vines
2430	6"	Quercus rubra	Red Oak	Poor	DL, NC, Vines
2431	7"	Quercus rubra	Red Oak	Fair/Poor	Vines.
2432	4", 15"	Ulmus sp.	Elm	Fair	
2433	8"	Quercus rubra	Red Oak	Fair/Poor	os
2434	25"	Quercus rubra	Red Oak	Fair	
2435	8", 10", 14"	Acer negundo	Box Elder	Poor	DL, L, UC
2436	12"	Ulmus sp.	Elm	Very Poor	Totally VC, NC
2437	10"	Ulmus sp.	Elm	Fair/Poor	DL
2438	23"	Juglans nigra	Black Walnut	Fair	
2439	3", 7"	Ulmus sp.	Elm	Poor	DL, NC, Vines
2440	11"	Malus sp.	Crabapple	Fair/Poor	L, OS
2441	6"	Ulmus sp.	Elm	Poor	LV, OS
2442	15"	Platanus occidentalis	Sycamore	Fair/Poor	Major BD
2443	10"	Populus deltoides	Cottonwood	Fair/Poor	NC
2445	21"	Ulmus sp.	Elm	Fair/Poor	os
2446	22"	Populus deltoides	Cottonwood	Fair	
2447	14"	Populus deltoides	Cottonwood	Fair/Poor	NC
2448	25"	Populus deltoides	Cottonwood	Fair	
2449	14"	Populus deltoides	Cottonwood	Very Poor	Major BD
2450	9", 11"	Populus deltoides	Cottonwood	Fair	
2451	7"	Ulmus sp.	Elm	Fair	
2452	5"	Ulmus sp.	Elm	Fair	
2453	9"	Malus sp.	Crabapple	Fair/Poor	Some BD, M
	164 Trees				

ABBREVIATIONS: BD: Bark damage; BR: Base rot; DL: Dead limbs; L: Leaning; LV: Lacks vigor; M: Misshapened; NC: Narrow crown; OS: One-sided; SR: Stem rot: VC; Vine covered; UC: Underdeveloped crown.

DEFINITIONS OF RATINGS:

Good: The tree appears to be in a healthy and satisfactory condition with an overall sound stem structure and with a full and balanced crown; the growth habit appears normal; there is no indication of pests or diseases present; and the life expectancy is judged to be greater than twenty-five (25) years. The rating based on the health / condition chart ranges from 30 to 24.

Fair: The tree appears to be in a healthy and satisfactory condition with a minimum of structural problems and with minor crown imbalance or thin crown; the growth habit appears normal; there is no indication of pests or diseases present; and the life expectancy is judged to be greater than twenty (20) years. The rating based on the health / condition chart ranges from 23 to 17. Fair/Poor: The tree appears to be in a satisfactory condition but exhibits a minor structural problem with crown imbalance, dead or dying limbs, or growth only in the top quarter of the tree; or the growth habit is misshapen and askew; or there is evidence of pests or diseases present. The rating based on the health

/ condition chart is 16 to 11. Poor: The tree appears to be in an unhealthy condition with structural problems and with major crown imbalance, dead or dying limbs, or growth only in the top quarter of the tree; the growth habit is misshapen and askew; there is evidence of pests or diseases present; and the life expectancy is judged to be less than ten (10) years. The rating based on the health / condition chart is 10 to 6. Very Poor: The tree appears to be in an unhealthy condition with major structural problems and with major crown imbalance and several dead limbs and/or peeling bark; the growth habit is severely misshapen and askew; there is evidence of pests or diseases present; and the life expectancy is judged to be less than five (5) years. The rating based on the health / condition chart ranges from 5 to 1.

Dead: The tree has no live branches, is topped, or fallen. The rating based on the health / condition

Va	alues Best	5 4	3	2	1	0	Worst
1	Trunk	Sound & solid	Sections of bark missing		Extensive decay & hollow		
2	Growth rate	> 6" twig elongation	2" - 6" twig elongation		< 2" twig elongation		
3	Structure	Sound	One major or several minor limbs dead		Two or more major limbs d	ead	
4	Insects & Diseases	No pests present	One pest present		Two or more pests present		
5	Crown Development	Full & balanced	Full but unbalanced		Unbalanced and lacking a	full cı	rown
6	Life Expectancy	> 30 years	15 years to 20 years		< 5 years		

Tree Inventory prepared by: Nagy Devlin Land Design, L.L.C., J. Brian Devlin R.L.A. #1260



Not to Be Used as Construction Drawings City File Number #21-002 Section #01

	VC				
	DL, M, Vines				
or	M, Vines				
or	Major BR, major DL				
	BD, VC				
or	DL, L, VC				
or	DL, NC				
	NC, VC				
or	Vines				
	BD, Vines			~	_
or	Vines.			77	プローグニョン しつく
	Major BD			ę	ر کار
or	BD			;	
	Totally VC			(
or	DL			?	
	DL, OS, L			Ì	ر ا ا
	BR, DL			1,	-}
	BD, DL, Vines				_
					コス
	BD, DL				7
or	NC			1	$\vec{\gamma}$
		I	l	U	- 1

TEON C. *=


SUJAK *=


ENGINEER *= NO. 046896 Teon C. Sujak, P.L. No. 046896

930 Mead Rd ochester Hills. MI 48306 Parcel # 15-02-200-016

None Checked: TCS 3/26/2021

21-008

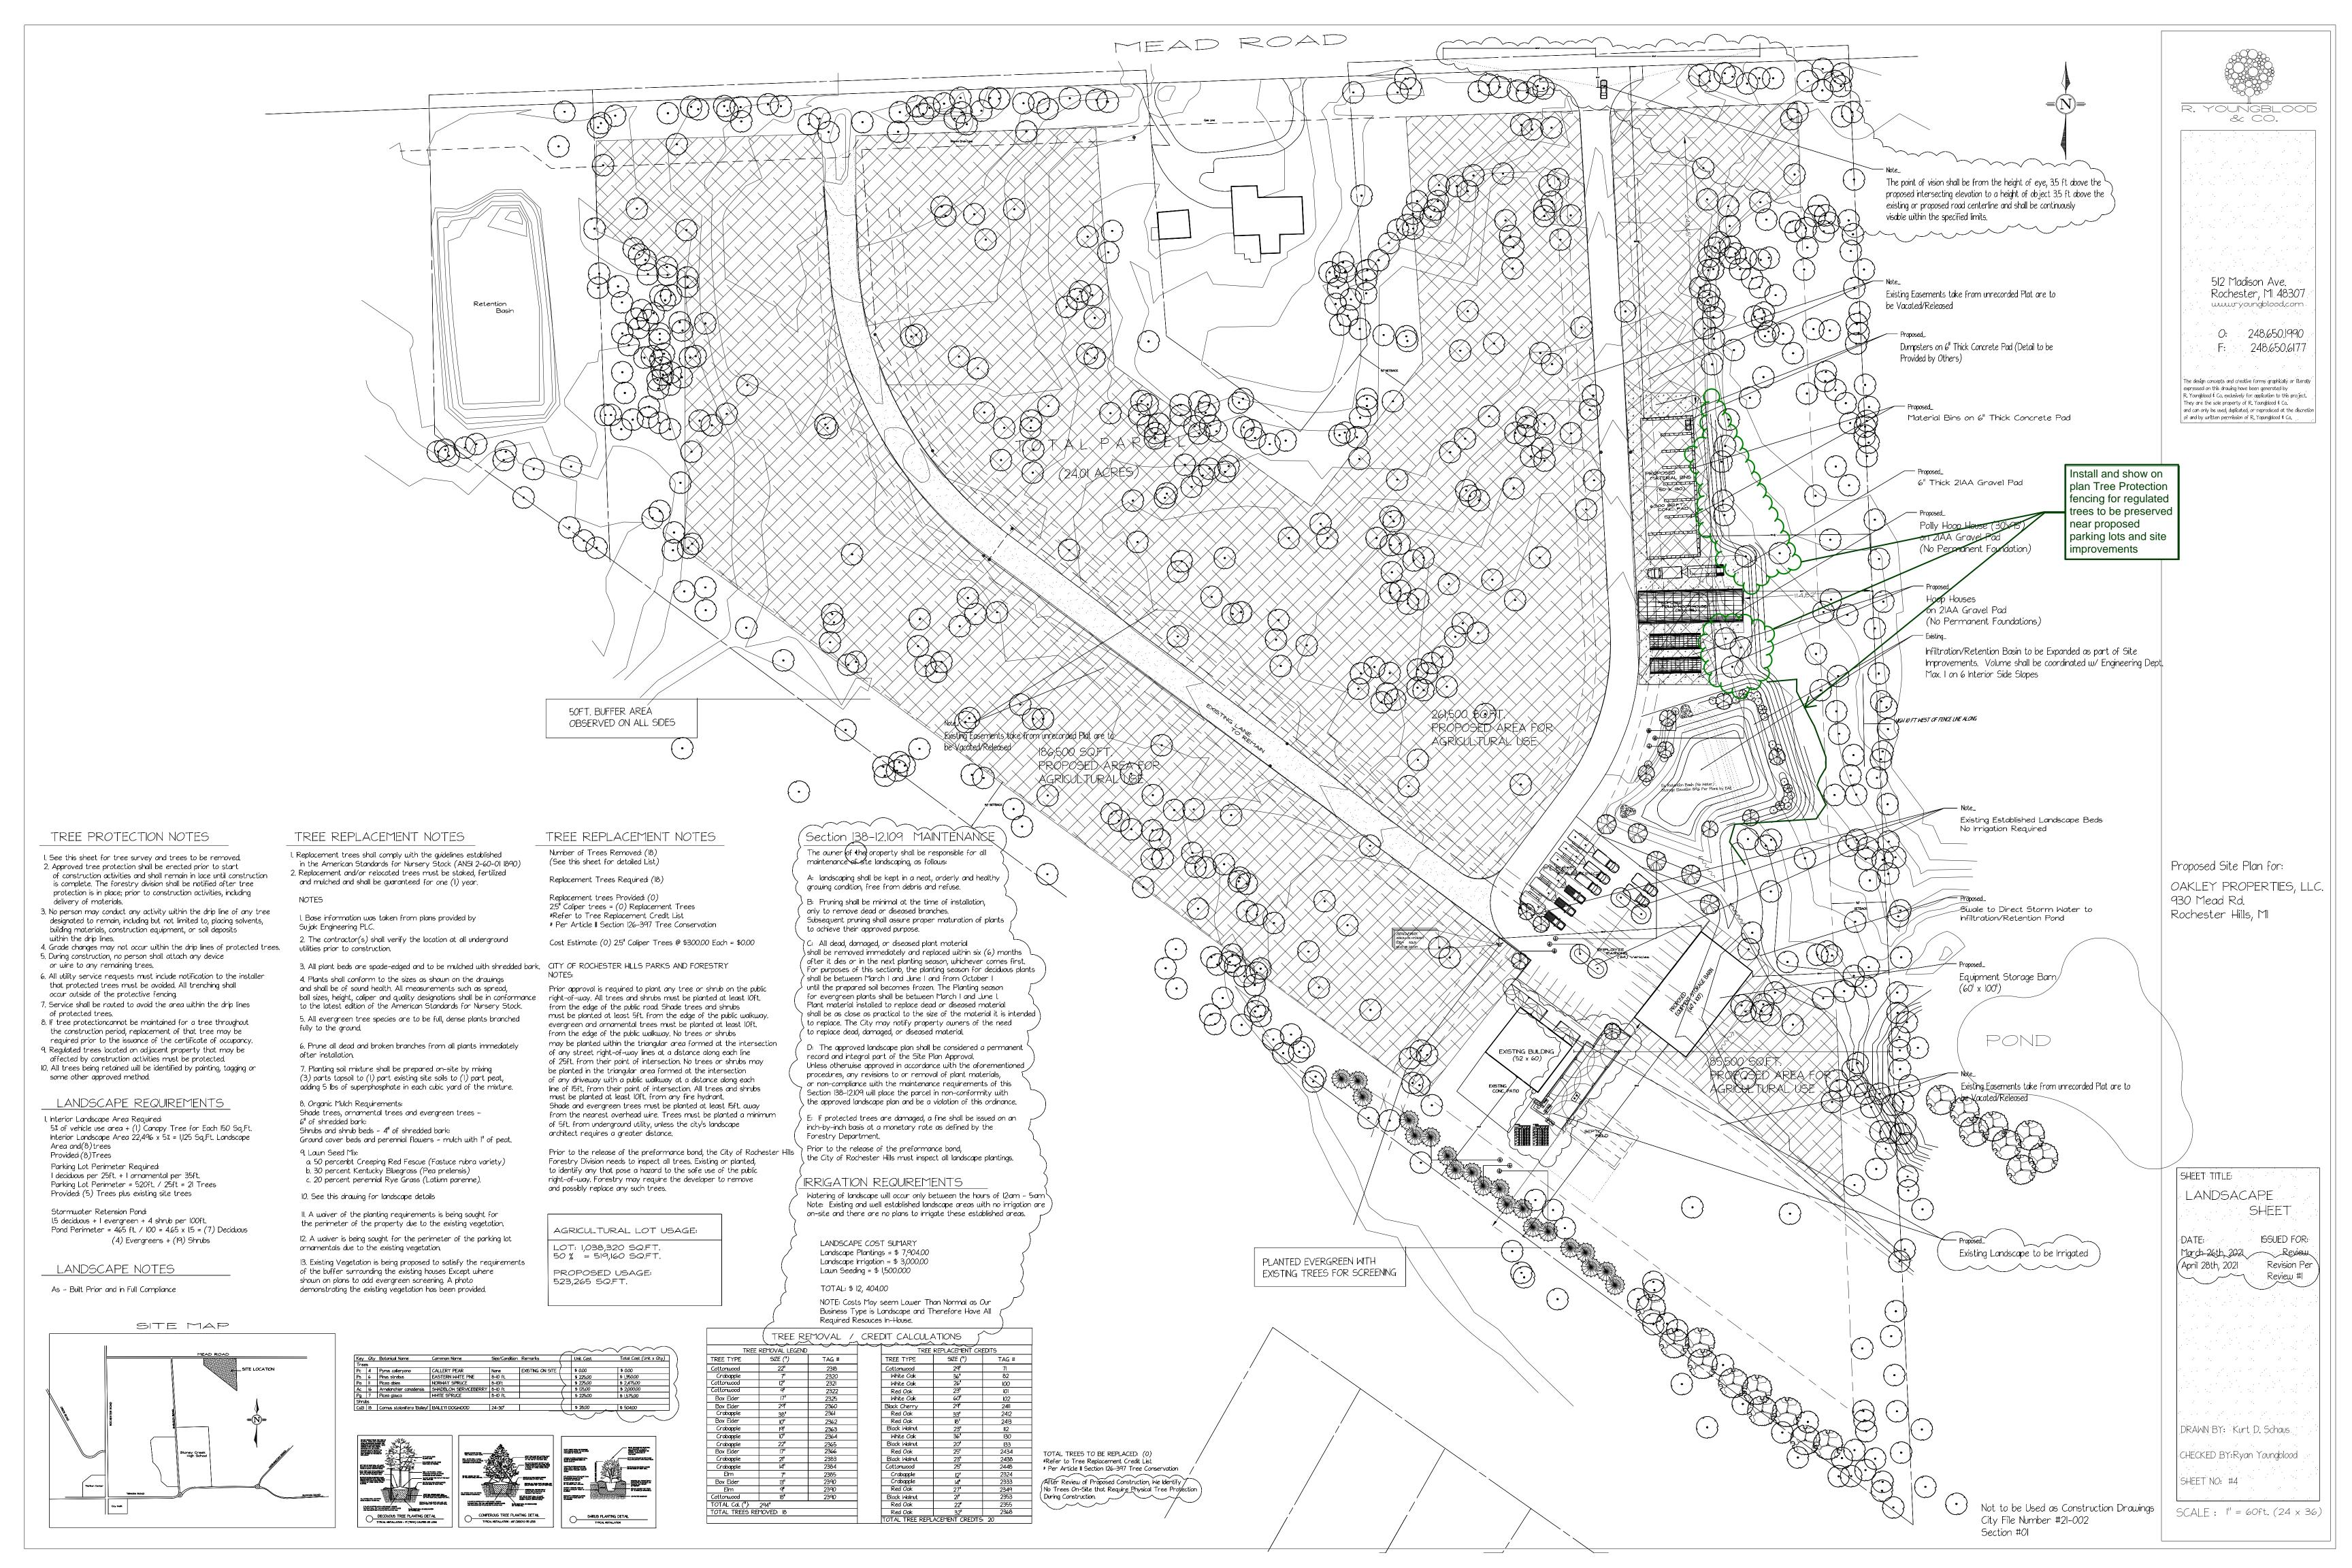

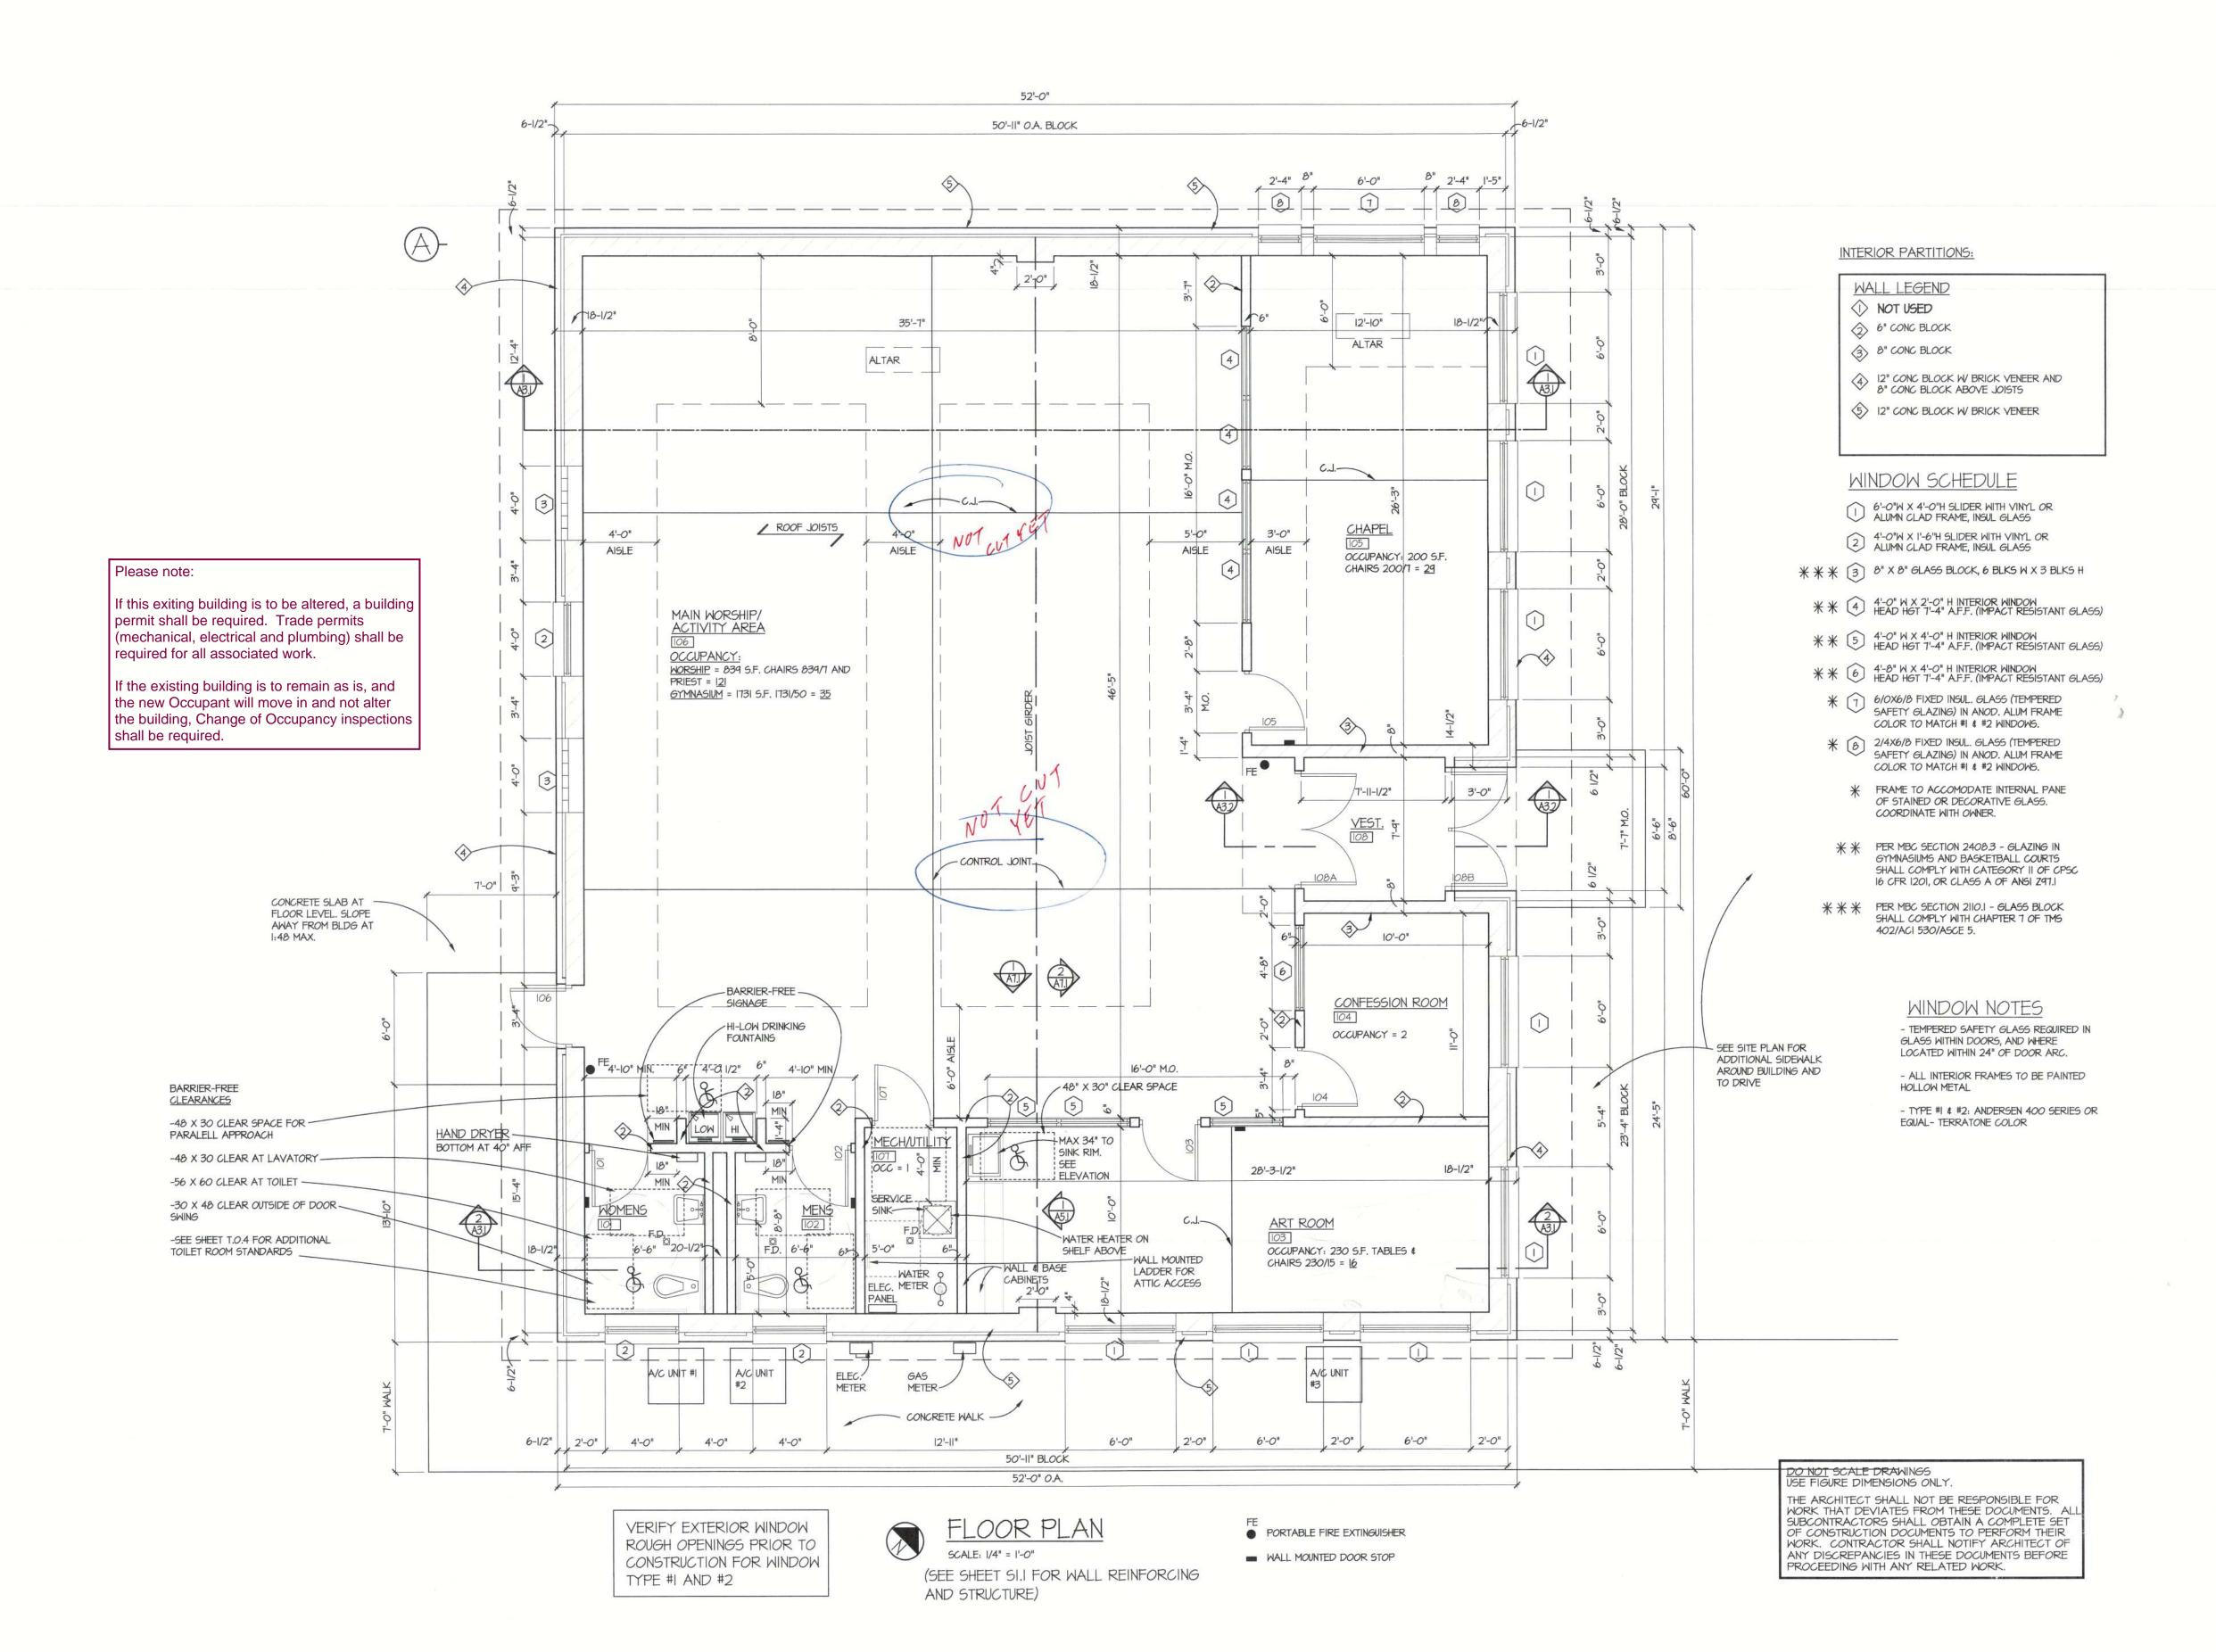

ARCHITECTS, P.C. 7341 Triangle Drive Sterling Heights, MI 48314 (586)803-1410



DATE MISCALLANEOUS SHETS ISSUED BY DIAS AUCH LANEOUS SHETS A

 DATE
 FULL SETS ISSUED FOR
 BY

 2/21/12
 REVIEW
 DLM

 03/21/12
 BP
 DHS

 05/23/12
 BIDS
 DHS


 06/26/12
 B.P. RESUB
 DAS

 06/26/12
 B.P. RESUB
 DAS

N BUILDING FOR: MAS THEMES MORSHIP YOUTH CENTER MEAD ROAD


Architect for Gilliam Home 2006

MAKEOVER
HOME EDITION

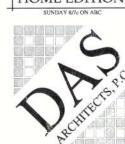

JOB NUMBER 3059-811 FLOOR

SHEET NO.

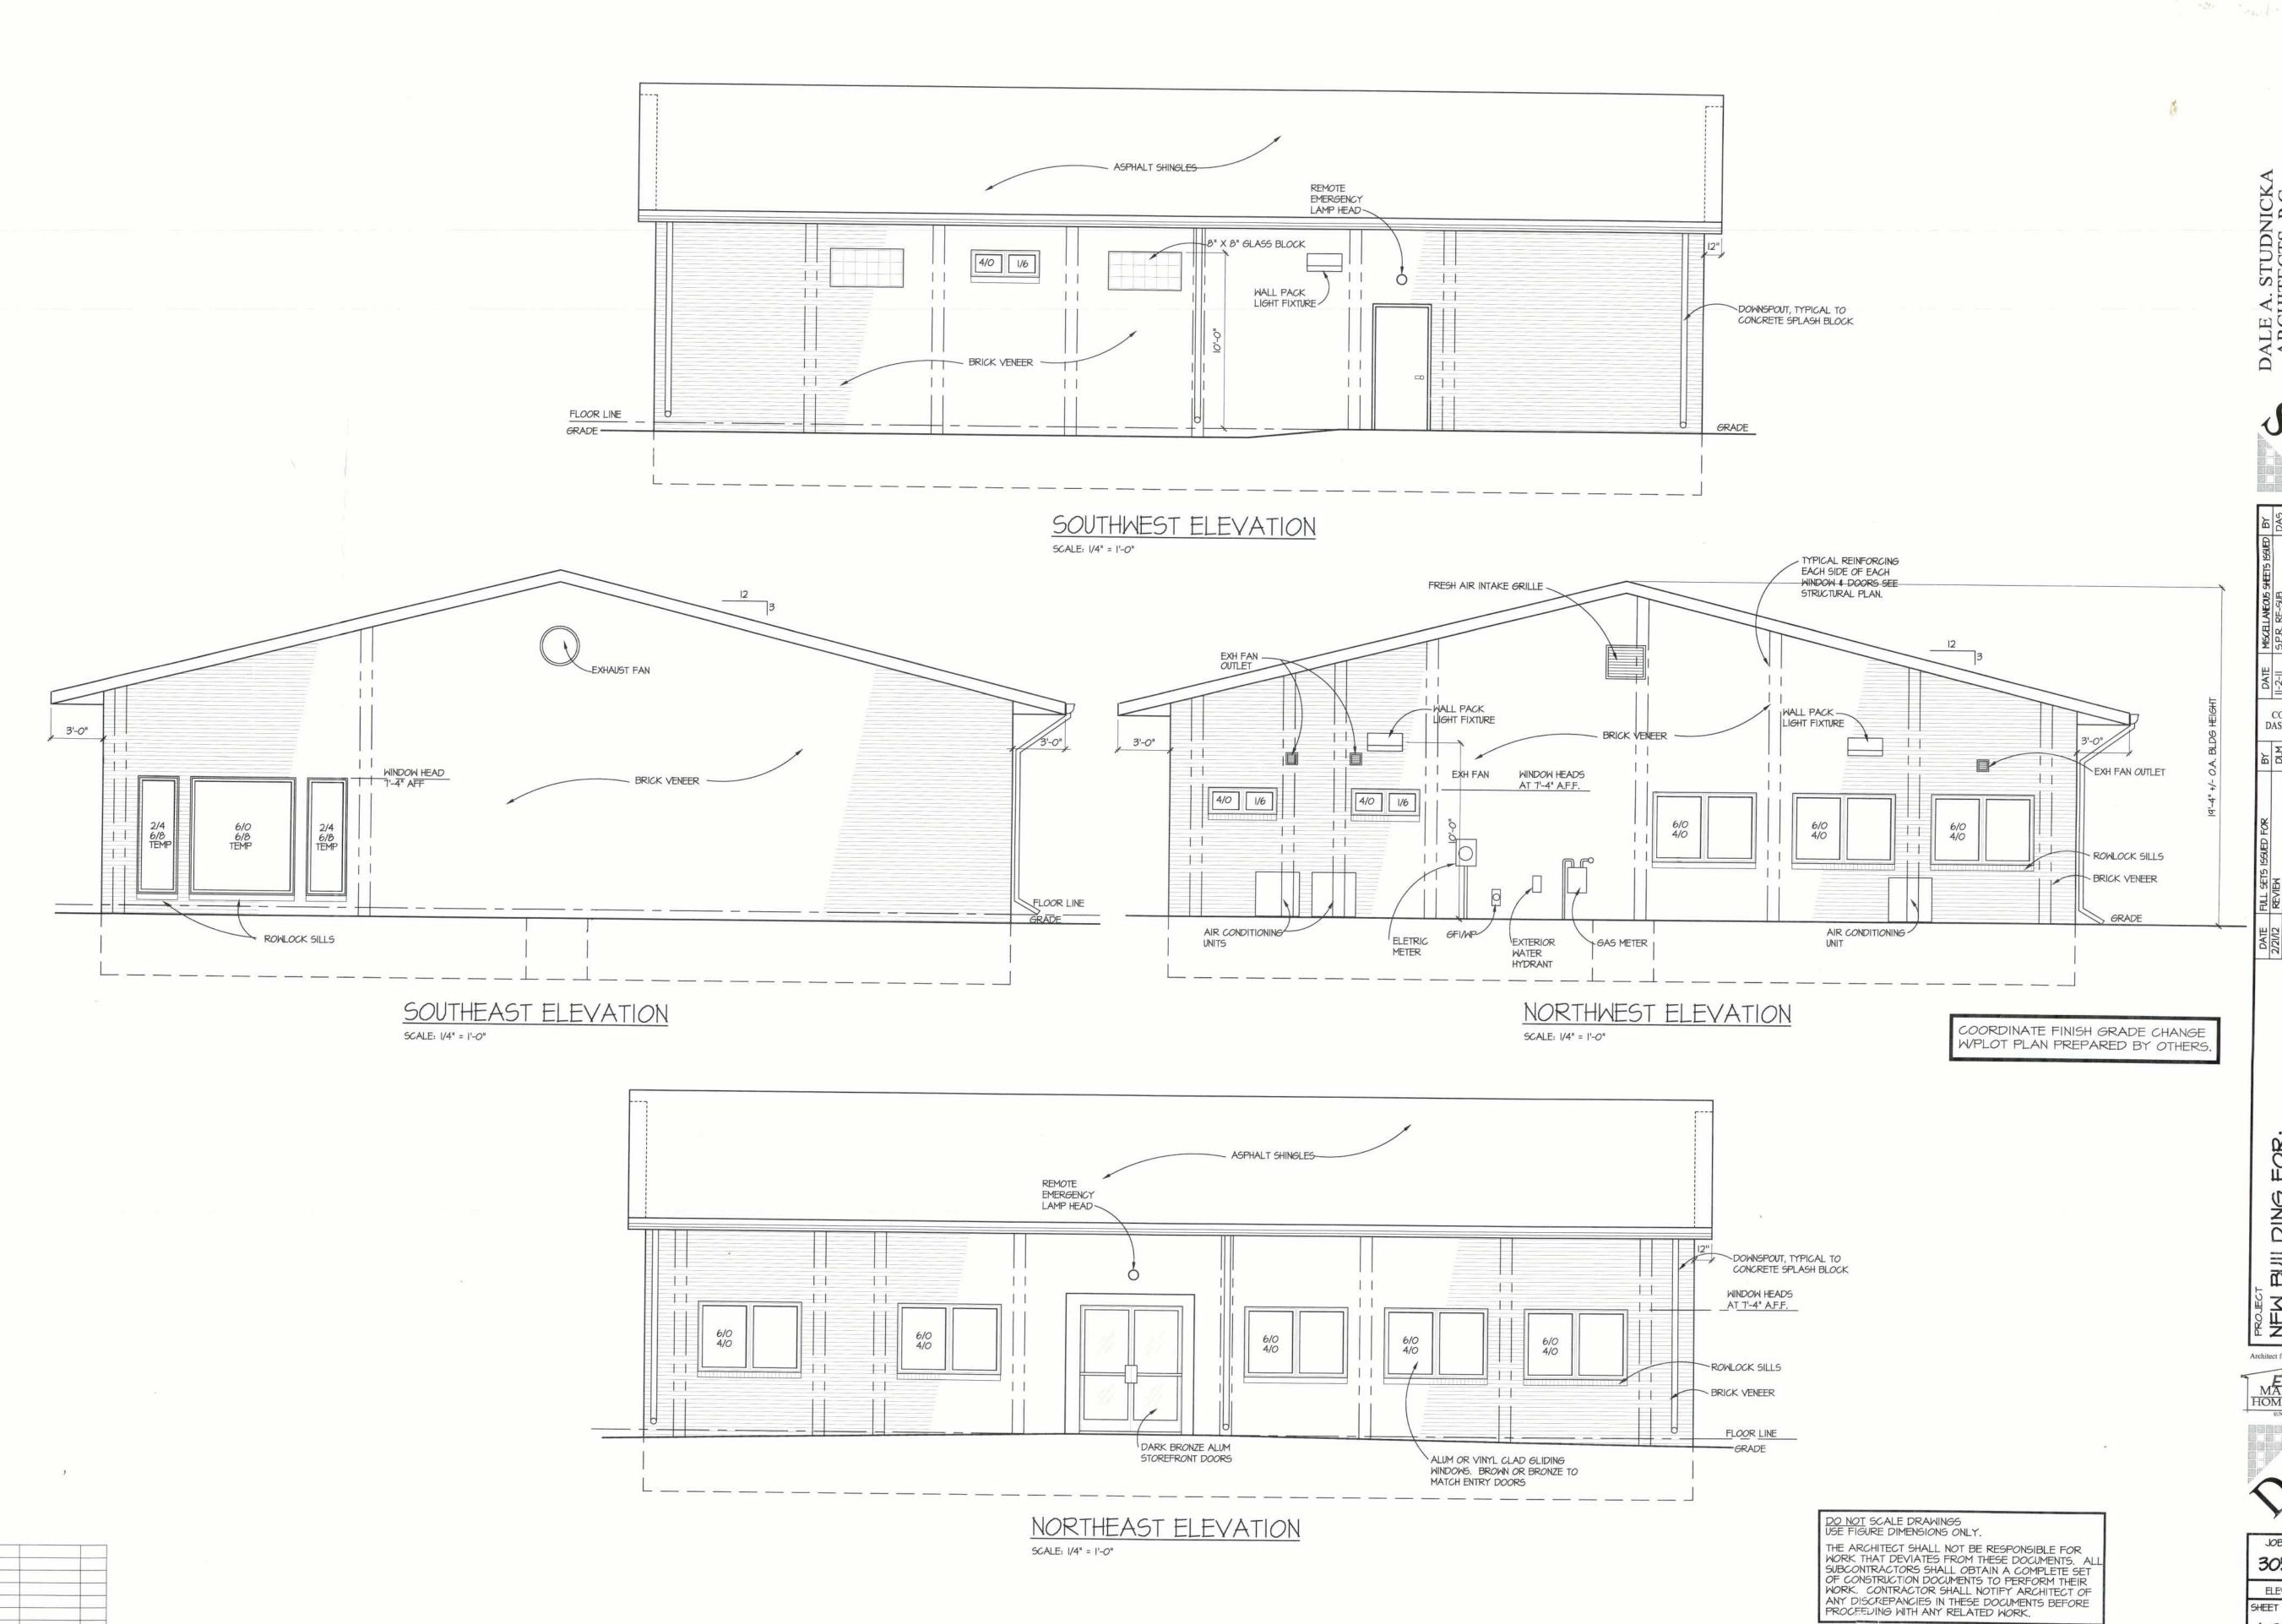



COPYRIGHT 2010 DAS ARCHITECTS, P.C. BY DLM DHS DAS DATE FULL SET 2/21/12 REVIEW 03/27/12 BP 05/23/12 BIDS 06/26/12 BIP RES

MAKEOVER HOME EDITION

JOB NUMBER 3059-811 ELEV

SHEET NO. A2.1

