



R-2 SETBACKS:					
	REQUIRED	AVERAGE			
		PROVIDED			
Т	40'	40'			
	15'/15'	15'/15'			
	35'	35'			
WIDTH	100'	100.45'			
SIZE	15,000 SF	15,120 SF			

LOT TABLE:							
ACCORDING TO LOT SIZE VARIATION SECTION 138-5.200							
LOT #	AREA	FRONT SETBACK	SIDE SETBACK	BACK SETBACK	FRONTAGE		
1	13,515 SF	40'	15'	35'	126.32'		
2	13,512 SF	40'	15'	35'	123.70'		
3	13,948 SF	40'	15'	35'	93.00'		
4	13,948 SF	40'	15'	35'	93.00'		
5	13,948 SF	40'	15'	35'	93.00'		
6	13,948 SF	40'	15'	35'	93.00'		
7	13,948 SF	40'	15'	35'	93.00'		
8	13,948 SF	40'	15'	35'	93.00'		
9	17,670 SF	40'	15'	66'	93.00'		
10	17,670 SF	40'	15'	40'	93.00'		
11	20,270 SF	40'	15'	40'	111.00'		
TOTAL	166,325 SF	\geq	\geq	\geq	1105.02'		
AVERAGE	15,120 SF	40'	15'	35'	100.45'		


					C. Cost	
20	00		Department	Reviewer	A Carro	ons
(FRONTAGE			Chris Mcl	eod 248-	841-2572
	126.32'		Planning	mcleodc@	Rocheste	841-2572 PrHills.org
	123.70'		Duilding	Mark Artini	an 248 <mark>-</mark> 8	41-2446
	93.00'		Building	ArtinianM@	Rochest	terHills.org 📐
	93.00'		Engineering	Jason E	oughton	248-841-2490
	93.00'		Lingineening	Boughto	onJ@Roc	hesterHills.org
	93.00'		Traffic	Keith	Depp 2	48-841-2503
	93.00'		Tunio			sterHills.org
	93.00'		Nat. Resources	Matt Ein		248-841-2551
	93.00'					hesterHills.org
	93.00'		Fire			248-841-2
	111.00'		1110	MurphyV	V@Roche	esterHills.org
\langle	1105.02'			City of F	oches	ter Hills
	100.45'		Dlann			Developm
		J	Fiaiiii			Developii
			Conditions an	d mark-ups n	oted throug	ghout the plan s
				addressed p		
				-		
				10000		
-		SED BUIL	and the second sec		22-000	
		SED DRAI	ROCHESTER	PSP20)22-000	5 City c
	PROPO	SED EASE	HILLS	Revi	sion 5	Plan

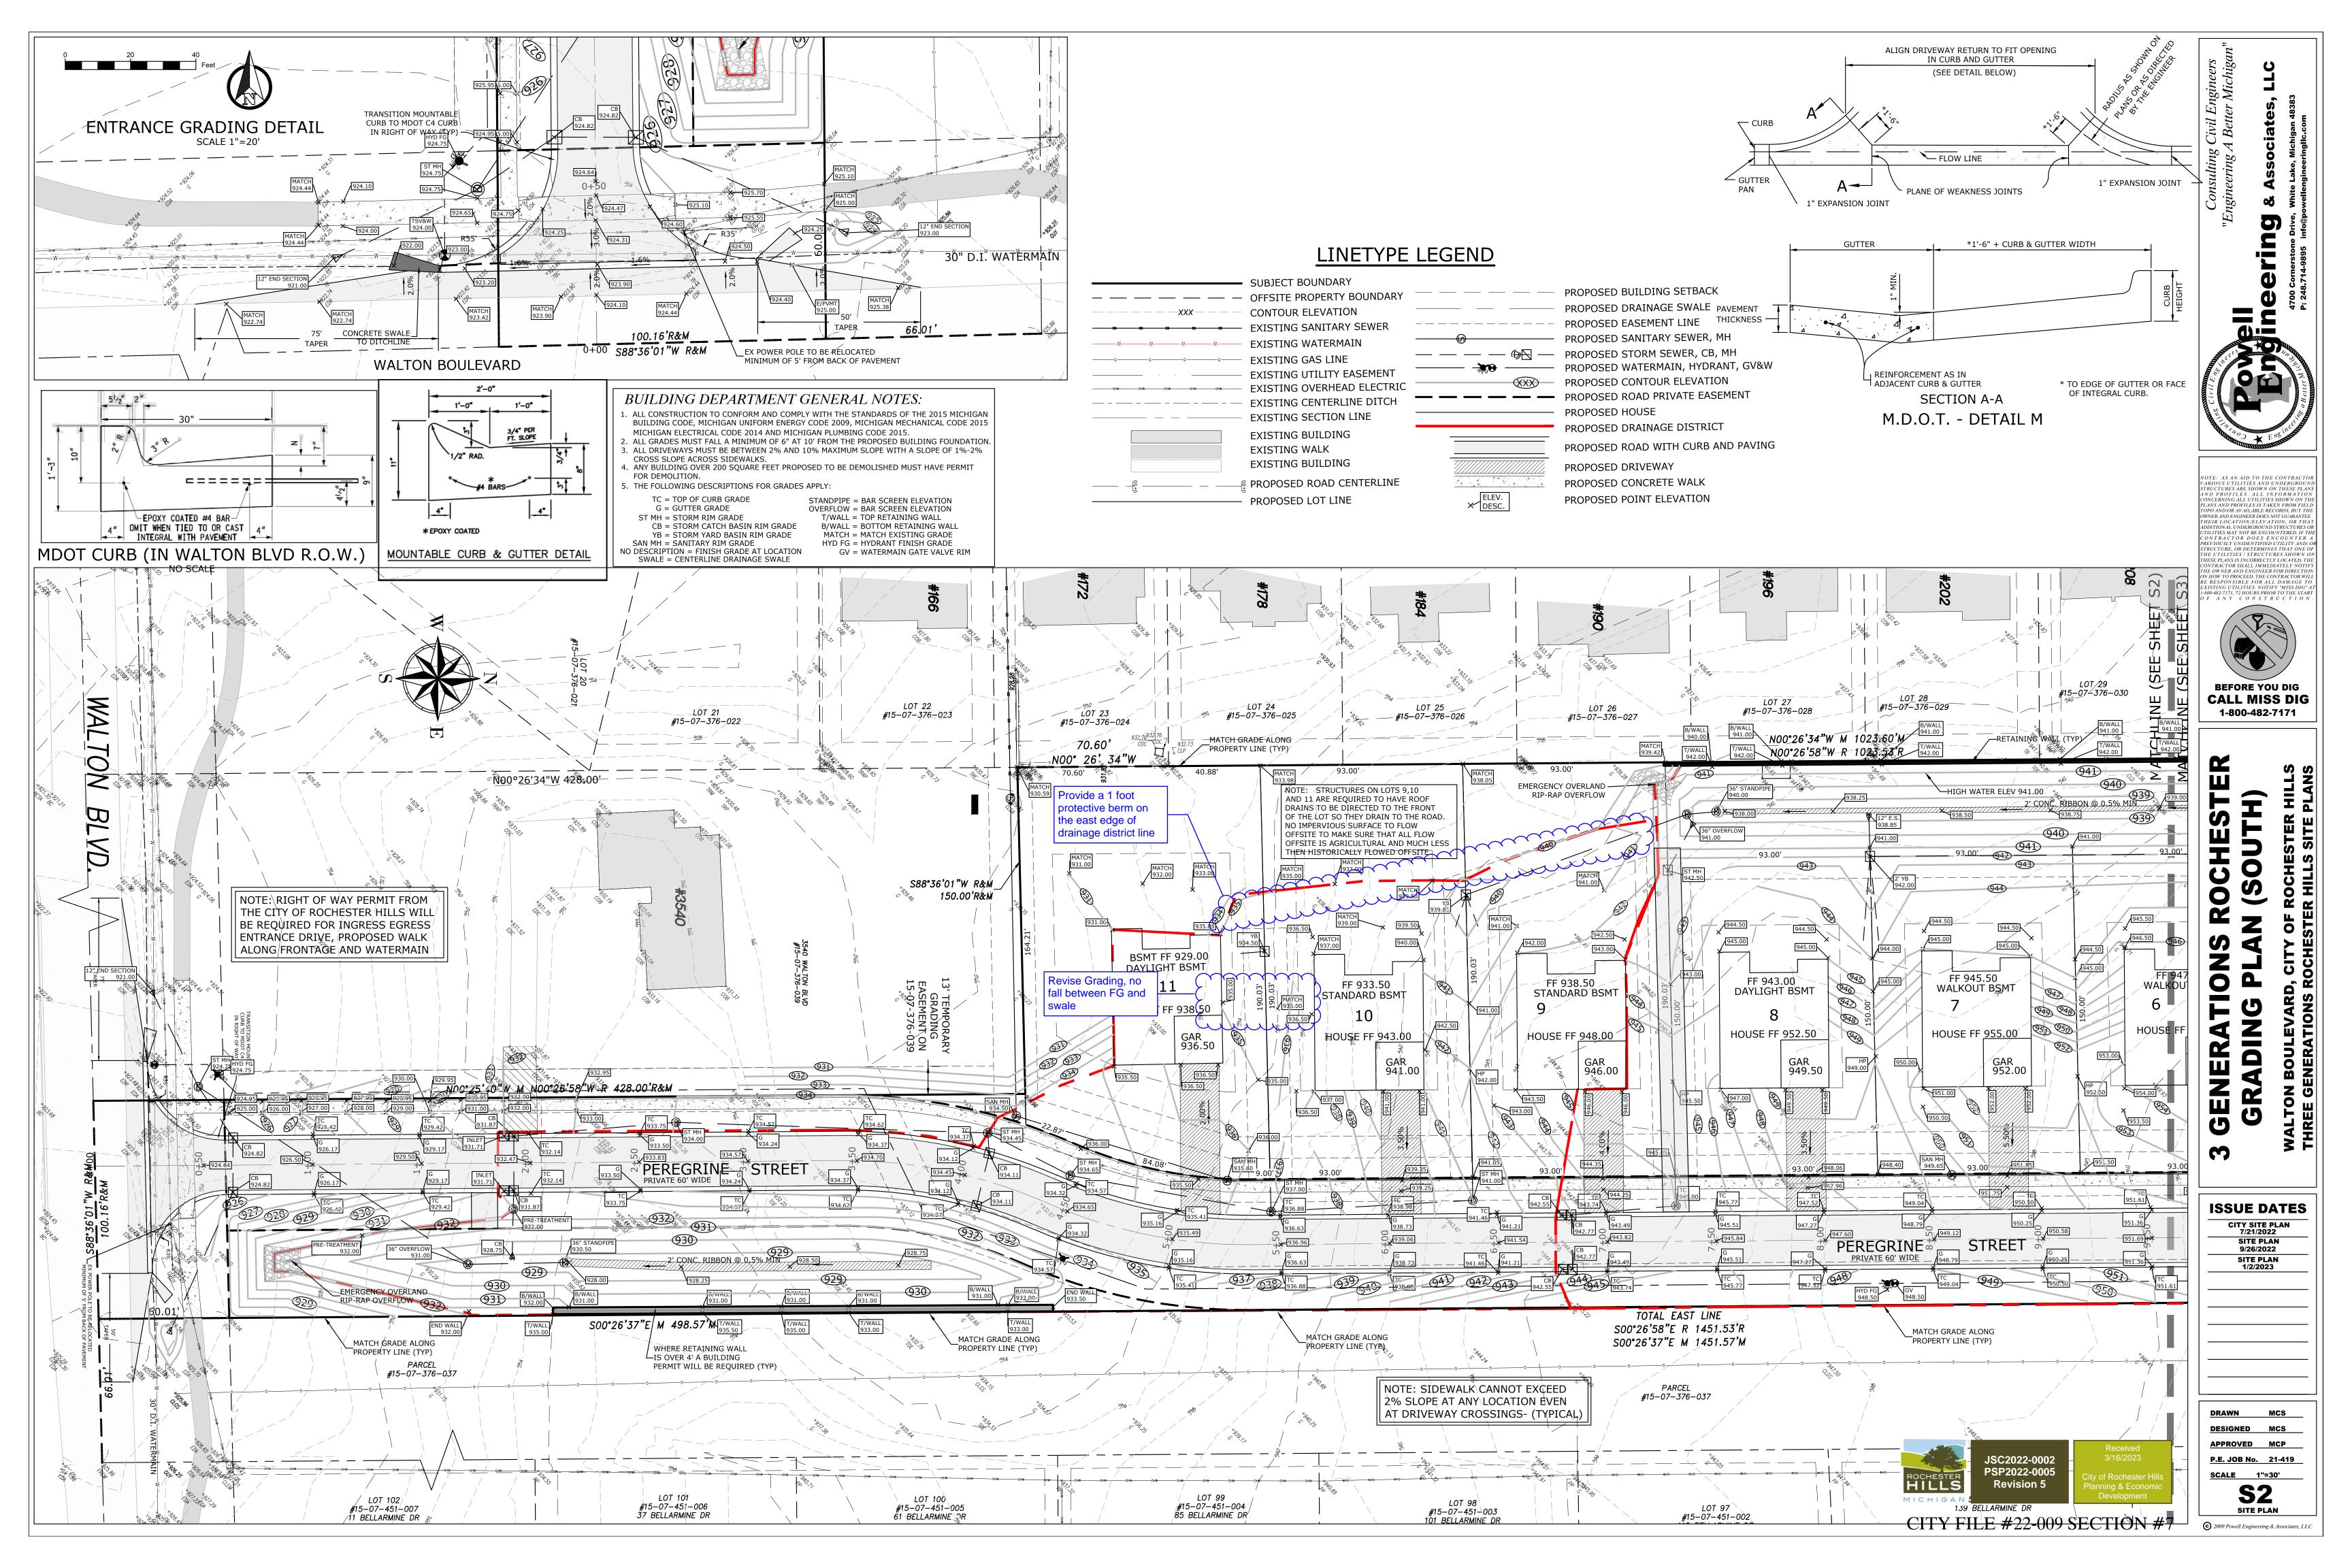

LINETYPE LEGEND

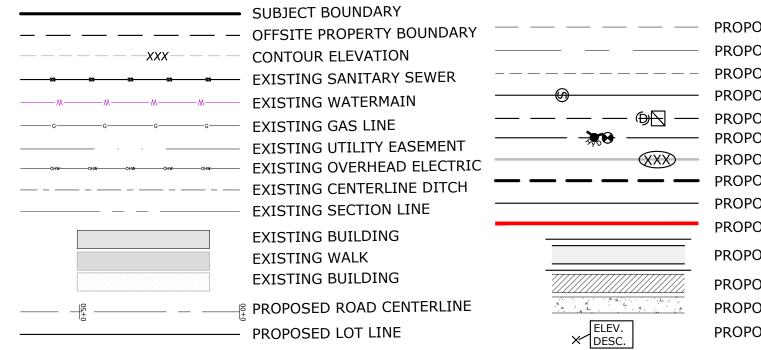

PROPOSED BUILDING SETBACK PROPOSED DRAINAGE SWALE PROPOSED EASEMENT LINE PROPOSED SANITARY SEWER, MH — PROPOSED STORM SEWER, CB, MH PROPOSED WATERMAIN, HYDRANT, GV&W PROPOSED CONTOUR ELEVATION PROPOSED ROAD PRIVATE EASEMENT PROPOSED HOUSE PROPOSED DRAINAGE DISTRICT PROPOSED ROAD WITH CURB AND PAVING PROPOSED DRIVEWAY PROPOSED CONCRETE WALK PROPOSED POINT ELEVATION

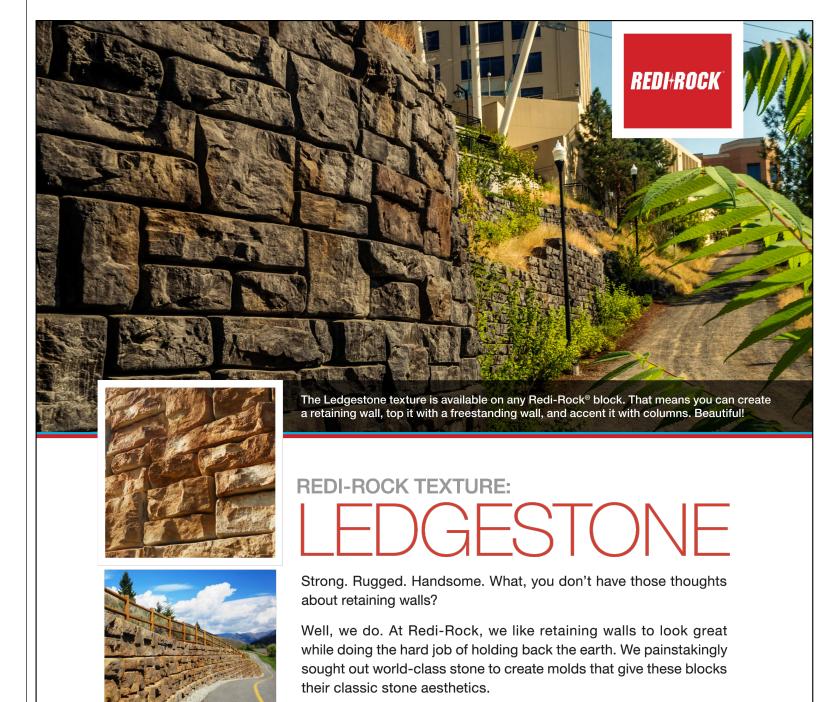

Redi-Rock Ledgestone blocks give projects a random, stacked stone look. Because they're made using architectural-grade precast concrete, the level of detail in the texture is outstanding.

Ledgestone Block Specifications

Trapezoidal shape allows convex and concave radii • 5.5 inch (140 millimeter) deep texture

• Colors can be formulated based


upon local region


- Ten individual face molds offer up to 115 square feet (10.5 square meters) of non-repeating patterns
- Wet-cast concrete gives a greater level of detail and durability


Regional colors and coordinating accessories are available. Contact your local Redi-Rock retailer or visit **redi-rock.com** to learn more about the Redi-Rock Ledgestone face today!


RETAINING WALL NOTES:


- 1. ALL RETAINING WALLS OVER 42" IN HEIGHT WILL REQUIRE A 42" HIGH PROTECTIVE FENCING.
- 2. ALL RETAINING WALLS OVER 48" IN HEIGHT OR GREATER WILL NEED TO BE
- STRUCTURALLY ENGINEERED.

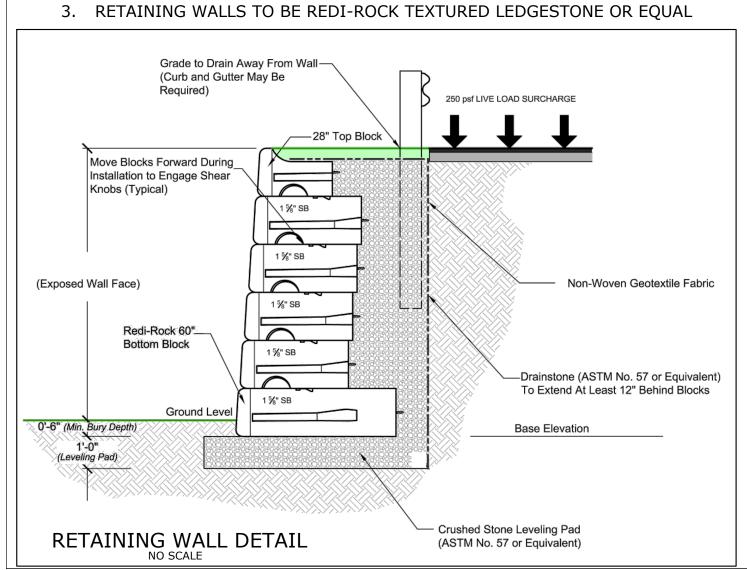


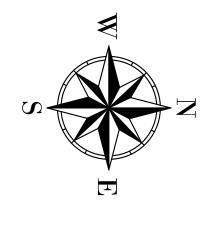

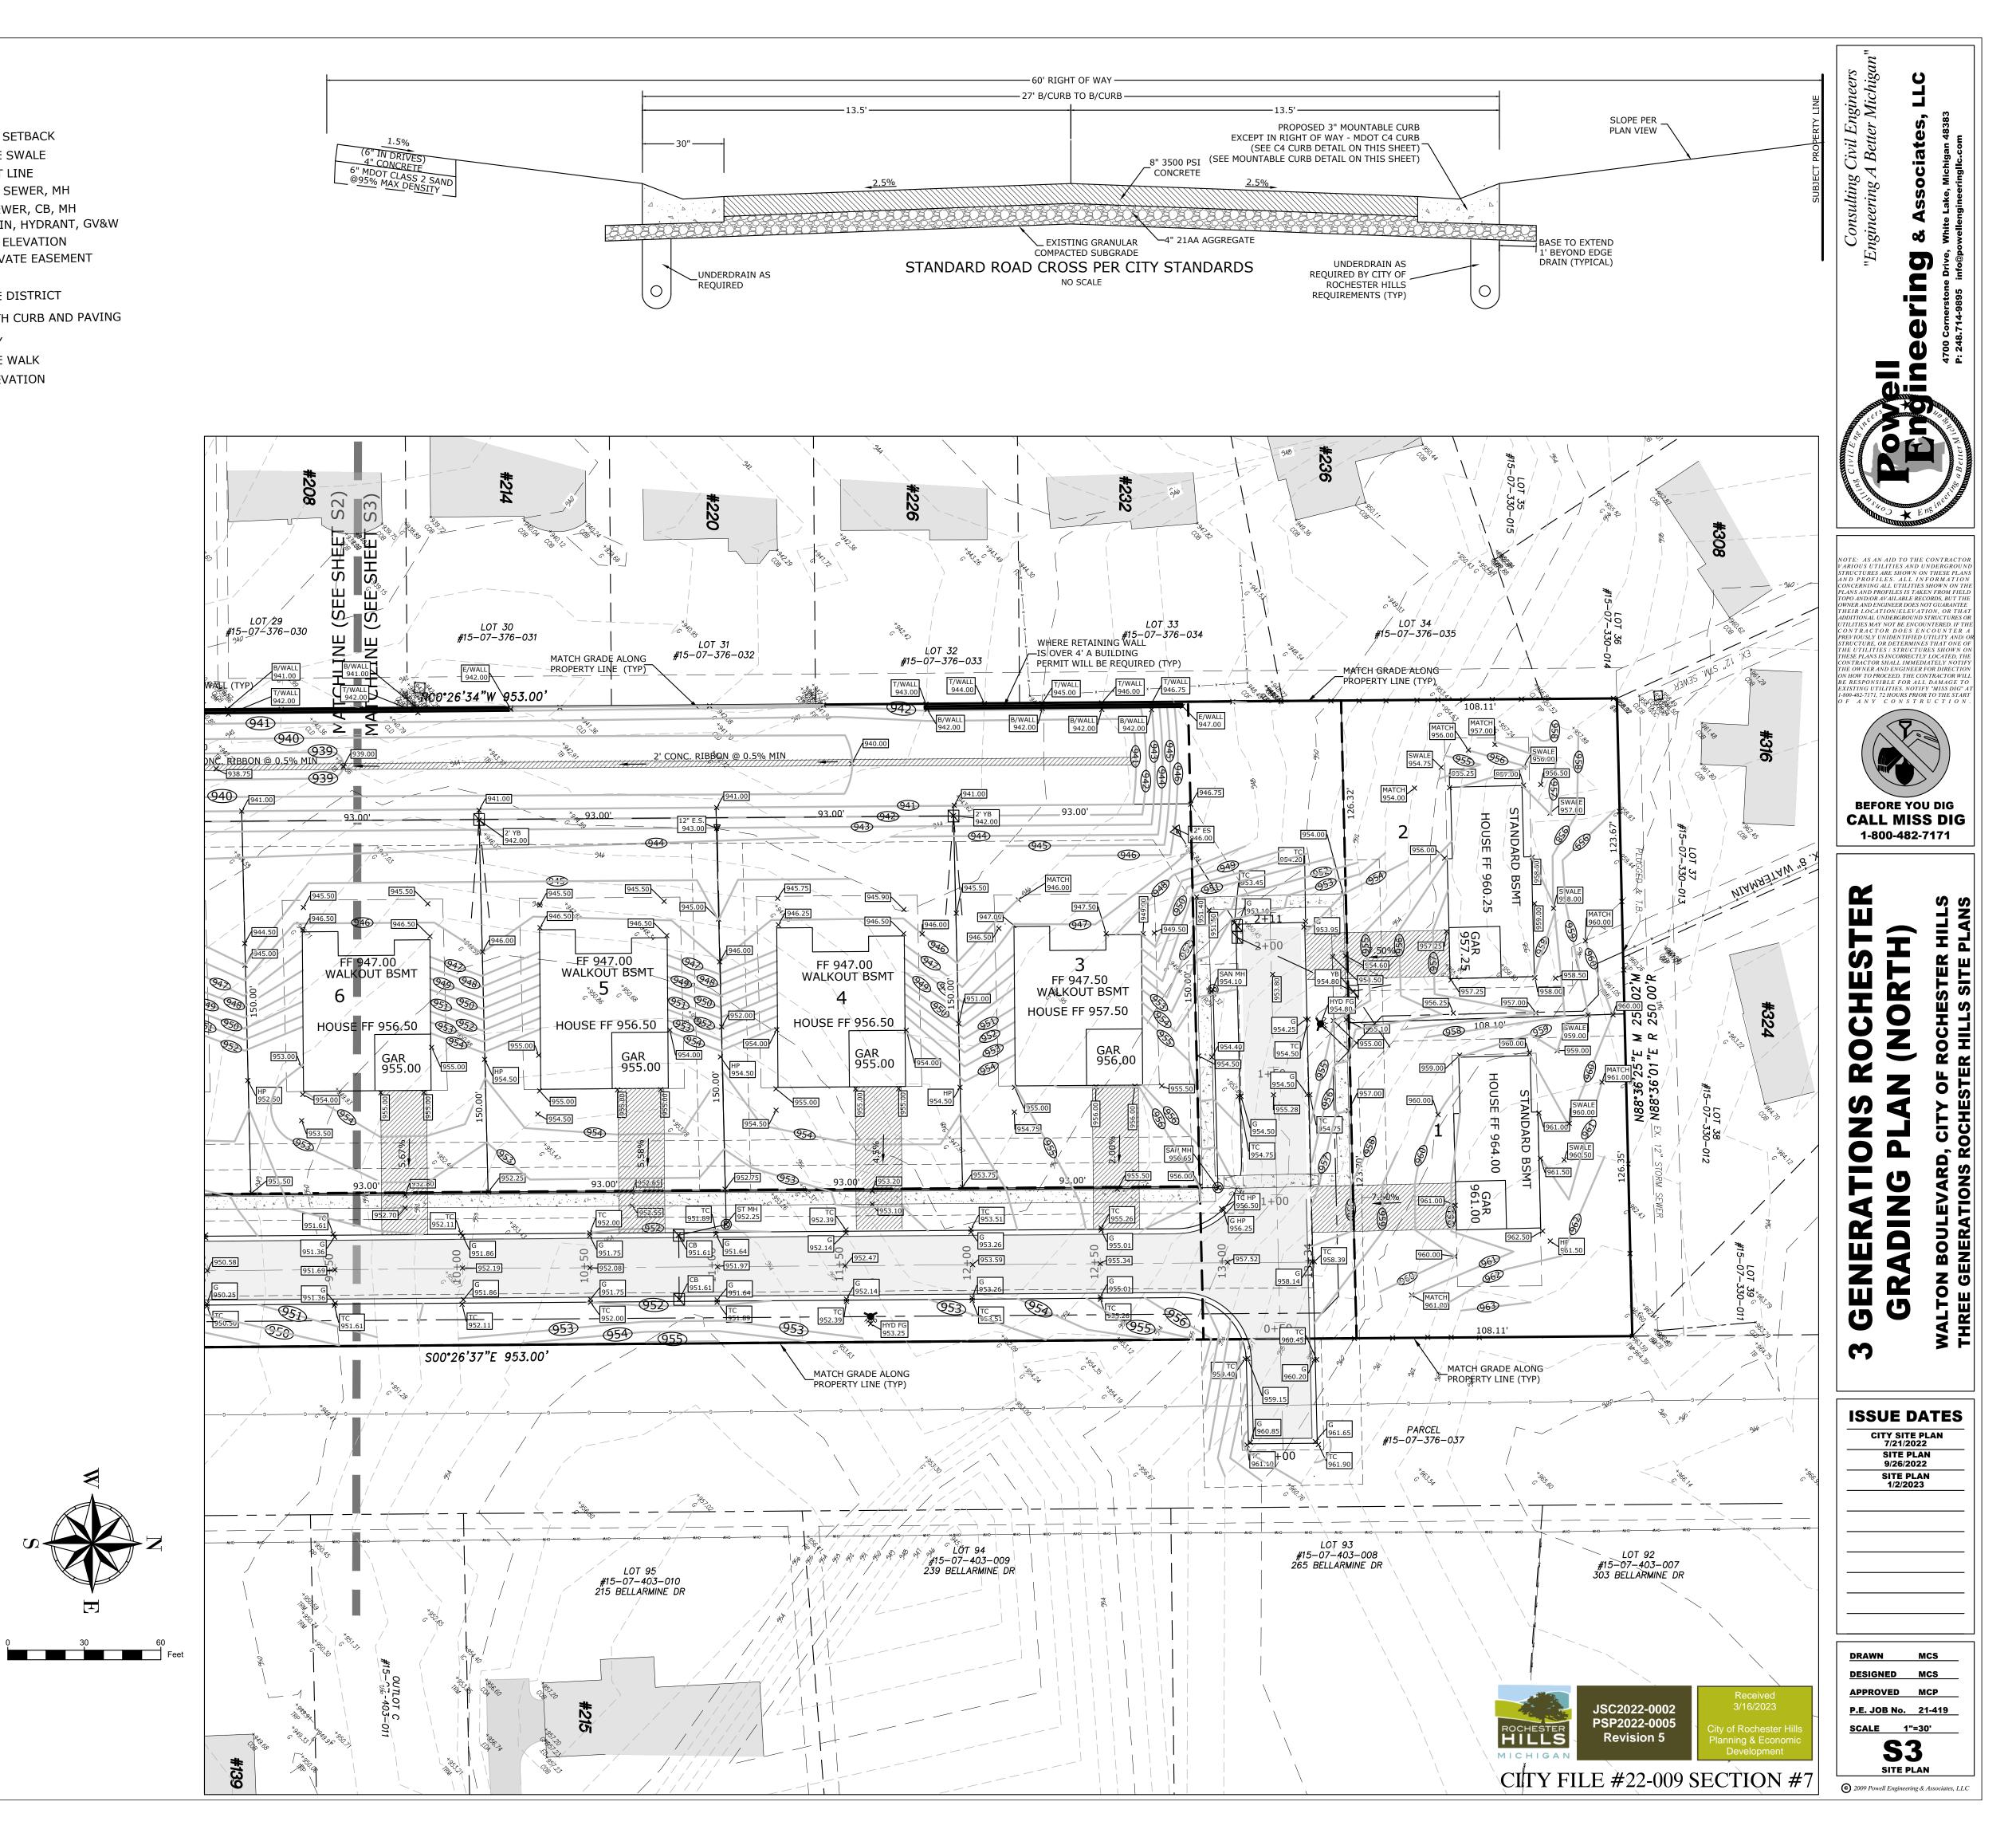

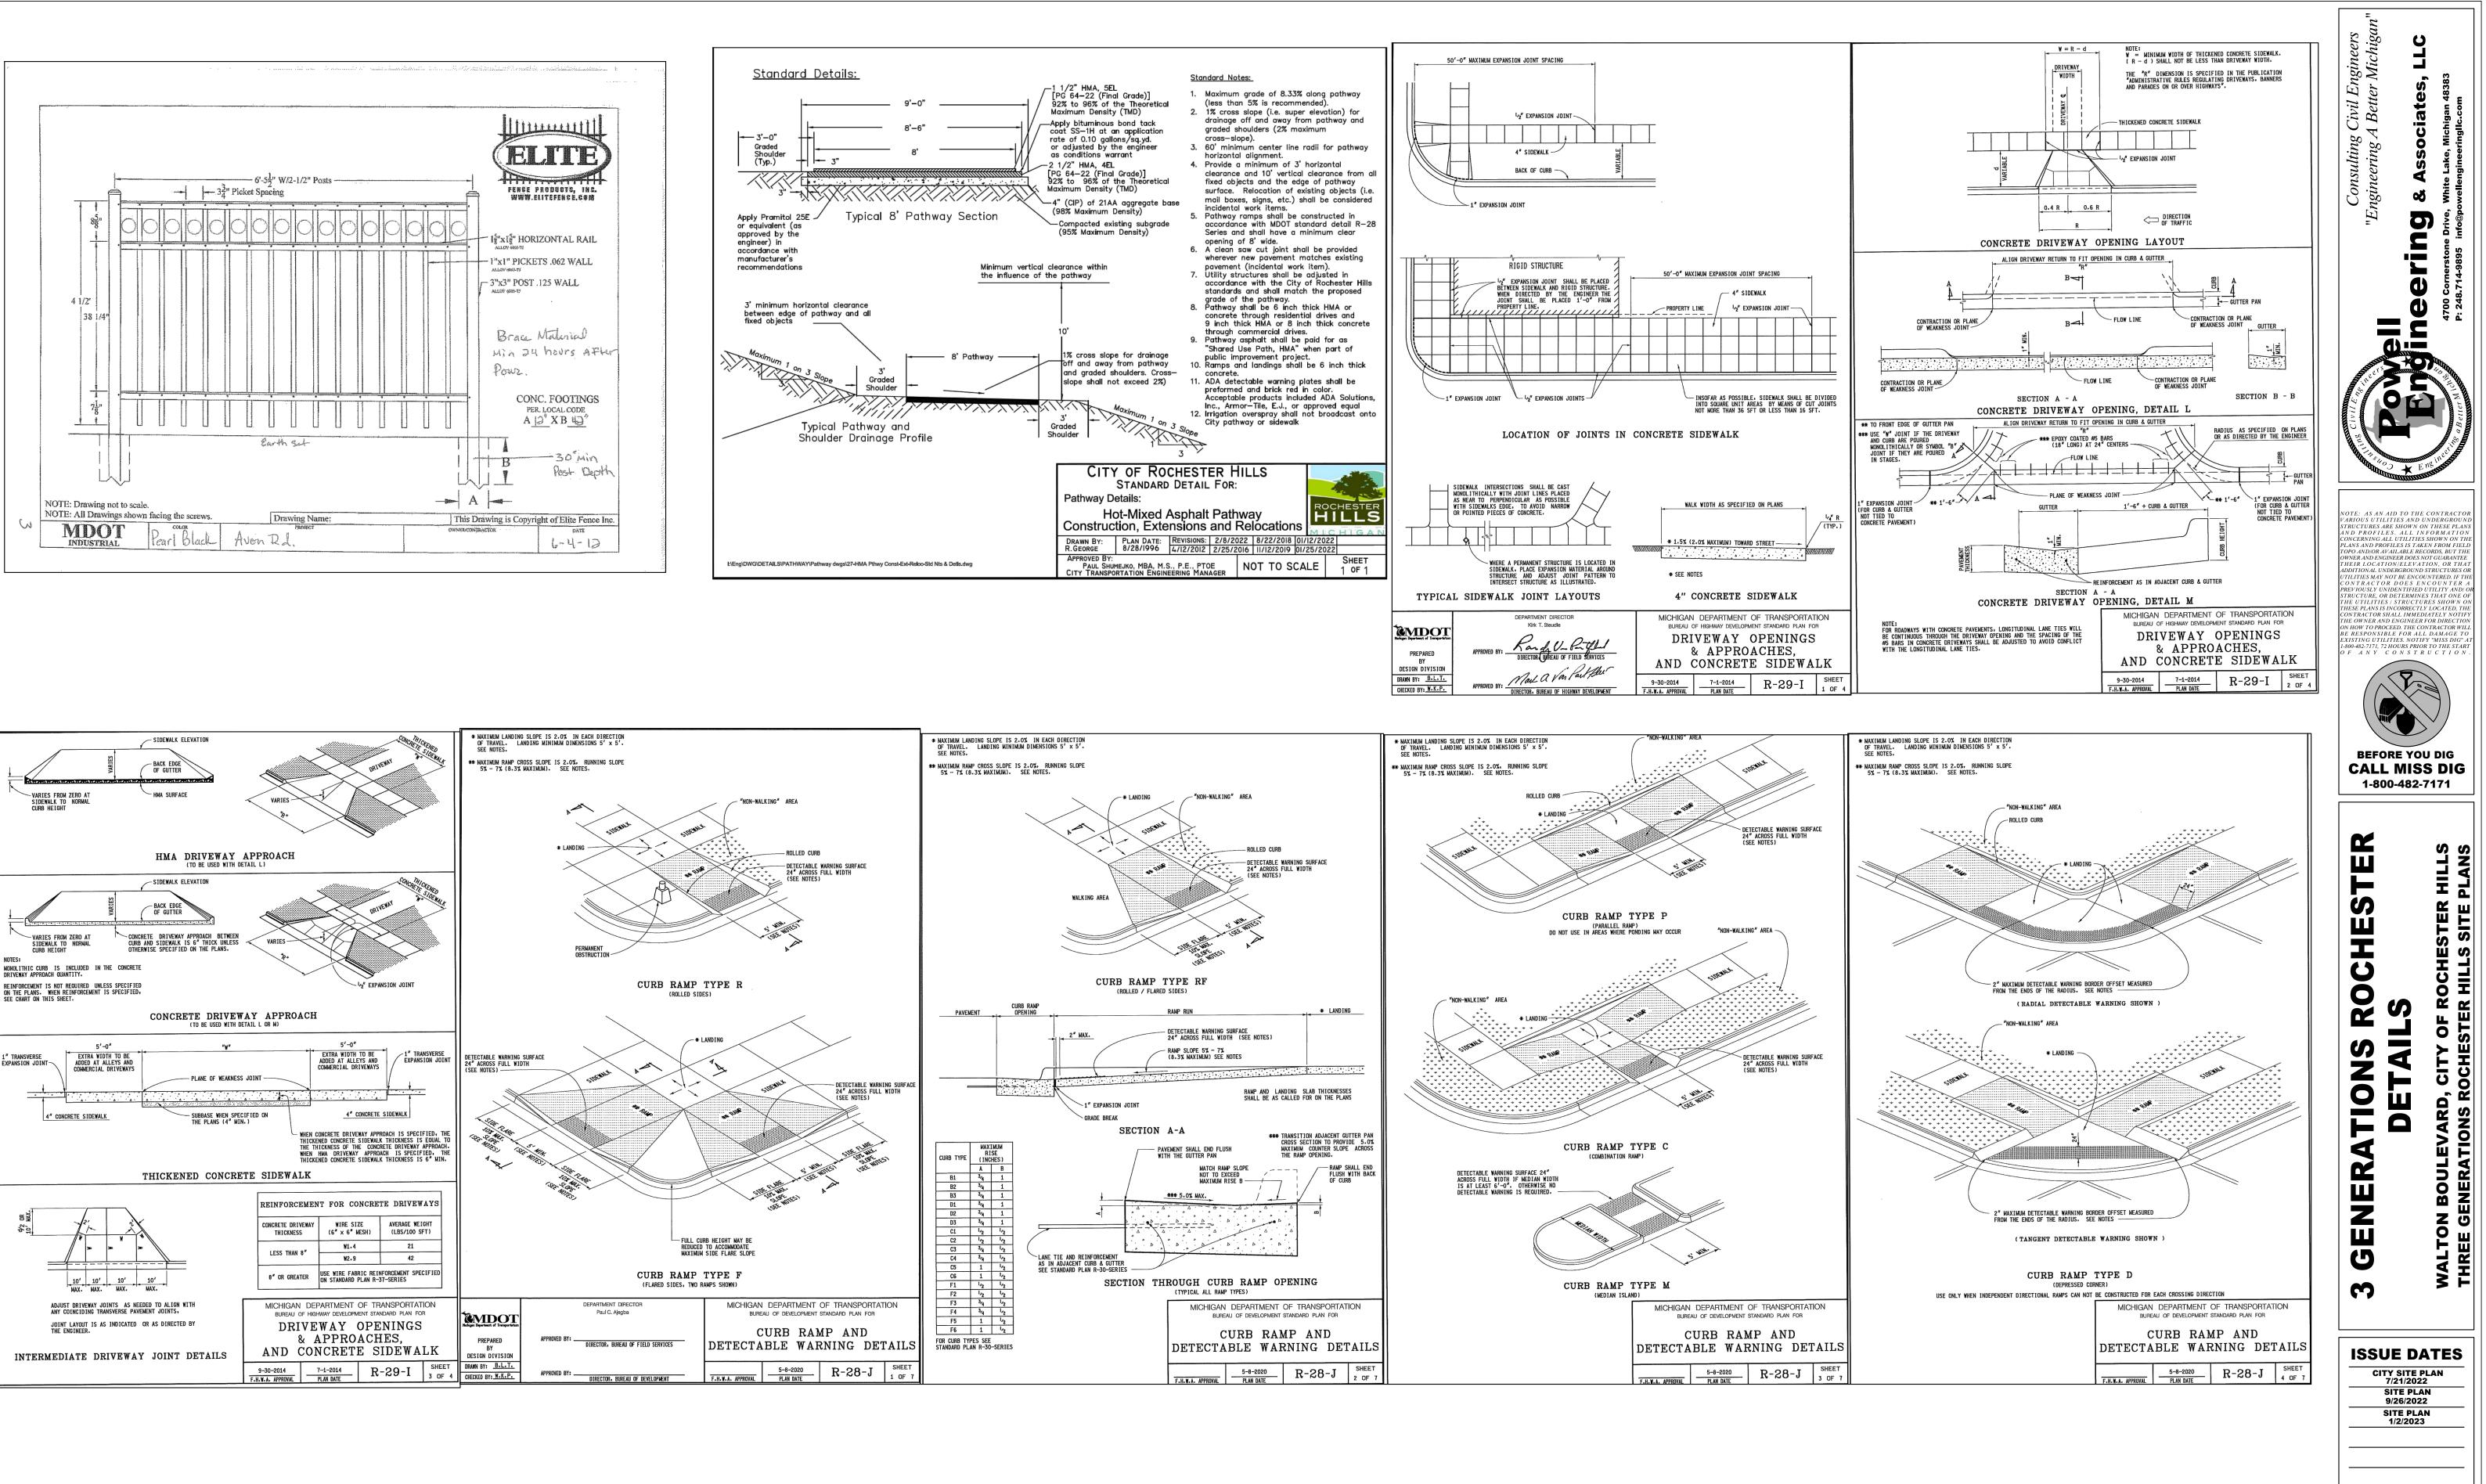

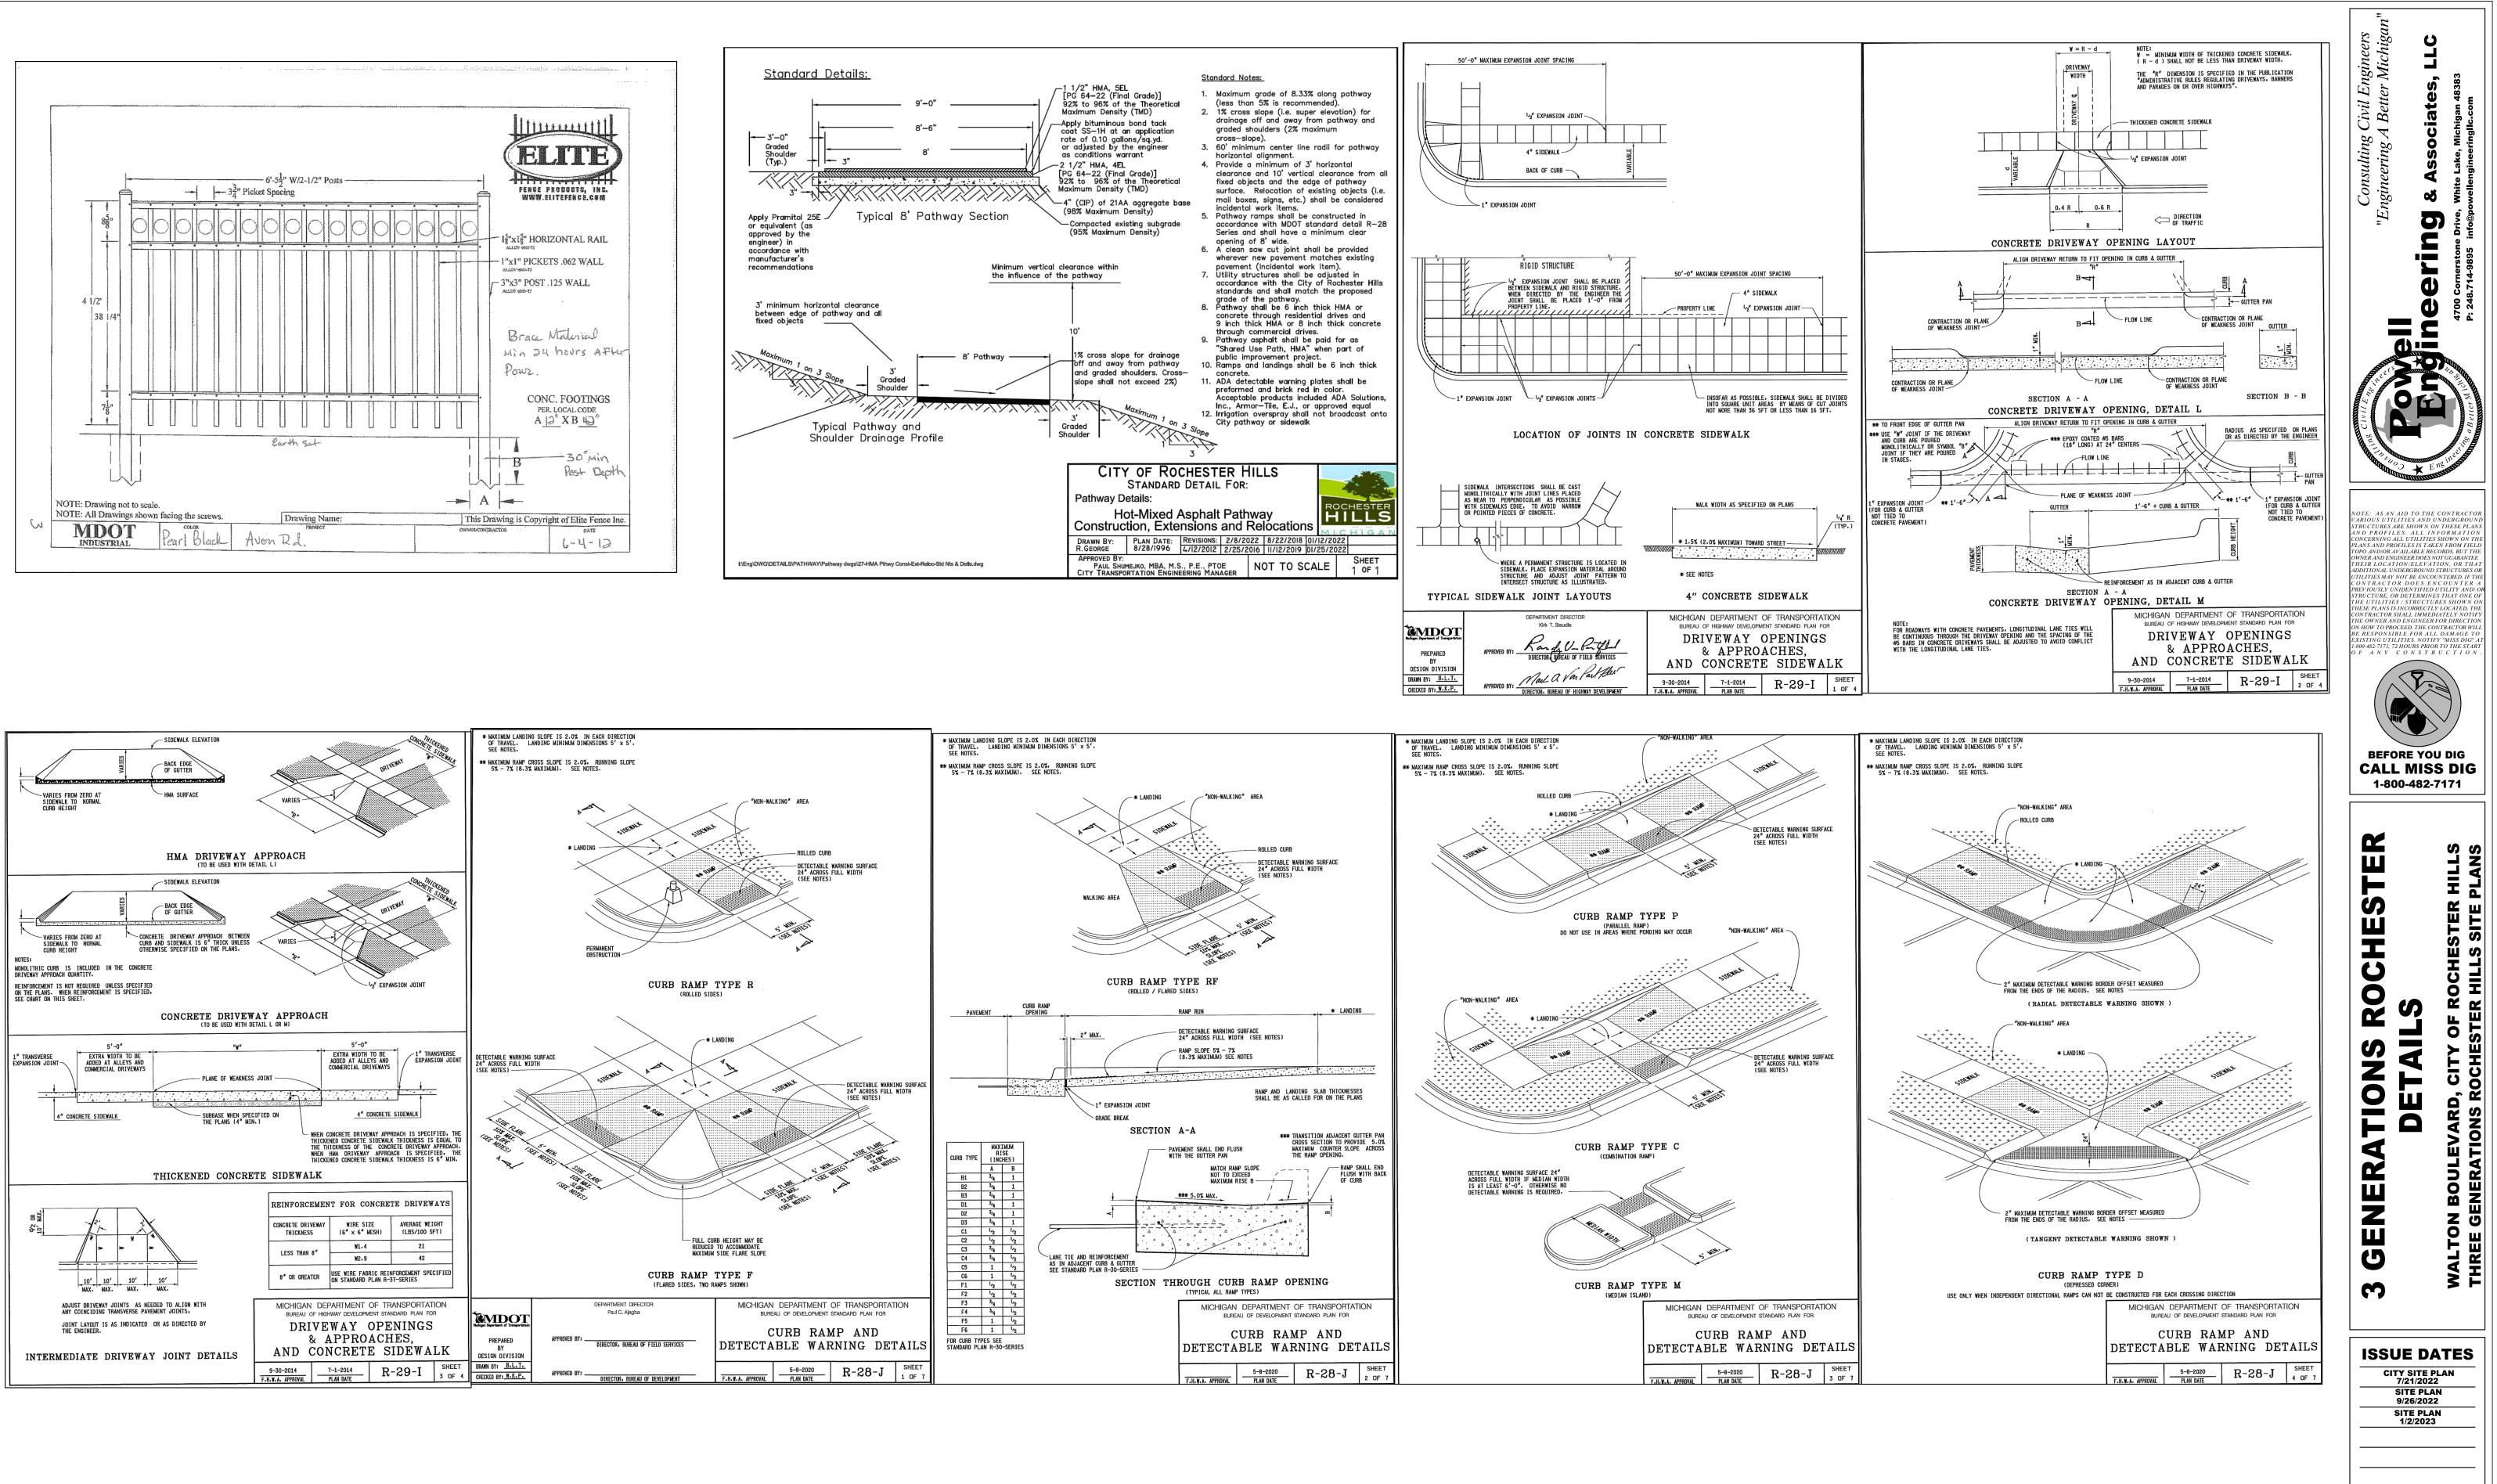

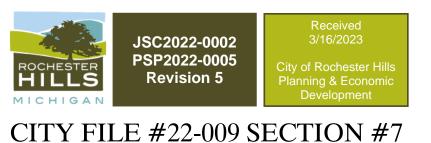






P.E. JOB No. 21-419


SCALE 1"=30'

DRAWN MCS DESIGNED MCS APPROVED MCP

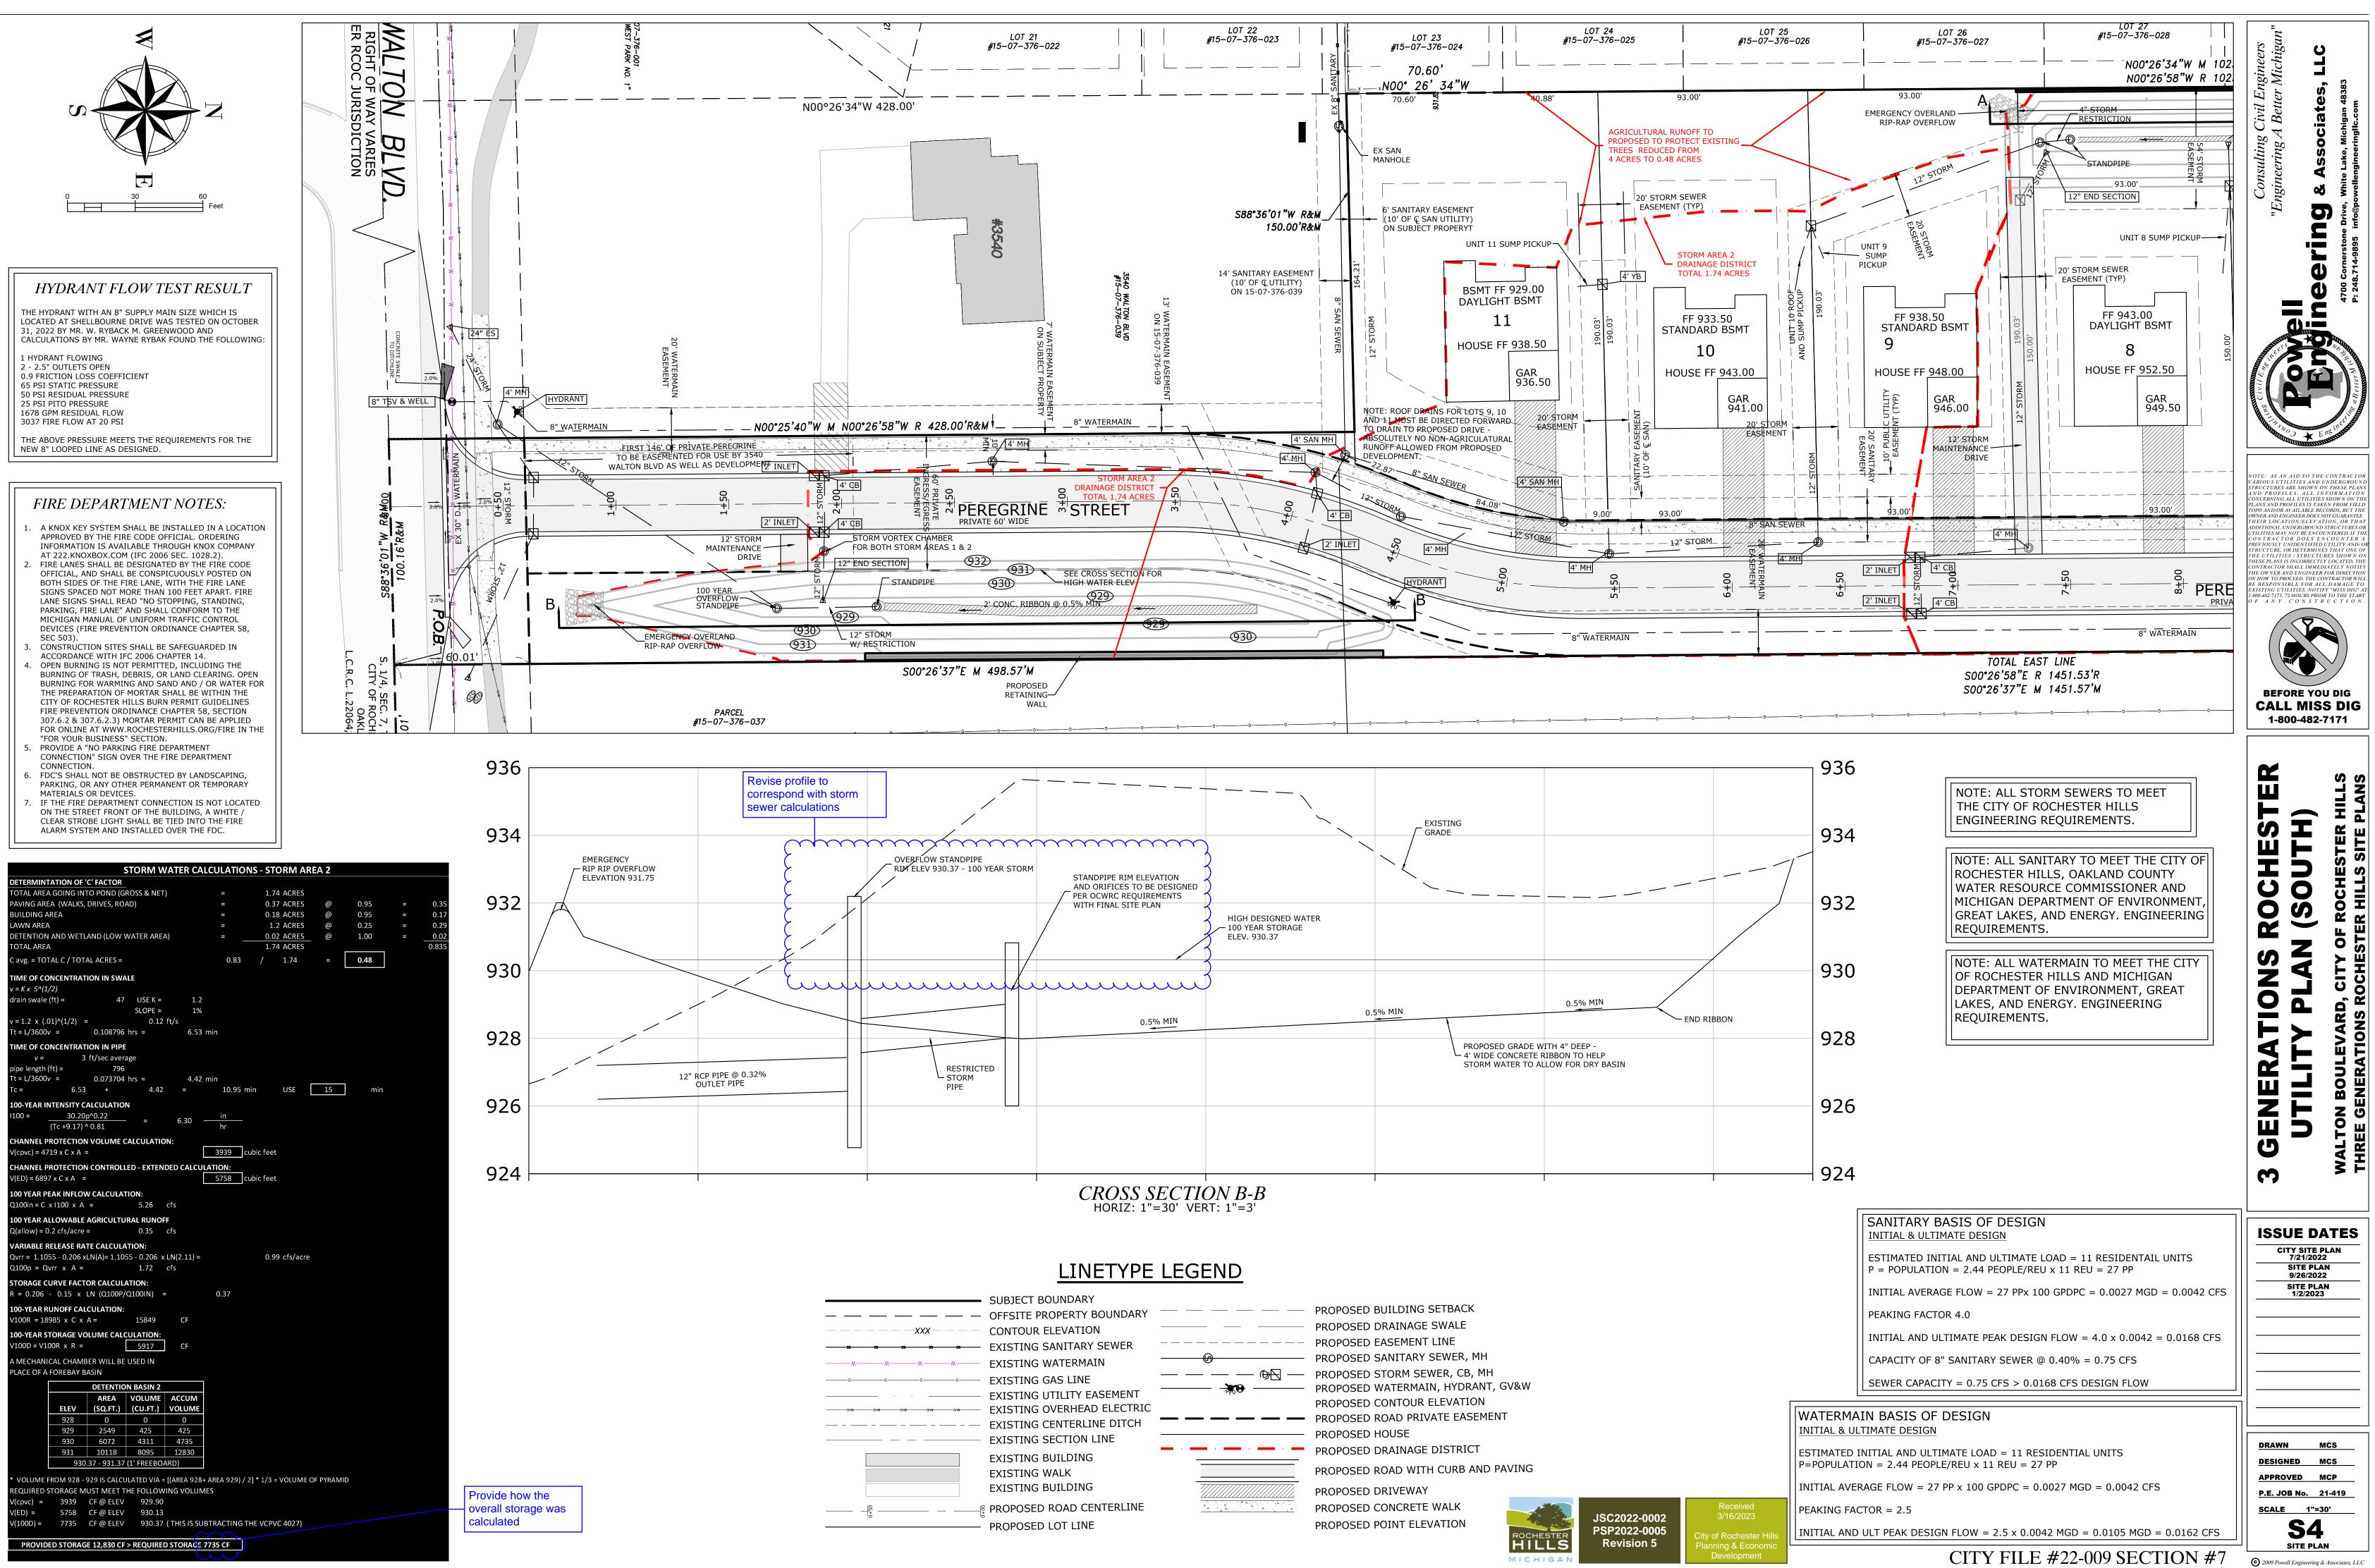


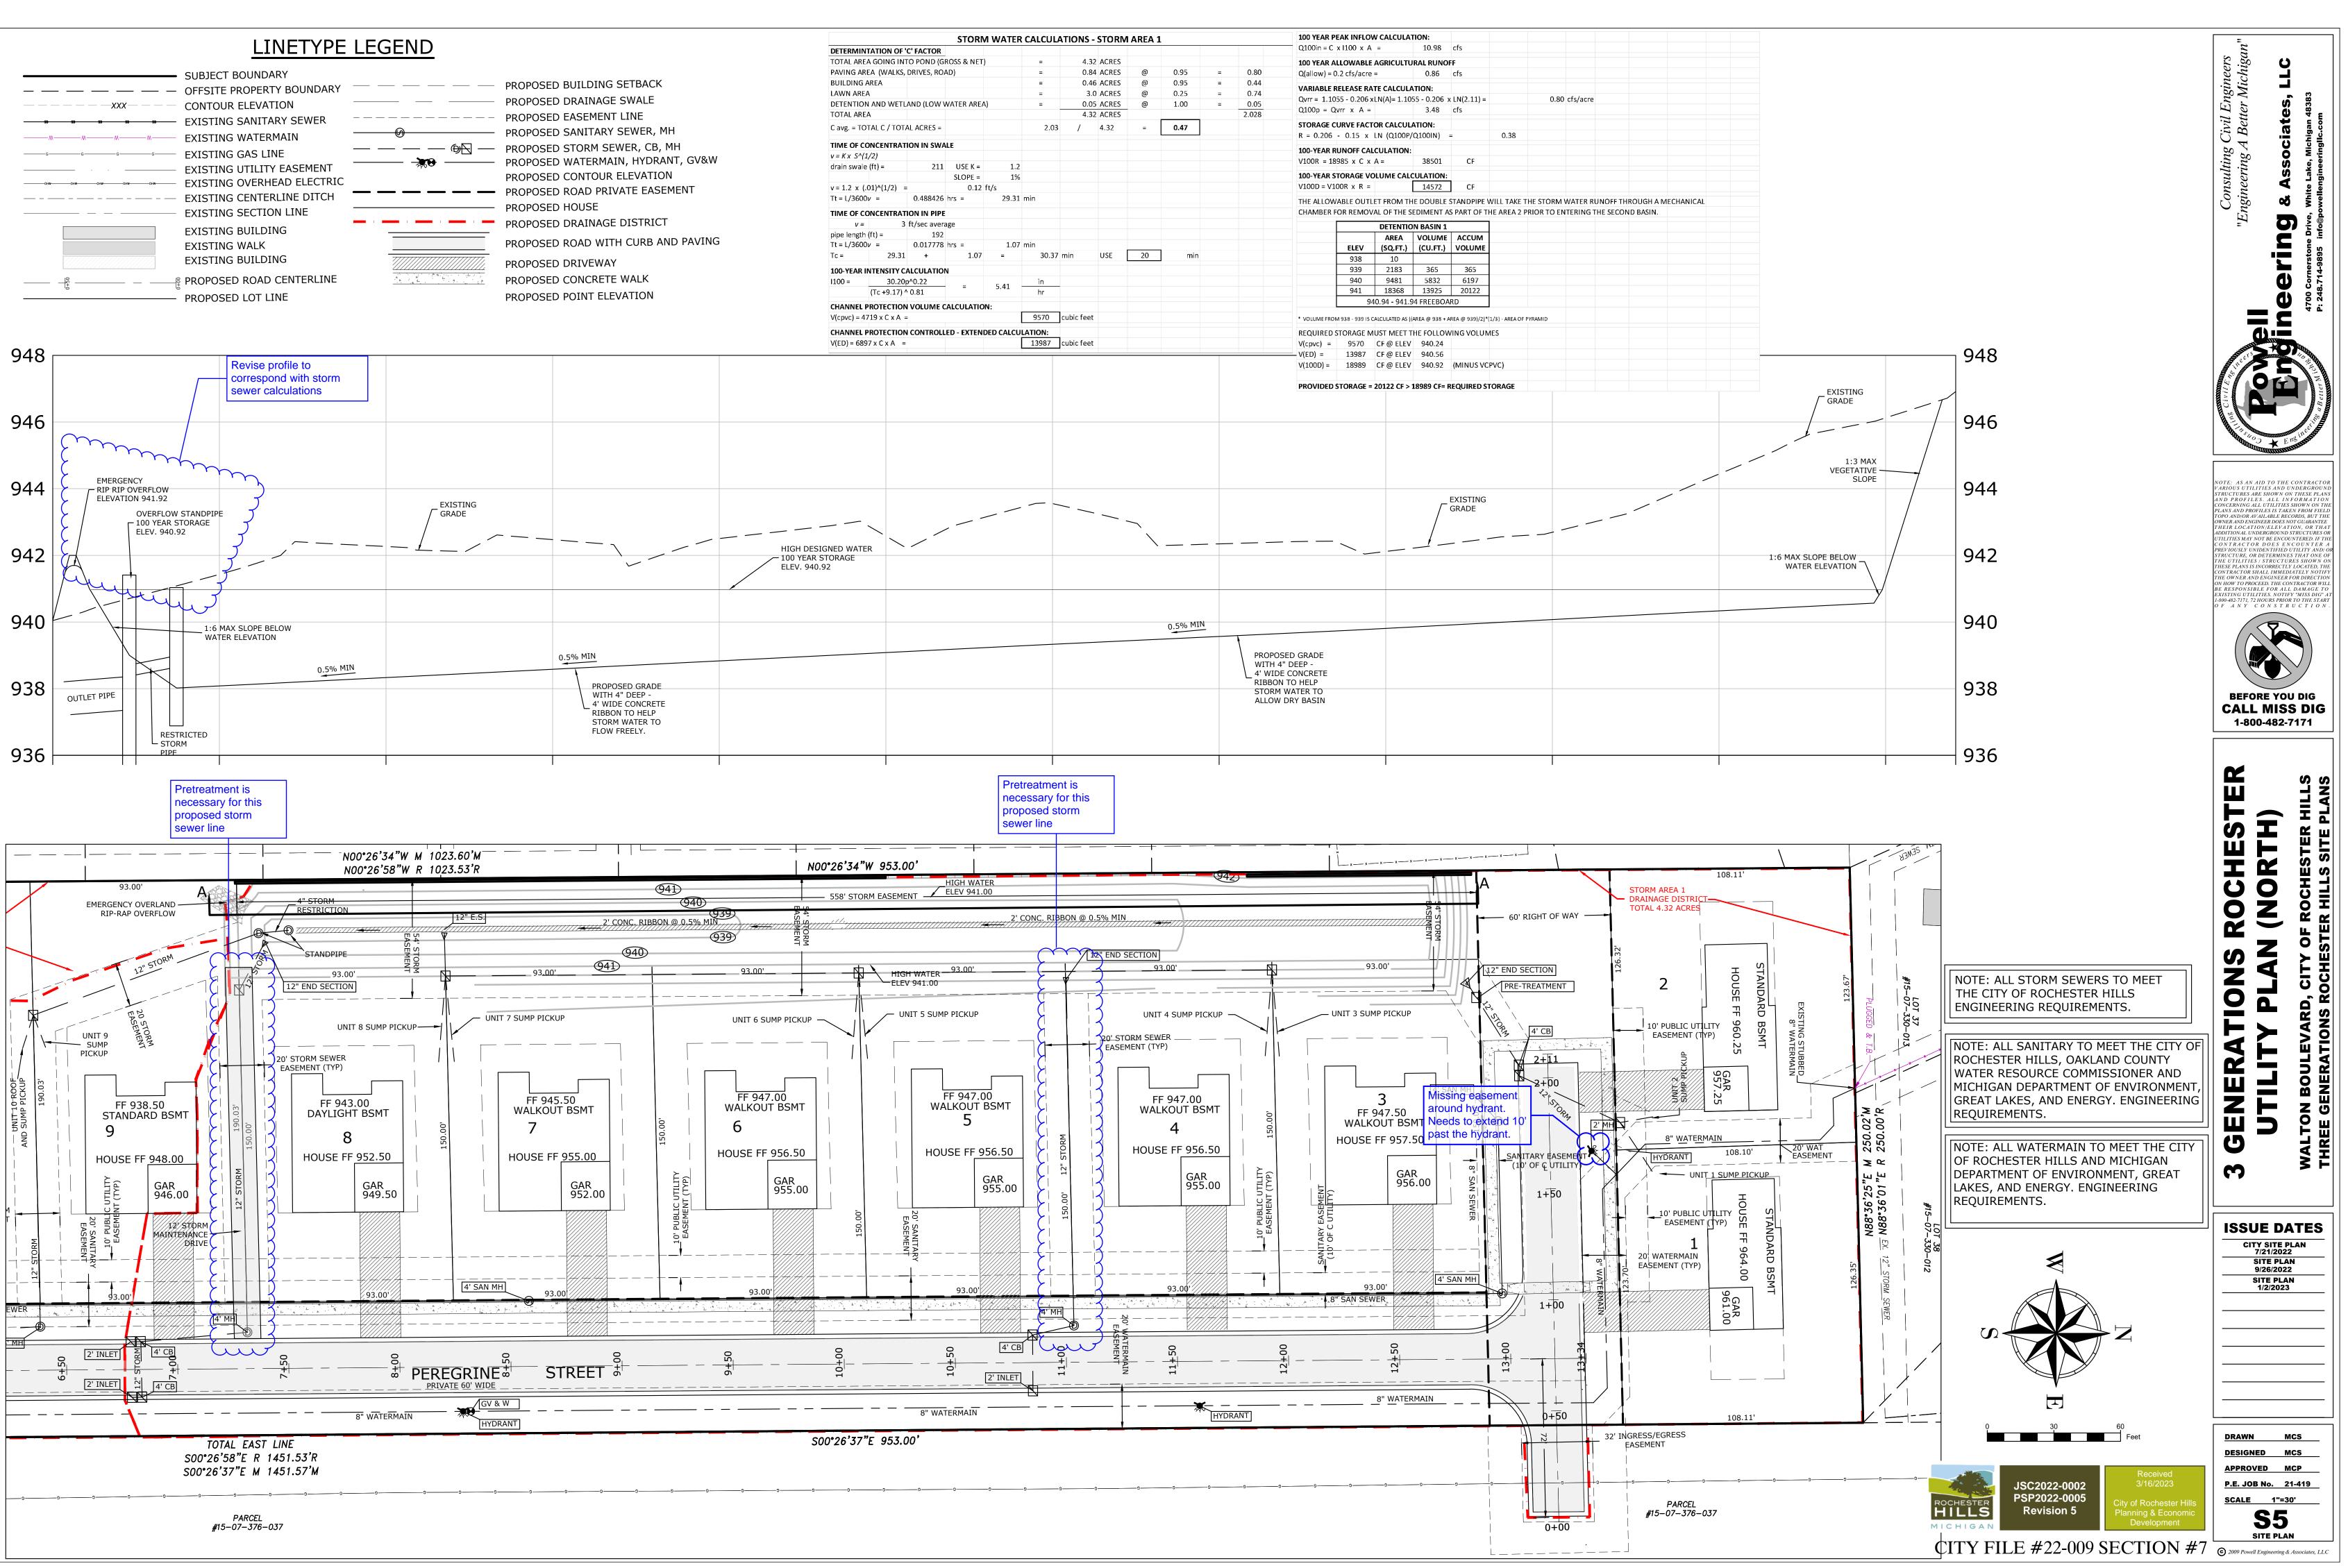

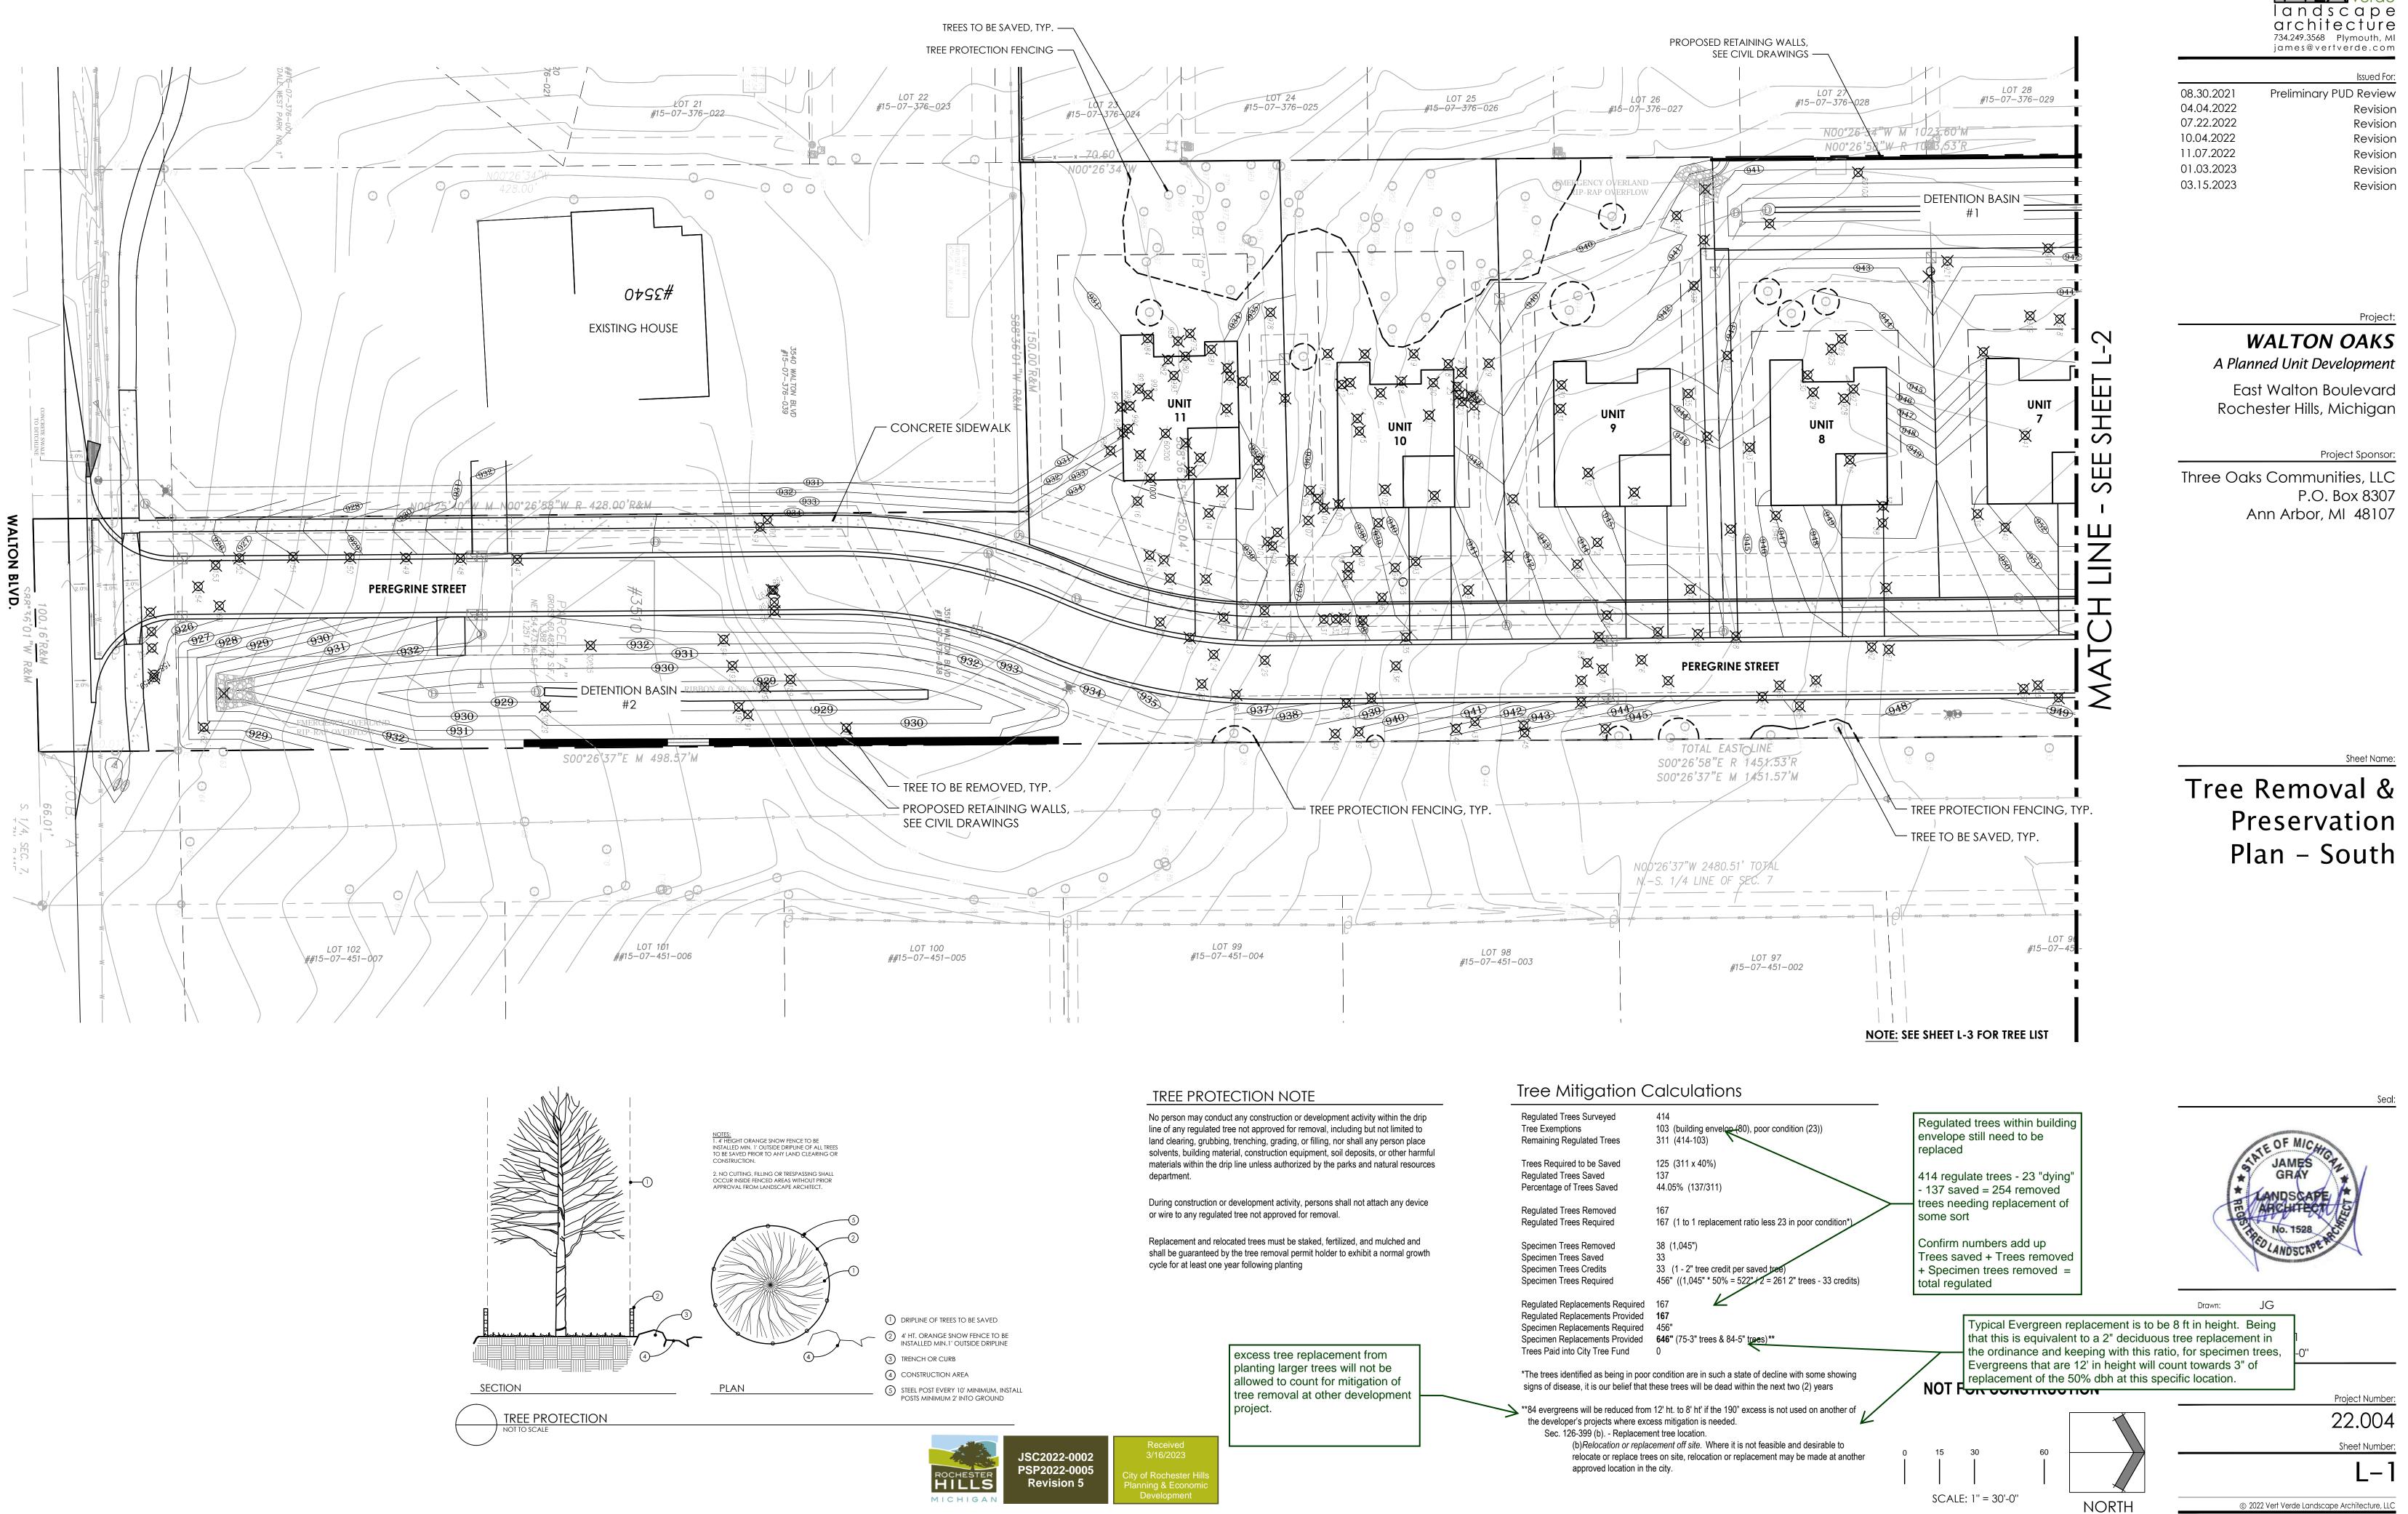

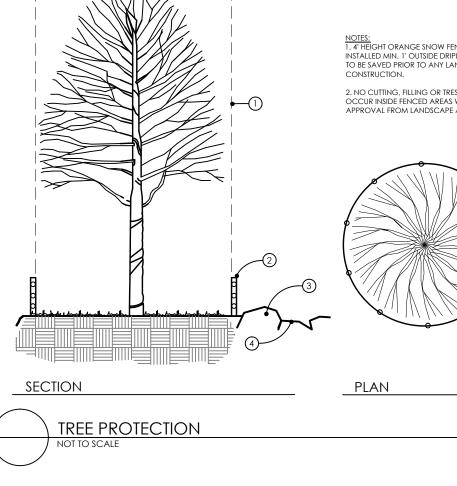



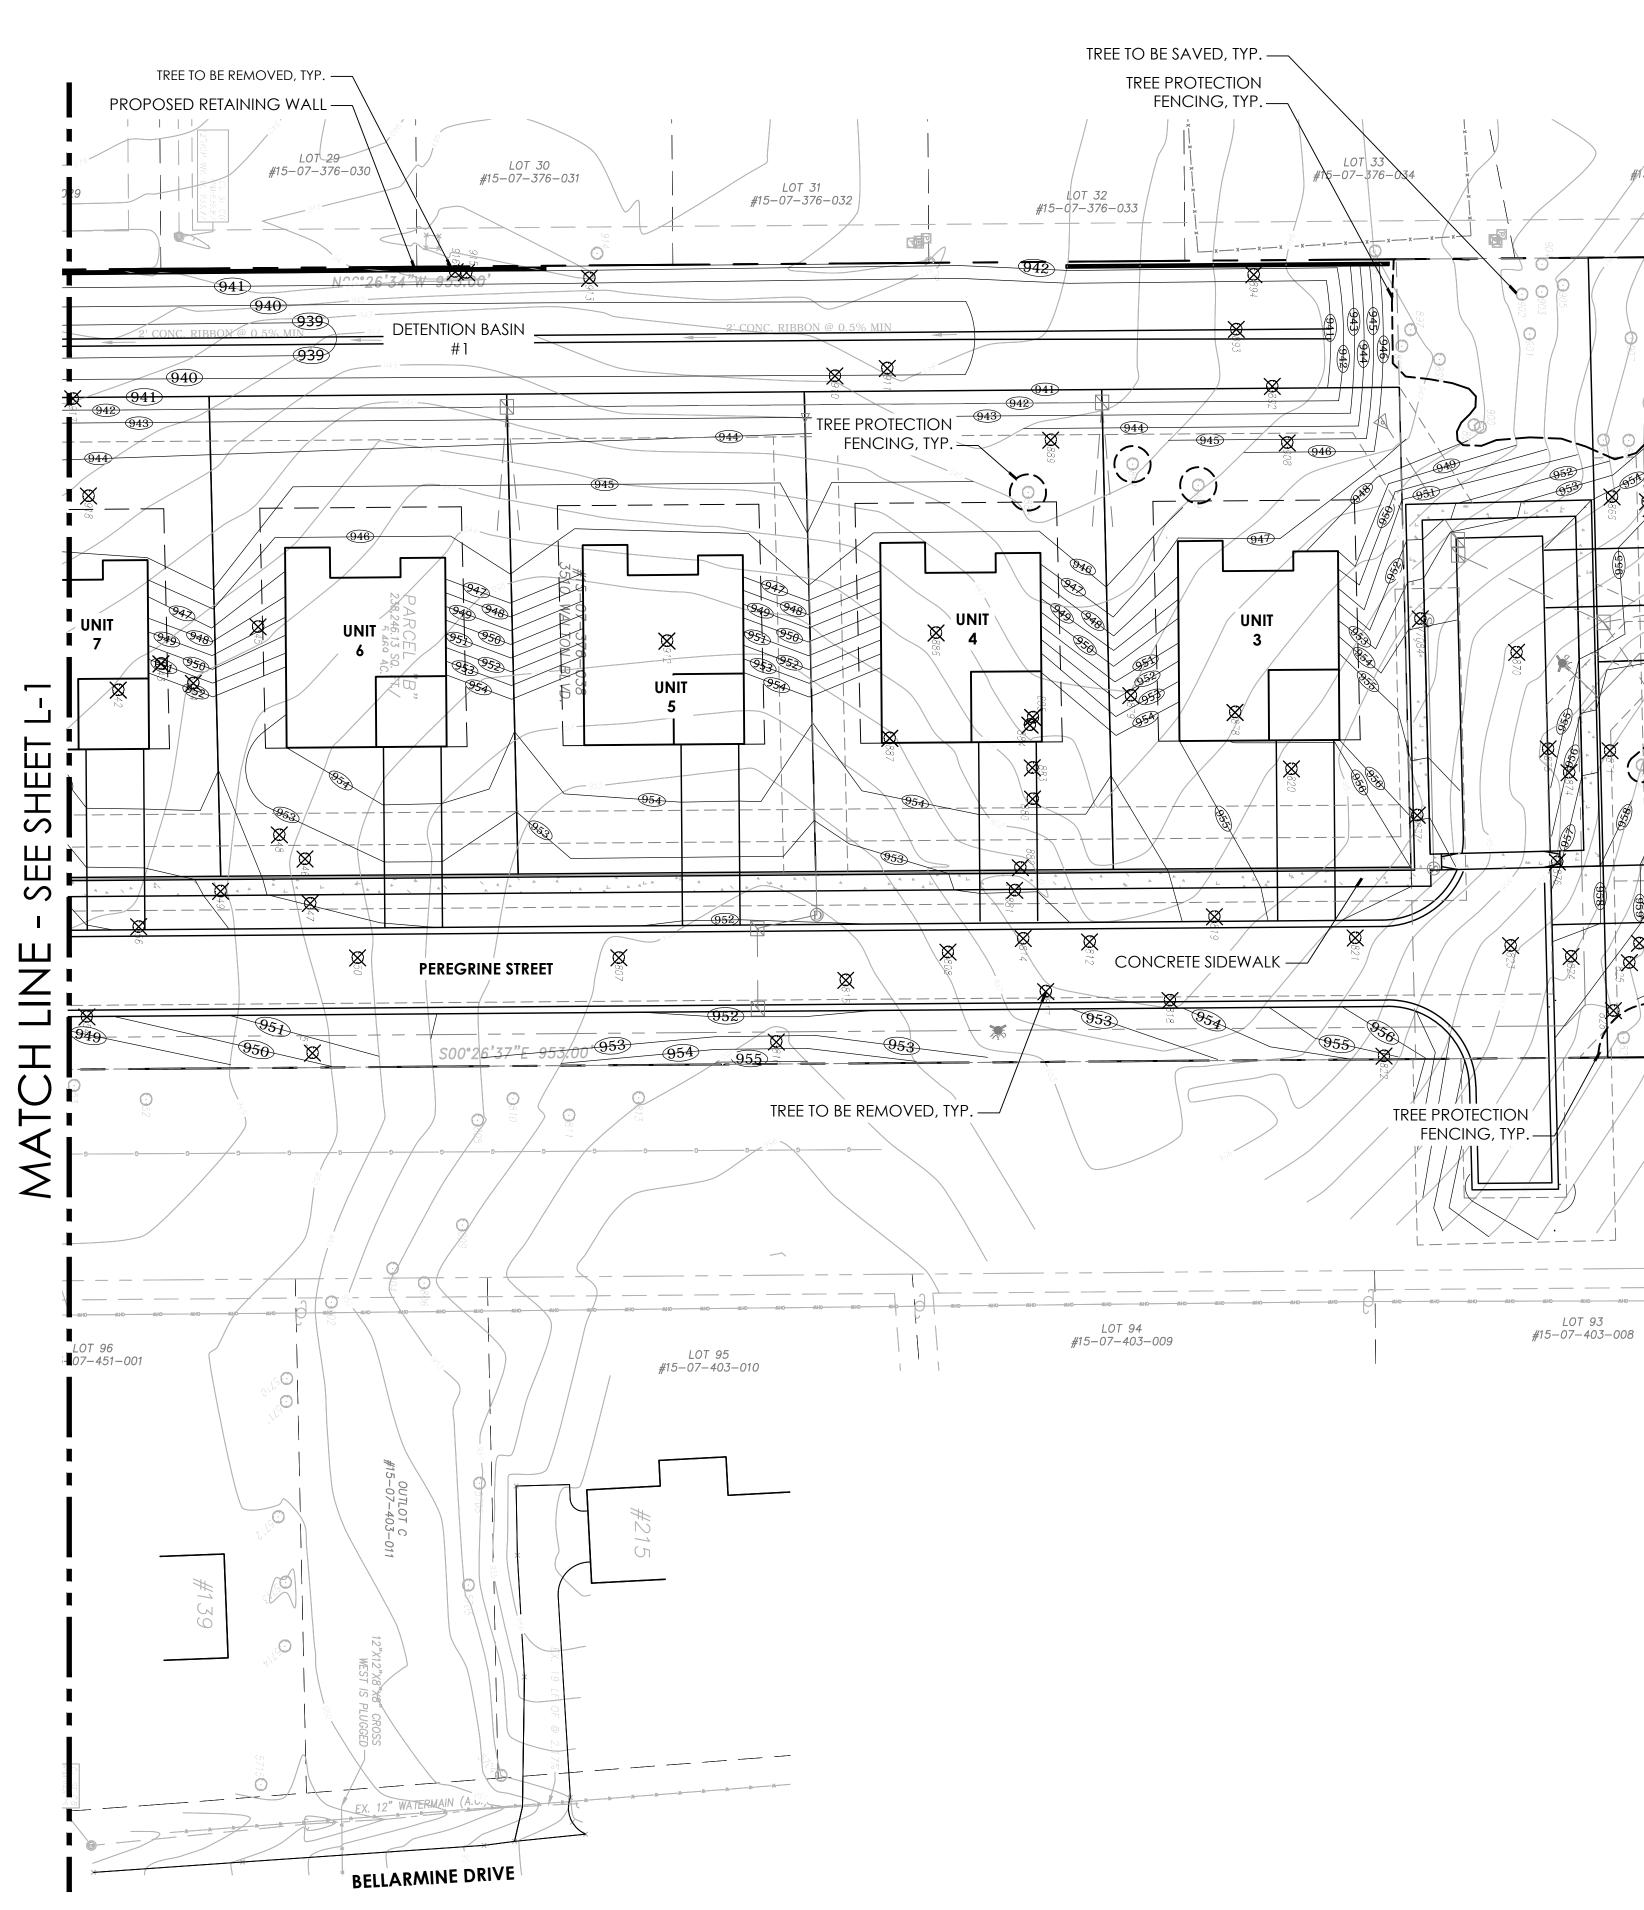





JSC2022-0002 PSP2022-0005 Revision 5

City of Rochester H Planning & Econon Development



08.30.2021 04.04.2022 07.22.2022 10.04.2022 11.07.2022 01.03.2023 03.15.2023

Issued For: Preliminary PUD Review Revision Revision Revision Revision Revision Revision

Project:

WALTON OAKS A Planned Unit Development


East Walton Boulevard Rochester Hills, Michigan

Project Sponsor:

Three Oaks Communities, LLC P.O. Box 8307 Ann Arbor, MI 48107

Sheet Name:

Tree Removal & Preservation Plan – North

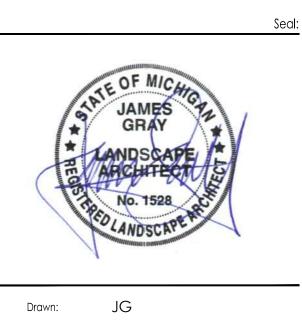



Drawn:	JG
Checked:	JG
Date:	06.2021
Scale:	1'' = 30'-0''

	Project Number:
	22.004
	Sheet Number:
	L-1
© 2022 Vert Verd	de Landscape Architecture, LLC

LOT 34 #15-07-376-035 UNIT 2 X) X \bigotimes \$ 958 (959) UNIT 1 ABH X 962 X LOT 92 #15-07-403-007



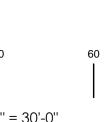

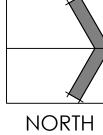

SCALE: 1" = 30'-0"

31 32 33 34 35 36 37 38 39 40 41 42 43 44 45 46 47 48 49 50 51 52 53 54 55 56 57 1 58 59 60 61 62 63 64 65 66 67 78 79 80 81 82 83 84 85 86 87 88 90 91 92 93 94 95	2 3 4 5 6 7 8 9 10 11 12 13 14 15 16 17 18 19 20 21 22 23 24 25 26
28Black Walnut16Black Walnut18Black Walnut18Black Walnut6Elm13Red Oak24Red Oak24Red Oak17Elm17Elm17Elm9Ash10Elm13Elm14Red Sak15Elm16Elm7Ash6,5Apple9Ash6,5Apple9Honeylocust8Black Cherry10Black Cherry13Scotch Pine29Scotch Pine29Scotch Pine29Scotch Pine29Scotch Pine29Scotch Pine29Scotch Pine29Scotch Pine14Red Oak8Elm15Black Cherry8Elm10Elm11Elm13Elm14Black Cherry15Black Cherry16Elm17Elm18Elm19Scotch Pine11Elm13Elm14Black Cherry15Black Cherry16Elm17Black Cherry18Elm19Scotch Pine11Elm12Black Cherry13Elm14Blac	H (in.)Common Name12Elm15Black Locust11Black Locust12Black Maple11Black Locust12Black Locust13Black Locust13Black Locust7Hawthorn15Black Locust16Elm36Black Walnut20Black Walnut21White Oak8White Oak10Black Walnut11White Oak22Black Walnut14Black Maple22Black Walnut10Elm11Elm12Black Walnut13Black Walnut14Black Walnut13Black Walnut13Black Walnut13Black Walnut13Black Walnut13Black Walnut13Black Walnut13Black Walnut13Black Walnut14Black Walnut13Black Walnut14Black Walnut15Black Walnut16Elm17Black Walnut18Black Walnut19Black Walnut19Black Walnut11Black Walnut13Black Walnut14Black Walnut15Black Walnut16Black Walnut17Black Walnut18Black Walnut
Juglans nigra Juglans nigra Quercus alba Juglans nigra Quercus rubra Quercus rubra Quercus rubra Ulmus americana Ulmus americana Ulmus americana Ulmus americana Ulmus americana Ulmus americana Ulmus americana Valus ssp. Prunus serotina Praxinus Malus ssp. Gleditsia triacanthos Prunus serotina Prunus serotina Ulmus americana Ulmus americana Quercus rubra Prunus serotina Ulmus americana Qumis americana Quercus rubra Prunus serotina Ulmus americana Qumus americana Prunus serotina Qumus americana Prunus serotina Qumus americana Robinia pseudoacacia Robinia pseudoacacia Rob	Botanical Name Ulmus americana Robinia pseudoacacia Acer nigrum Robinia pseudoacacia Robinia pseudoacacia Robinia pseudoacacia Crataegus Robinia pseudoacacia Ulmus americana Juglans nigra Juglans nigra Juglans nigra Juglans nigra Juglans nigra Juglans nigra Juglans nigra Juglans nigra Juglans nigra Ulmus americana Ulmus americana Ulmus americana Juglans nigra Juglans nigra
Good 942.74 Good 943.44 Good 945.41 Good 945.25 Good 945.42 Good 946.40 Good 946.41 Good 946.42 Good 946.12 Poor 947.04 Fair 946.12 Poor 947.04 Good 947.74 Good 947.74 Good 947.74 Good 947.74 Good 948.90 Good 948.93 Good 948.93 Good 948.35 Good 948.35 Good 948.43 Good 948.43 Good 948.43 Good 948.43 Good 948.44 Good 948.43 Good 948.44 Good 944.51 Good 944.51 Good 944.51 Good <td>Condition Elevation Good 932.81 Good 932.56 Fair 932.74 Good 933.15 Fair 933.06 Poor 933.17 Fair 933.33 Fair 933.33 Fair 933.33 Fair 934.16 Good 934.52 Good 935.35 Good 937.37 Good 937.20 Good 937.20 Good 937.21 Good 937.28 Fair 938.35 Fair 938.35 Good 937.28 Good 937.28 Good 939.25 Good 939.25 Good 939.25 Good 939.25 Good 939.25 Good 940.00 Poor 939.88 Good 940.05 Fair 940.05</td>	Condition Elevation Good 932.81 Good 932.56 Fair 932.74 Good 933.15 Fair 933.06 Poor 933.17 Fair 933.33 Fair 933.33 Fair 933.33 Fair 934.16 Good 934.52 Good 935.35 Good 937.37 Good 937.20 Good 937.20 Good 937.21 Good 937.28 Fair 938.35 Fair 938.35 Good 937.28 Good 937.28 Good 939.25 Good 939.25 Good 939.25 Good 939.25 Good 939.25 Good 940.00 Poor 939.88 Good 940.05 Fair 940.05
x x x x x x x x x x x x x x x x x x x x	X X X X X X X X X X X X X X X X X X
16020.12Silver Maple16124Silver Maple1638.12Silver Maple16528Silver Maple1667Elm16714Elm16824,15Apple17019Silver Maple17122Red Maple1727Red Maple17310,11Red Maple17410Red Maple17512Shellbark Hickory1766Norway Maple1778Norway Maple1788,10,10Apple18126,24Boxelder18236Boxelder18352Boxelder1849Mulberry185DEAD18612Mulberry18712Mulberry18817,11Silver Maple19913Norway Spruce19326Norway Spruce19470Silver Maple1958Sugar Maple1969Sugar Maple19712Sugar Maple19814Sugar Maple19928,34Cottonwood20020,30Cottonwood201Norway Spruce20317Norway Maple20418Black Walnut20517Norway Maple2060,30Cottonwood20128,30Red Oak20212Silver Maple </td <td>Tag No.DBH (in.)Common Nam13111Elm13210Elm13312Elm13312Elm1348Elm1359Ash1369,8,8,8Black Cherry13710Elm1387Ash13910,8Elm1406Elm14110Apple14213Elm1439Elm14412Elm1459Elm14613Elm14724Sugar Maple15022Sugar Maple15127Sugar Maple15219Sugar Maple15318Sugar Maple15420Sugar Maple15528,8Norway Spruce15622Norway Spruce15711Norway Spruce</td>	Tag No.DBH (in.)Common Nam13111Elm13210Elm13312Elm13312Elm1348Elm1359Ash1369,8,8,8Black Cherry13710Elm1387Ash13910,8Elm1406Elm14110Apple14213Elm1439Elm14412Elm1459Elm14613Elm14724Sugar Maple15022Sugar Maple15127Sugar Maple15219Sugar Maple15318Sugar Maple15420Sugar Maple15528,8Norway Spruce15622Norway Spruce15711Norway Spruce
Acer saccharinumAcer saccharinumAcer saccharinumAcer saccharinumAcer saccharinumUlmus americanaUlmus americanaUlmus americanaMalus ssp.Acer rubrumAcer rubrumAcer rubrumAcer rubrumAcer rubrumAcer rubrumAcer rubrumAcer negundoAcer negundoAcer negundoAcer acet aninumAcer saccharinumAcer negundoAcer negundoAcer saccharumAcer platanoidesPinus nigraJuglans nigra </td <td>eBotanical NameUlmus americanaUlmus americanaUlmus americanaUlmus americanaFraxinusPrunus serotinaUlmus americanaFraxinusUlmus americanaUlmus americanaAcer saccharumAcer saccharumPicea abiesPicea abies</td>	eBotanical NameUlmus americanaUlmus americanaUlmus americanaUlmus americanaFraxinusPrunus serotinaUlmus americanaFraxinusUlmus americanaUlmus americanaAcer saccharumAcer saccharumPicea abiesPicea abies
Good Good <t< td=""><td>Condition Elevation Sp Good 938.34 938.51 Good 938.51 938.64 Good 938.64 938.64 Good 939.74 940.67 Poor 941.20 940.67 Fair 940.67 939.70 Good 940.09 940.09 Fair 939.51 939.51 Good 943.10 943.34 Good 943.34 944.53 Good 944.53 944.53</td></t<>	Condition Elevation Sp Good 938.34 938.51 Good 938.51 938.64 Good 938.64 938.64 Good 939.74 940.67 Poor 941.20 940.67 Fair 940.67 939.70 Good 940.09 940.09 Fair 939.51 939.51 Good 943.10 943.34 Good 943.34 944.53 Good 944.53 944.53
x x x x x x x x x x x x x x x x x x x x x x x x x x x x x x x x x x x x x x x x x x x x x x x x x x x x x x x x x x x x x x x x x x x x x x x x x x x x x x x x x x x x x x x x x x x x x x x x x x x x x x x x x x x x x x x x x x x x x x x x x x x x <td>eciman Remove Exempt X X X X X X X X X X X X X X X X X X X X X X X X X X X X X X X X X X X X X X X X X X X X X X X X X X X X X X X X X X X X X X X X X X X X <tr td=""></tr></td>	eciman Remove Exempt X X X X X X X X X X X X X X X X X X X X X X X X X X X X X X X X X X X X X X X X X X X X X X X X X X X X X X X X X X X X X X X X X X X X <tr td=""></tr>
8008,10Apple89121Cottonwood89341Cottonwood89341Boxelder89614Boxelder89710Ash89810,13Boxelder900MultiApple90110,7,9,9Boxelder90215Black Walnut90310Black Cherry9047Black Walnut9057Boxelder9069Apple90710Boxelder9088Boxelder90924Scotch Pine91318,15Cottonwood91438Cottonwood91517Cottonwood9166Cottonwood9177Ash91817Elm91916Red Oak92011Ash92118Elm9229Elm92313Elm9248Elm92536Black Walnut9269Elm92713,9Elm9288Elm9297Elm9318Black Cherry9328Elm93341Black Walnut948Elm959Elm9518Black Walnut959Black Walnut959Black Walnut95 <t< td=""><td>Tag No. DBH (in.) Common National 861 8 Black Walnut 862 8 Black Walnut 863 7,10 Boxelder 864 9 Boxelder 865 9 Boxelder 866 7 Black Walnut 867 12 Black Walnut 867 12 Black Cherry 868 6,9 Boxelder 869 8 Boxelder 870 8,8,7,6 Apple 871 12 Ash 872 8 Apple 873 7 Black Cherry 874 6,14 Apple 875 10 Ash 876 17 Elm 877 10 White Pine 878 Multi Apple 879 8 Ash 880 7 Black Cherry 881 Multi Apple 882 Multi</td></t<>	Tag No. DBH (in.) Common National 861 8 Black Walnut 862 8 Black Walnut 863 7,10 Boxelder 864 9 Boxelder 865 9 Boxelder 866 7 Black Walnut 867 12 Black Walnut 867 12 Black Cherry 868 6,9 Boxelder 869 8 Boxelder 870 8,8,7,6 Apple 871 12 Ash 872 8 Apple 873 7 Black Cherry 874 6,14 Apple 875 10 Ash 876 17 Elm 877 10 White Pine 878 Multi Apple 879 8 Ash 880 7 Black Cherry 881 Multi Apple 882 Multi
Malus ssp.Populus deltoidesPopulus deltoidesPopulus deltoidesAcer negundoFraxinusAcer negundoFraxinusMalus ssp.Acer negundoJuglans nigraPrunus serotinaJuglans nigraAcer negundoMalus ssp.Acer negundoMalus ssp.Acer negundoMalus ssp.Acer negundoPinus sylvestrisJuglans nigraAcer negundoPinus sylvestrisJuglans nigraAcer negundoPinus sylvestrisPopulus deltoidesPopulus deltoidesPopulus deltoidesPopulus deltoidesPopulus americanaUlmus	me Botanical Name Juglans nigra Juglans nigra Acer negundo Acer negundo Juglans nigra Prunus serotina Acer negundo Acer negundo Acer negundo Malus ssp. Fraxinus Malus ssp. Fraxinus Ulmus americana Pinus strobus Malus ssp. Fraxinus Ulmus americana Pinus strobus Malus ssp. Fraxinus Prunus serotina Malus ssp. Fraxinus Prunus serotina Malus ssp. Prunus serotina Prunus serotina Malus ssp.
Poor N/F Good 944.82 Good 945.67 Good 945.62 Fair 947.02 Fair 947.02 Fair 947.01 Fair 947.70 Poor 949.13 Fair 949.28 Good 949.39 Fair 943.35 Good 949.33 Foor 951.94 Fair 942.81 Good 945.91 Fair 942.83 Good 942.61 Good 942.61 Good 942.61 Good 942.61 Good 942.61 Good 942.83 Good 944.28 Good 944.28 Good 944.28 Good 944.28 Good 944.23 Good 944.24 Good 944.24 Good 944.24 Good	Condition Elevation Good 955.46 Good 955.17 Fair 953.79 Good 953.06 Good 953.23 Good 951.93 Dead 951.94 Fair 952.49 Poor 953.30 Fair 954.34 Dead 957.01 Poor 958.01 Good 958.01 Good 958.01 Good 956.31 Dead 957.01 Poor 958.01 Good 958.01 Good 958.01 Good 956.31 Dead 956.07 Good 951.89 Fair 948.89 Fair 948.89 Fair 948.85 Poor 950.36 Poor 948.63 Good 947.66 Good 947.66 Good 947.66
	Speciman Ren
	Tag No.DBH (in.)9911399210993119941199512996119971599879991310001157041557051457061257101657112257127571310571495715131154696000097708498010018820506,6,7



(in.)	Common Name	Botanical Name	Condition	Elevation	Speciman	Remove	Exempt
3	Black Locust	Robinia pseudoacacia	Good	931.26		Х	Х
)	Black Walnut	Juglans nigra	Good	931.32		х	Х
L	Elm	Ulmus americana	Good	931.80		х	Х
L	Black Locust	Robinia pseudoacacia	Poor	931.32		х	Х
2	Elm	Ulmus americana	Good	931.41		х	Х
L	Black Locust	Robinia pseudoacacia	Fair	931.14		х	Х
5	Black Locust	Robinia pseudoacacia	Fair	931.15		х	Х
	Black Locust	Robinia pseudoacacia	Poor	931.12		х	Х
3	Black Locust	Robinia pseudoacacia	Good	931.71		х	Х
L	Black Locust	Robinia pseudoacacia	Good	932.12		х	Х
5	Norway Maple	Acer platanoides	Good	953.01			
1	Norway Maple	Acer platanoides	Good	953.21			
2	Norway Maple	Acer platanoides	Good	953.85			
5	Silver Maple	Acer saccharinum	Good	950.59			
2	Silver Maple	Acer saccharinum	Good	950.74	х		
	Blue Spruce	Picea pungens	Good	949.91			
)	Blue Spruce	Picea pungens	Good	950.06			
	Blue Spruce	Picea pungens	Good	949.67			
3	Blue Spruce	Picea pungens	Good	949.49			
	Black Walnut	Juglans nigra	Good	945.64		х	
	Black Locust	Robinia pseudoacacia	Good	932.01		х	Х
	Black Cherry	Prunus serotina	Good	951.32		х	
3	Black Walnut	Juglans nigra	Good	942.03	х	х	
,7	Mulberry	Morus alaba	Good	961.05		х	

Issued For: Preliminary PUD Review Revision Revision Revision Revision Revision Revision

08.30.2021 04.04.2022 07.22.2022 10.04.2022 11.07.2022 01.03.2023 03.15.2023

Project:

WALTON OAKS A Planned Unit Development

East Walton Boulevard Rochester Hills, Michigan

Project Sponsor:

Three Oaks Communities, LLC P.O. Box 8307 Ann Arbor, MI 48107

> Sheet Name: Tree List

Seal: JG JG)rawr Checked: 06.2021 Date: No Scale Scale: Project Number: 22.004 Sheet Number: L-3



NOT FOR CONSTRUCTION

© 2022 Vert Verde Landscape Architecture, LLC

Seed Mix 'A'

Stormwater Seed Mix		
		PLS
Botanical Name	Common Name	Ounces/Acre
Permanent Grasses' Sedges' Rushe		
Carex cristatella	Crested Oval Sedge	1.00
Carex frankii	Bristly Cattail Sedge	1.00
Carex Iurida	Bottlebrush Sedge	2.00
Carex sparganioides v. cephaloidea	Rough-Clustered Sedge	2.00
Carex vulpinoidea	Brown Fox Sedge	6.00
Eleocharis ovata	Blunt Spike Rush	0.50
Elymus virginicus	Virginia Wild Ry e	12.00
Glyceria striata	Fowl Manna Grass	1.25
Juncus effusus	Common Rush	1.00
Juncus torreyi	Torrey's Rush	0.25
Leersia oryzoides	Rice Cut Grass	1.00
Panicum virgatum	Switch Grass	2.00
Scirpus atrovirens	Dark Green Rush	1.00
Scirpus cyperinus	Wool Grass	0.50
Scirpus fluviatilis	River Bulrush	0.25
Scirpus validus	Great Bulrush	6.00
	Total	45.75
Temporary Cover:		
Avena sativa	Common Oat	360.00
Lolium multiflorum	Annual Rye	116.00
	Total	476.00
Forbs		
Alisma spp.	Water Plantain (Various Mix)	4.25
Asclepias incarnata	Swamp Milkweed	1.50
Bidens spp.	Bidens (Various Mix)	2.00
Helenium autumnale	Sneezeweed	3.00
Mimulus ringens	Monkey Flower	1.00
Penthorum sedoides	Ditch Stonecrop	0.50
Polygonum pensylvanicum	Smartweed	4.00
Rudbeckia subtomentosa	Sweet Black-Ev ed Susan	1.00
Sadittaria latifolia	Broad-Leaf Arrowhead	1.00
Senna hebecarpa	Wild Senna	1.00
Thalictrum dasycarpum	Purple Meadow Rue	2.00
	Total	21.25

Seed Mix 'B'

Low-Profile Prairie Seed Mix		
Botanical Name	Common Name	PLS Ounces/Acre
Botanical Name	Common Name	Ouncesacre
Permanent Grasses:		
Bouteloua curtipendula	Side Oats Grama	10.00
Carex spp.	Prairie Sedge Mix	1.00
Elymus canadensis	Canada Wild Ry e	16.00
Koeleria pyramidata	June Grass	2.00
Panicum virgatum	Switch Grass	1.00
Schizachyrium scoparium	Little Bluestem	28.00
Sporobolus heterolepis	Prairie Dropseed	3.00
	Total	61.00
Temporary Cover:		
Avena sativa	Common Oat	360.00
Lolium multiflorum	Annual Ry e	120.00
	Total	480.00
Forbs:		
Amorpha canescens	Lead Plant	1.00
Anemone cylindrica	Thimbleweed	0.50
Aquilegia canadensis	Wild Columbine	0.50
Asclepias tuberosa	Butterfly Milkweed	2.00
Asciepias tuberosa Aster ericoides	Heath Aster	0.25
Aster laevis	Smooth Blue Aster	0.25
Aster novae-angliae	New England Aster	0.25
Baptisia lactea	White Wild Indigo	1.00
Chamaecrista fasciculata	Partridge Pea	9.00
Coreopsis lanceolata	Sand Coreopsis	1.50
Coreopsis palmata	Prairie Coreopsis	1.00
Dalea candidum	White Prairie Clover	1.50
Dalea purpurea	Purple Prairie Clover	1.50
Echinacea purpurea	Broad-Leaved Purple Coneflower	3.50
Eryngium yuccifolium	Rattlesnake Master	2.50
Kuhunia eupatoides	False Bone-Set	0.50
Lespedeza capitata	Round-Head Bush Clover	2.00
Liatris aspera	Rough Blazing Star	0.50
Lupinus perennis	Wild Lupine	2.00
Monarda fistulosa	Wild Bergamot	0.50
Parthenium integrifolium	Wild Quinine	1.00
Penstemon digitalis	Fox glove Beard Tongue	0.50
Physostegia virginiana	False Dragonhead	0.25
Pycnanthemum virginianum	Common Mountain Mint	1.00
Ratibida pinnata	Y ellow Coneflower	3.00
Rudbeckia hirta	Black-Eyed Susan	2.00
Rudbeckia subtomentosa	Sweet Black-Eved Susan	1.00
Silphium integrifolium	Rosin Weed	0.50
Silphium terebinthinaceum	Prairie Dock	2.00
Solidago nemoralis	Old-Field Goldenrod	0.25
Solidago rigida	Stiff Goldenrod	1.00
Tradescantia ohiensis	Common Spiderwort	0.75
Vernonia spp.	Ironweed (Various Mix)	1.75
Veronicastrum virginianum	Culver's Root	0.25
	Total	49.75

Maintenance Notes

The owner of the property shall be responsible for all maintenance of site landscaping, as follows:

A. Landscaping shall be kept in a neat, orderly and healthy growing condition, free from debris and refuse.

B. Pruning shall be minimal at the time of installation, only to remove dead or diseased branches. Subsequent pruning shall assure proper maturation of plants to achieve their approved purpose.

C. All dead, damaged, or diseased plant material shall be removed immediately and replaced within six (6) months after it dies or in the next planting season, whichever occurs first. For purposes of this section, the planting season for deciduous plants shall be between March 1 and June 1 and from October 1 until the prepared soil becomes frozen. The planting season for evergreen plants shall be between March 1 and June 1. Plant material installed to replace dead or diseased material shall be as close as practical to the size of the material it is intended to replace. The City may notify property owners of the need to replace dead, damaged, or diseased material.

D. The approved landscape plan shall be considered a permanent record and integral part of the Site Plan Approval. Unless otherwise approved in accordance with the aforementioned procedures, any revisions to or removal of plant materials, or non-compliance with the maintenance requirements of this Section 138-12.109 will place the parcel in non-conformity with the approved landscape plan and be a violation of this ordinance.

E. If protected trees are damaged, a fine shall be issued on an inch-by-inch basis at a monetary rate as defined by the Forestry Department.

To assist in maintaining plant materials in a healthy condition, all landscaped areas (including lawns) shall be provided with an automatic, underground, or drip irrigation system, subject to the following:

A. The Planning Department may approve an alternative form of irrigation for a particular site, or may waive this requirement upon determining that underground irrigation is not necessary for the type of proposed plant materials.

B. All automatic irrigation systems shall be designed to minimize water usage, and shall be shut off during water emergencies, periods of protracted rainfall, or water rationing periods.

C. The irrigation requirement may be waived by the reviewing authority if the project incorporates landscaping that will contribute points towards LEED certification or an equivalent rating system.

Whenever a landscape planting screen or other plantings are required under this ordinance, such plantings shall be installed according to accepted good planting procedures and in a sound, workmanlike manner. All plant material shall meet current standards of the American Association of Nurserymen and approved by the American National Standards Institute, Inc. (ANSI 260.1, 1996).


A. All plant material shall be true to name in conformance to the current edition of Standardized Plant Names established by the American Joint Committee on Horticultural Nomenclature, or other source accepted by the City.

B. All plant material shall be nursery grown in a northern climate; hardy to the climate of Michigan; appropriate for the soil, climatic and environmental conditions; and resistant to disease and insect attack.

C. A minimum four (4) inches of topsoil shall be provided for all lawn areas, ground covers, and planting beds.

D. Artificial plant material is prohibited and shall not be used to meet the requirements of this Article.



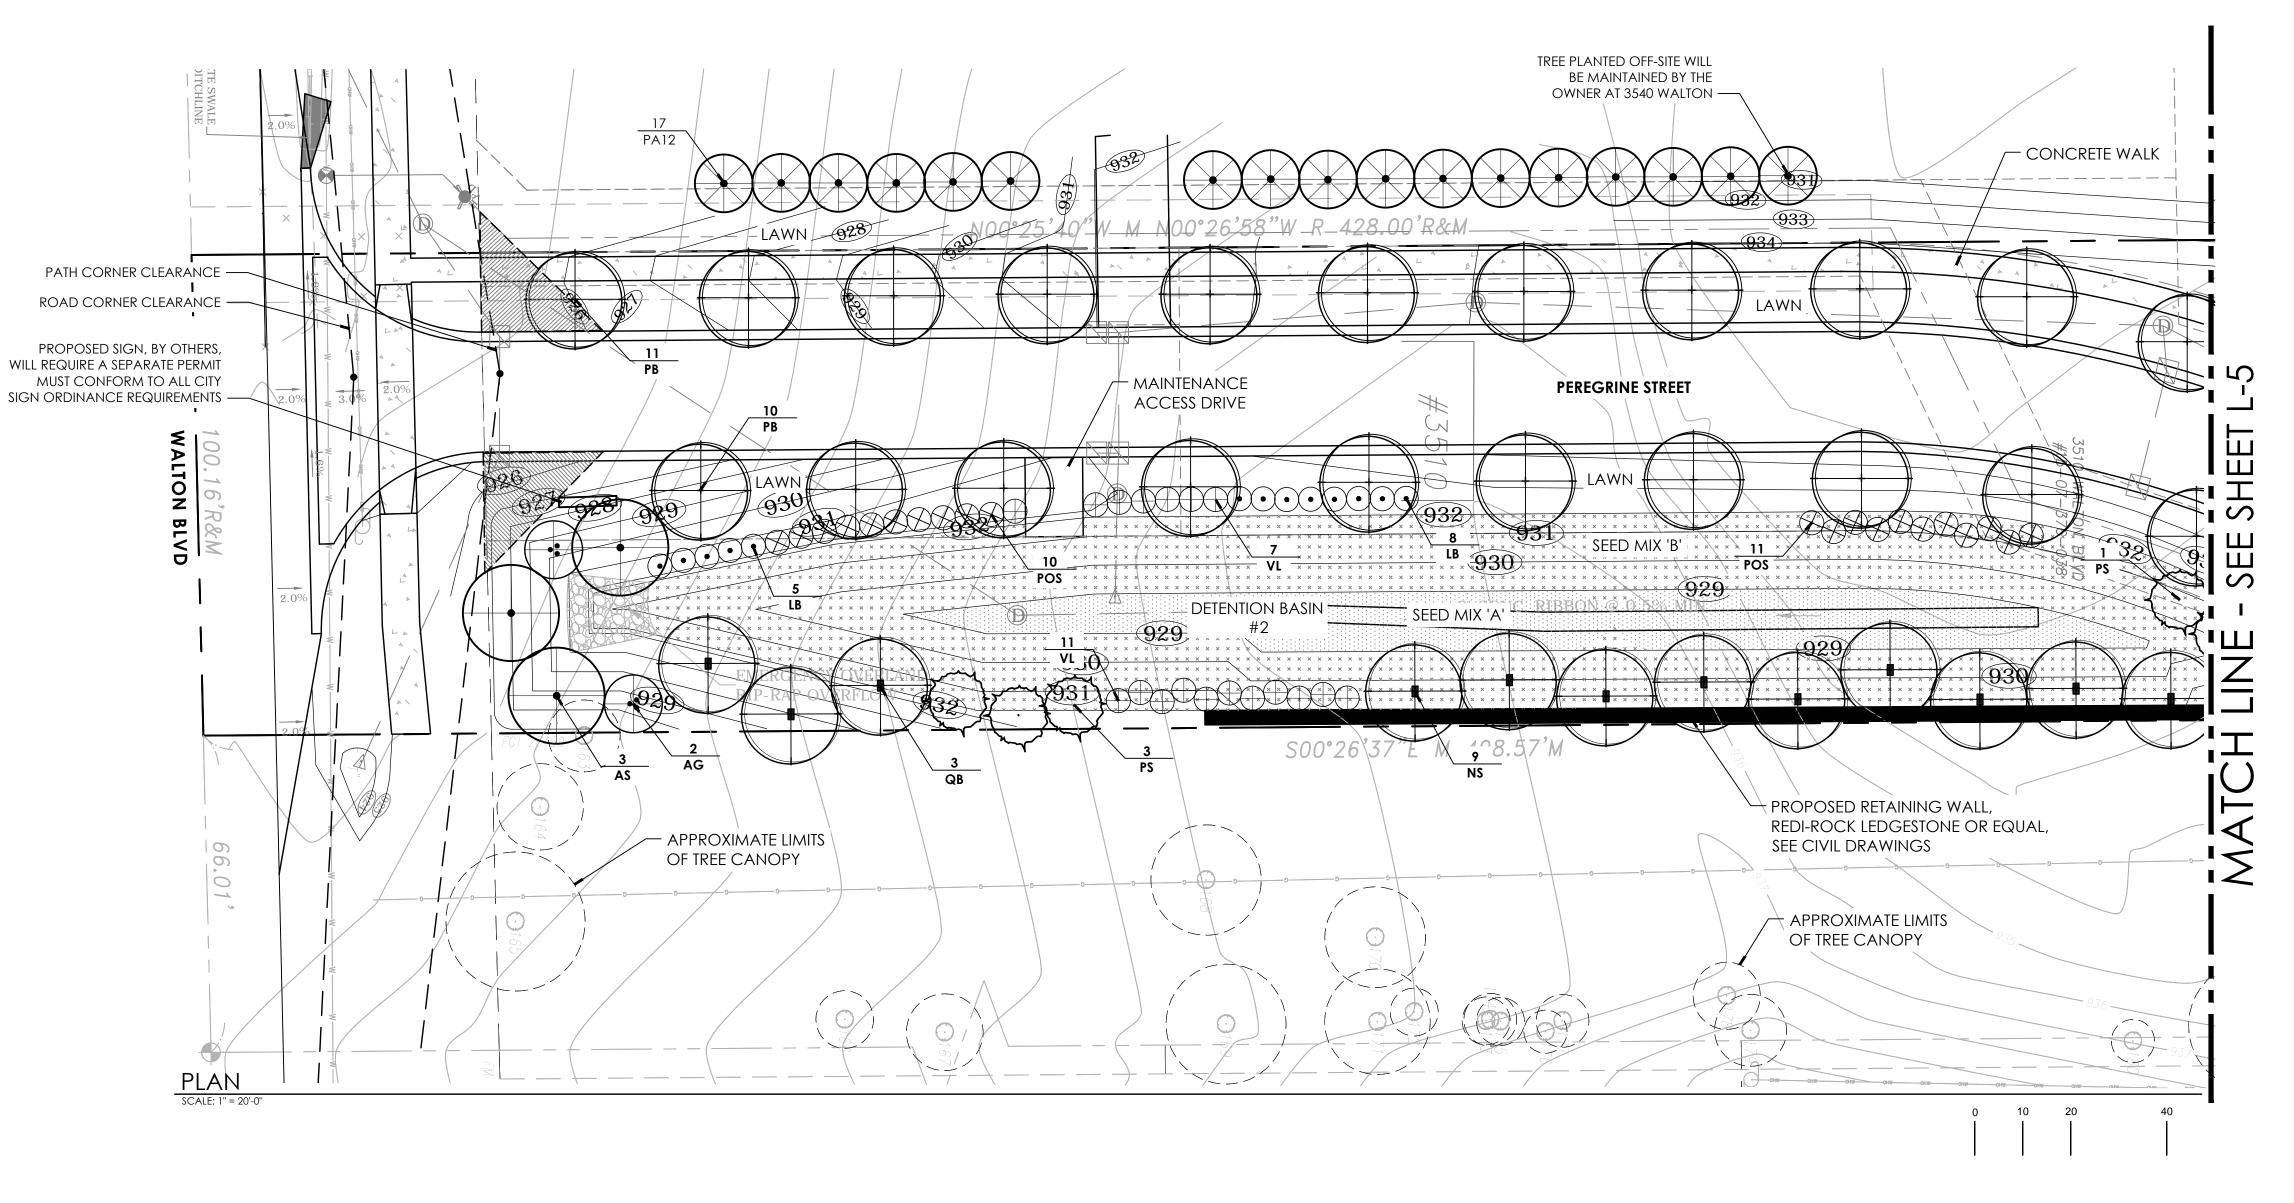

Tree Mitigation Planting Notes

- 1. ALL TREES ARE TO BE PROVIDED BY THE DEVELOPER 2. ALL STREET TREES, FRONTAGE TREES, TREES SHOWN IN COMMON AREAS, AND DETENTION BASIN TREES AND SHRUBS SHALL BE
- PLANTED AS PART OF INITIAL CONSTRUCTION. 3. TREES SHOWN TO BE PLANTED ON INDIVIDUAL LOTS SHALL NOT BE PLANTED UNTIL ALL EXTERIOR WORK ON THE UNIT HAS BEEN
- COMPLETED. 4. PLANTINGS SHALL BE COMPLETED PRIOR TO CERTIFICATE OF
- OCCUPANCY AND SHALL MEET ALL BOND REQUIREMENTS 5. SHOULD MITIGATION PLANTING REQUIREMENTS NOT BE COMPLETED, THE BOND WILL BE WITHHELD AND PUT INTO THE CITY'S TREE FUND FOR MITIGATION ELSEWHERE IN THE CITY

ADDITIONAL NOTES:

- Watering of landscape areas shall only occur between the hours of 12am and 5am
- 2. Prior to the release of the performance bond, the City of Rochester Hills must inspect all landscape plantings
- 3. All lawn and landscape areas, including rights of way shall be fully irrigated and compliant with Section 138-12.105
- 4. Any plant material that is designated to be maintained that dies or in plan damaged during or as a result of construction shall be replaced in kind with like species and sizes
- 5. All landscaping required pursuant to the City of Rochester Codes and plan Ordinances shall be maintained in perpetuity
- 6. After the one year guarantee period, the HOA will be responsible for all restoration and maintenance of the seeded lawn areas as part of their regular lawn maintenance.

Rochester Hills

PLANT SCHEDULE

	FROM	ITAGE	PLANTINGS									
	TREES											
	QTY	SYM	BOTANICAL NAME	COMMON NAME	SIZE	SPACING	ROOT	COMMENTS		UNIT		TOTAL
	2	AG	Amalanchier x g. 'Autumn Brilliance'	Autumn Brilliance Serviceberry	6' ht.	as shown	B&B	Minimum 5 stems	\$	325.00	\$	650.00
	3	AS	Acer s. 'Green Mountain'	Green Mountain Sugar Maple	3" cal.	as shown	B&B	Single straight trunk	\$	450.00		1,350.00
	DETE	NTION	BASIN PLANTINGS									
	TREES											
	QTY	SYM	BOTANICAL NAME	COMMON NAME	SIZE	SPACING	ROOT	COMMENTS				
	24	NS	Nyssa sylvatica	Blackgum	3" cal.	as shown	B&B	Single straight trunk	\$	450.00	\$	10,800.00
	20	PS	Pinus strobus	Eastern White Pine	10' ht.	as shown	B&B	Unsheared, branched to ground	\$	400.00	\$	8,000.00
	6	QB	Quercus bicolor	Swamp White Oak	3" cal.	as shown	B&B	Single straight trunk	\$	450.00	\$	2,700.00
	SHRU	BS										
	35	LB	Lindera benzoin	Spicebush	30" ht.	as shown	cont.	Well rooted	\$	50.00	\$	1,750.00
	52	POS	Physocarpus o. 'Summer Wine'	Summer Wine Ninebark	30" ht.	as shown	cont.	Well rooted	\$	50.00		2,600.00
	24	VL	Viburnum lentago	Nannyberry Vibumum	30" ht.	as shown	cont.	Well rooted	\$	50.00		1,200.00
	TREE	MITIG	ATION PLANTINGS									
	TREES		ATION PLANTINGS									
	IKEE2											
	QTY 49	SYM AC	BOTANICAL NAME Abies concolor	COMMON NAME Concolor Fir	SIZE 8' ht.	SPACING as shown	ROOT B&B	COMMENTS Unsheared, branched to ground	¢	400.00	¢	19,600.00
262 previous	15	AR	Acer r. 'October Glory'	October Glory Red Maple	3" cal.	as shown	B&B	Single straight trunk	φ \$	400.00		6,000.00
	10	AS	Acer s. 'Green Mountain'	Green Mountain Sugar Maple	3" cal.	as shown	B&B	Single straight trunk	\$	400.00		4,000.00
plan	26	LT	Liriodendron tulipfera	Tulip Tree	3" cal.	as shown	B&B	Single straight trunk	\$	400.00		10,400.00
	5	NS	Nyssa sylvatica	Blackgum	2" cal.	as shown	B&B	Single straight trunk	\$	400.00		2,000.00
326 current	19	PA	Picea abies	Norway Spruce	8' ht.	as shown	B&B	Unsheared, branched to ground	\$	400.00		7,600.00
	20	PD	Picea glauca 'Densata'	Black Hills Spruce	8' ht.	as shown	B&B	Unsheared, branched to ground		400.00		8,000.00
plan	18	PM	Pseudotsuga menziesii	Douglas Fir	8' ht.	as shown	B&B	Unsheared, branched to ground		400.00		7,200.00
				Eastern White Pine	8' ht.		B&B					
	26	PS	Pinus strobus	Swamp White Oak	2" cal.	as shown	B&B	Unsheared, branched to ground Single straight trunk		400.00		10,400.00
	14	QB	Quercus bicolor			as shown			\$	400.00		5,600.00
	16	QC	Quercus coccinea	Scarlet Oak	2" cal.	as shown	B&B	Single straight trunk	\$	400.00		6,400.00
	19	QM	Quercus macrocarpa	Burr Oak	3" cal.	as shown	B&B	Single straight trunk	\$	400.00		7,600.00
	5	TA	Tilia americana 'Redmond'	Redmond American Basswood	3" cal.	as shown	B&B	Single straight trunk	\$	400.00		2,000.00
	20		Abies concolor	Concolor Fir	12' ht.	as shown	B&B	Unsheared, branched to ground		450.00		9,000.00
	29		Picea abies	Norway Spruce	12' ht.	as shown	B&B	Unsheared, branched to ground		450.00		13,050.00
	16		Picea glauca 'Densata'	Black Hills Spruce	12' ht.	as shown	B&B	Unsheared, branched to ground		450.00		7,200.00
lls	10 9		Pseudotsuga menziesii Pinus strobus	Douglas Fir Eastem White Pine	12' ht. 12' ht.	as shown as shown	B&B B&B	Unsheared, branched to ground Unsheared, branched to ground		450.00 450.00		4,500.00
]	STRE	ET TRE	<u>ES</u>									
	TREES								-			
	QTY	SYM	BOTANICAL NAME	COMMON NAME	SIZE	SPACING	ROOT	COMMENTS				
	21	PB	Platanus x. acerifolia 'Bloodgood'	Bloodgood London Plane Tree	2.5" cal.	as shown	B&B	Single straight trunk	\$	425.00		8,925.0
	23	UAV	Ulmus americana 'Valley Forge'	Valley Forge American Elm	2.5" cal.	as shown	B&B	Single straight trunk	\$	425.00	\$	9,775.00
								Irrigation estimate			\$	15,000.00

Site Landscape Calculations

ROW Frontage - See Sheet L-6 Street Frontage (Walton Blvd.) Deciduous Trees Required Deciduous Trees Provided

Ornamental Trees Required Ornamental Trees Provided

Street Trees - internal road Road Length Deciduous Trees Required Deciduous Trees Provided

NOTE: See Sheet L-6 for Plant Schedule & Seed Mixes

City Planting Note

Prior approval is required to plant any tree or shrub on the public right-of-way. All trees and shrubs must be planted at least 10' from the edge of the public road. (Trees must be planted at least 15' away from curb or road edge where the speed limit is more than 35 mph.) Shade trees and shrubs must be planted at least 5' from the edge of the public walkway. Evergreen and ornamental trees must be planted at least 10' from the edge of the public walkway. No trees or shrubs may be planted within the triangular area formed at the intersection of any street right-of-way lines at a distance along each line of 25' from their point of intersection. No trees or shrubs may be planted in the triangular area formed at the intersection of any driveway with a public walkway at a distance along each line of 15' from their point of intersection. All trees and shrubs must be planted at least 10' from any fire hydrant. Shade and evergreen trees must be at least 15' away from the nearest overhead wire. Trees must be planted a minimum of 5' from an underground utility, unless the city's Landscape Architect requires a greater distance. Prior to the release of the performance bond, the City of Rochester Hills Forestry Unit needs to inspect all trees, existing or planted, to identify any that pose a hazard to the safe use of the public right-of-way. Forestry may require the developer to remove, and possibly replace, any such trees. The above requirements are incorporated into the plan.

Final tree locations shall be coordinated with the Office of Planning and the Engineering Department to ensure proper location relative to utility and easement locations.





08.30.2021 04.04.2022 07.22.2022 10.04.2022 11.07.2022 01.03.2023 03.15.2023

Preliminary PUD Review

Project:

Issued For

Revision

Revision

Revision

Revision

Revision

Revision

WALTON OAKS A Planned Unit Development

East Walton Boulevard Rochester Hills, Michigan

Project Sponsor:

Three Oaks Communities, LLC P.O. Box 8307 Ann Arbor, MI 48107

Sheet Name:

Landscape Plan South



Drawn:	JG	
Checked:	JG	
Date:	06.2021	
Scale:	AS NOTED	

	Project Number:
	22.004
	Sheet Number:
	L-4
© 2	2022Vert Verde Landscape Architecture, LLC

100.16 LF 3 Trees (100.16' / 35') 3 Trees
2 Trees (100.16' / 60') 2 Trees

1,505 LF 43 Trees (1,505' / 35') 44 Trees

Detention Basin Landscape Basin #1Perimeter Deciduous Trees Required Deciduous Trees Provided Evergreen Trees Required Evergreen Trees Provided Shrubs Required Shrubs Provided

> Basin #2 Perimeter Deciduous Trees Required Deciduous Trees Provided Evergreen Trees Required Evergreen Trees Provided Shrubs Required

Shrubs Provided

1,198 LF 18 (1,198' / 100')*1.5 18 12 (1,198' / 100') 12 48 (1,198' / 100')*4 69


741 LF 12 (741' / 100')*1.5 12 8 (741' / 100') 30 (741' / 100')*4


52

JSC2022-0002 PSP2022-000

Received 3/16/2023 ina & Ecc

NOT FOR CONSTRUCTION

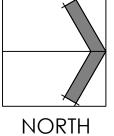

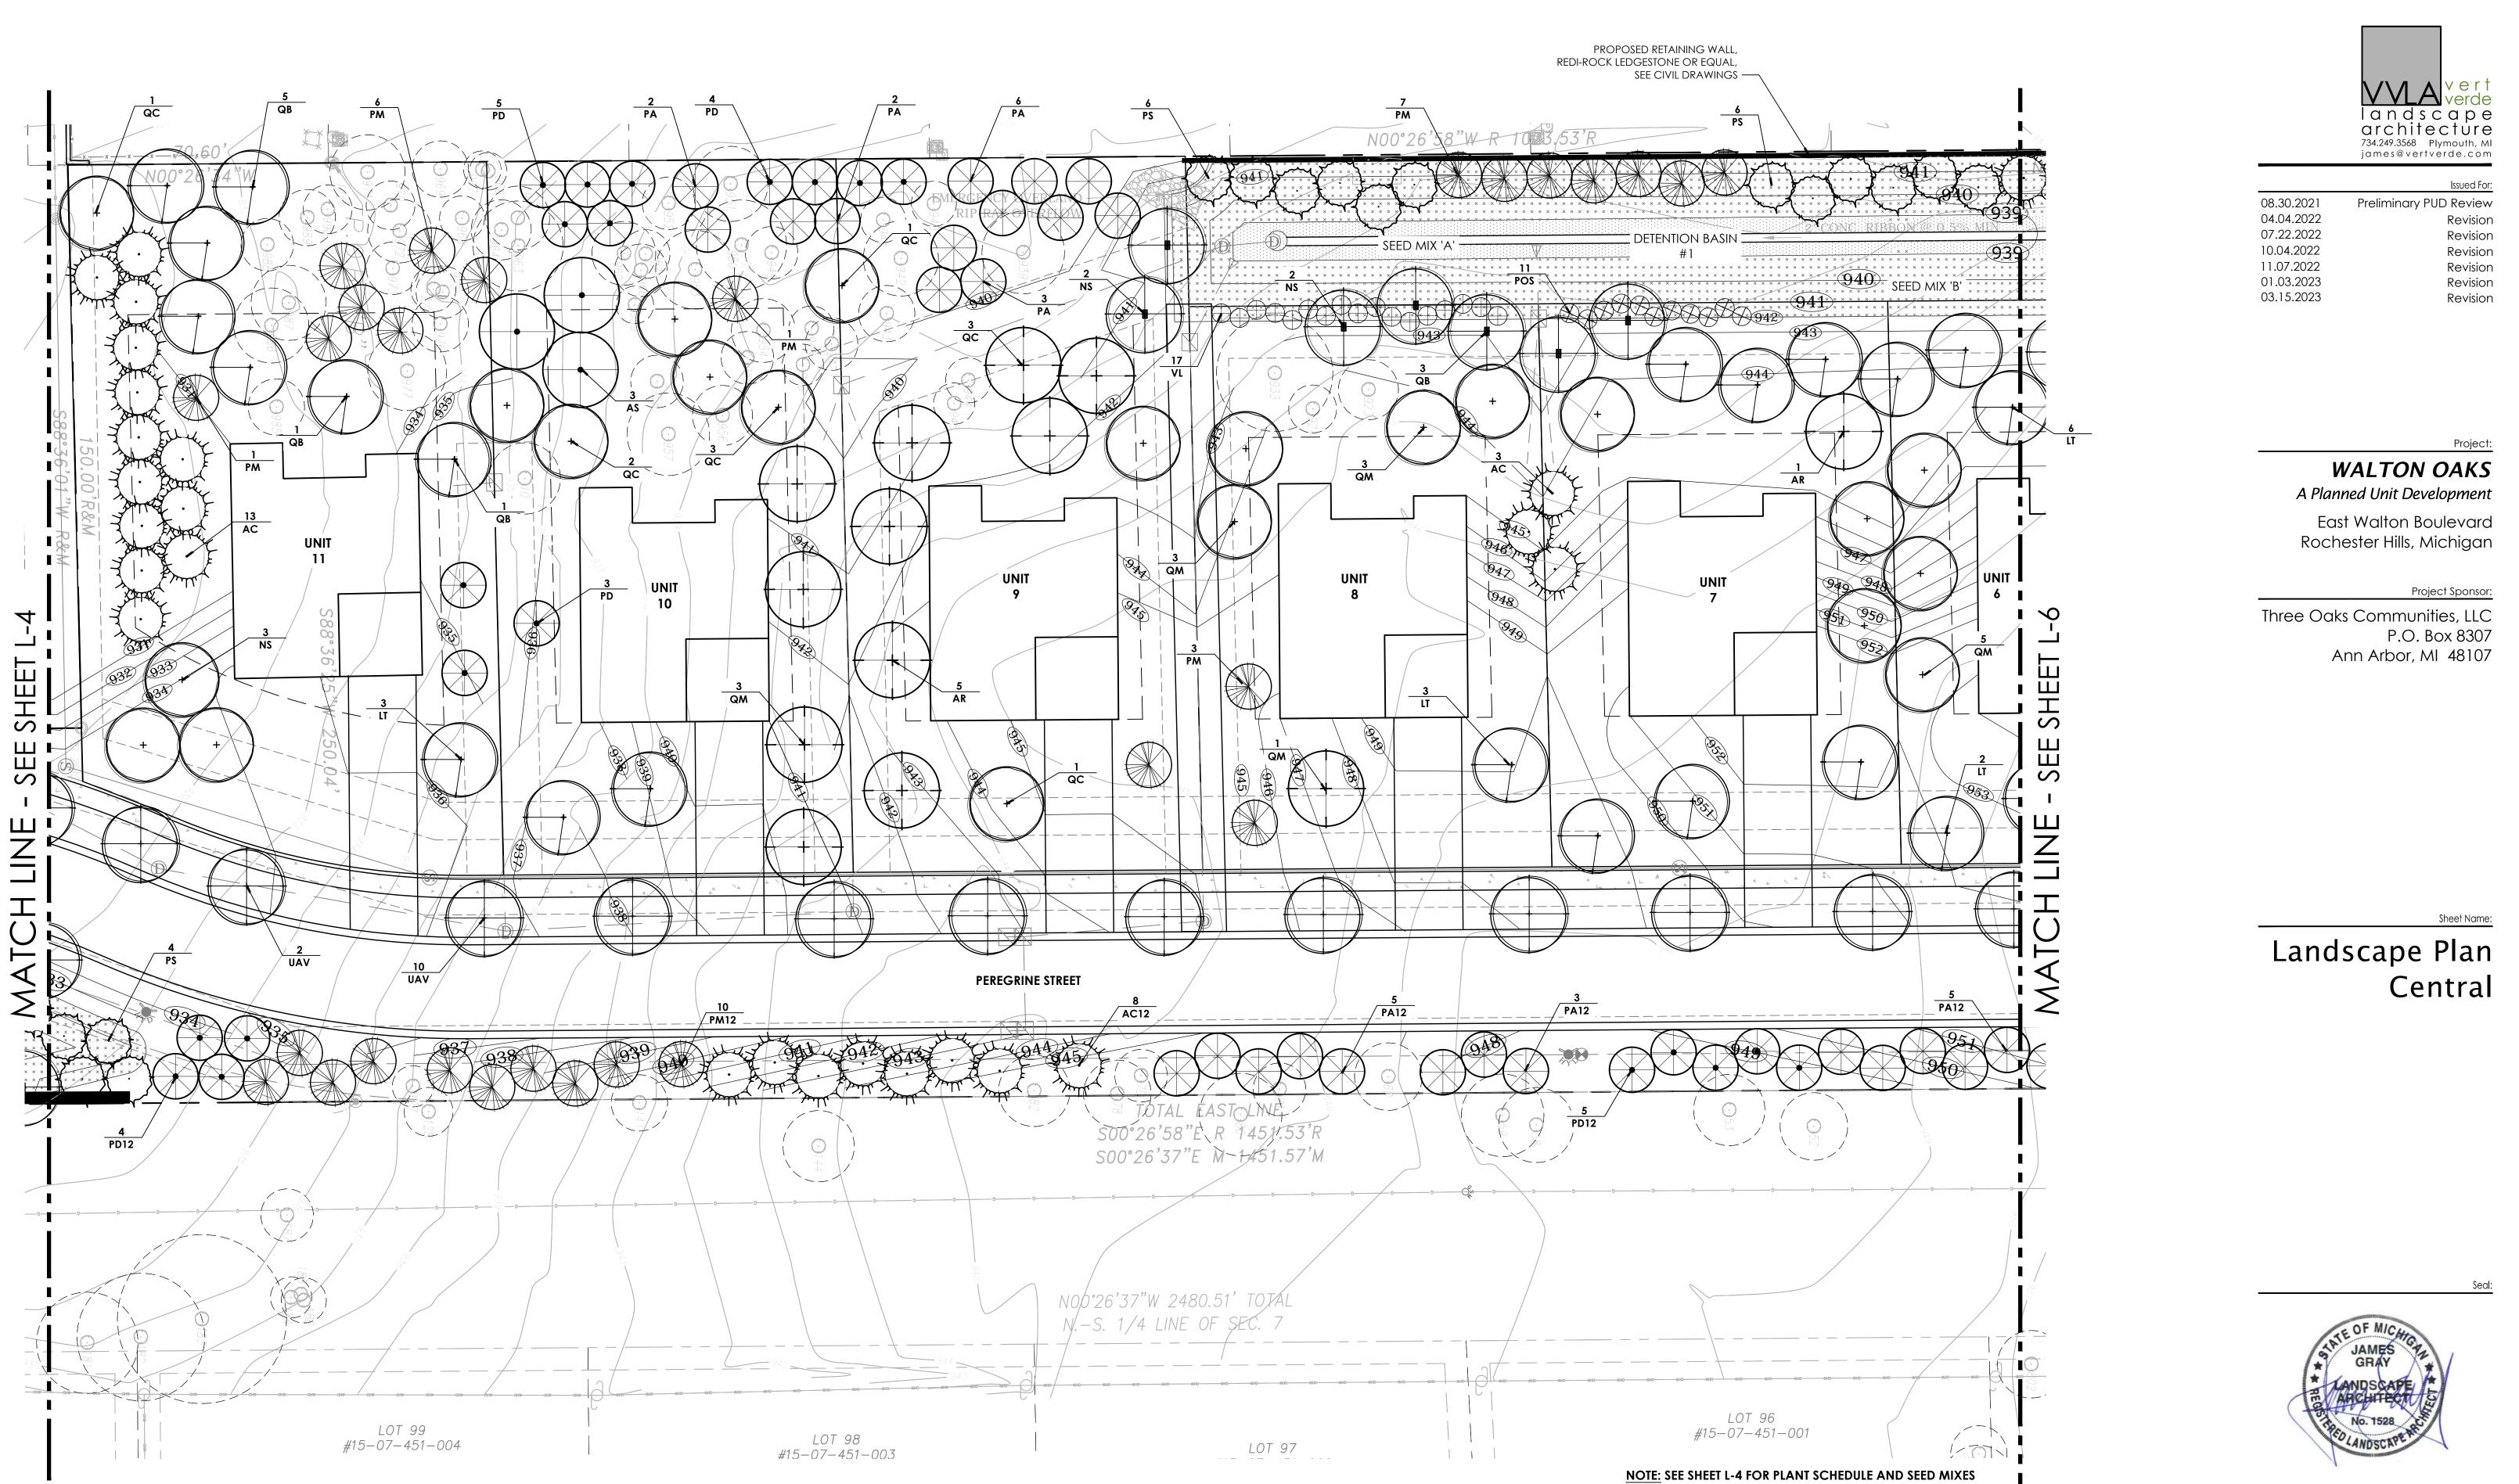





JG JG Checked: 06.2021 Date: 1'' = 20'-0'' Scale:

Project Numbe	r:
22.004	╞
Sheet Numbe	r:
L-5	•
© 2022Vert Verde Landscape Architecture, LLC	


JSC2022-0002 PSP2022-0005 Revision 5

Received 3/16/2023 City of Rochester H Planning & Econom Development

SCALE: 1" = 20'-0"

NOT FOR CONSTRUCTION

NORTH

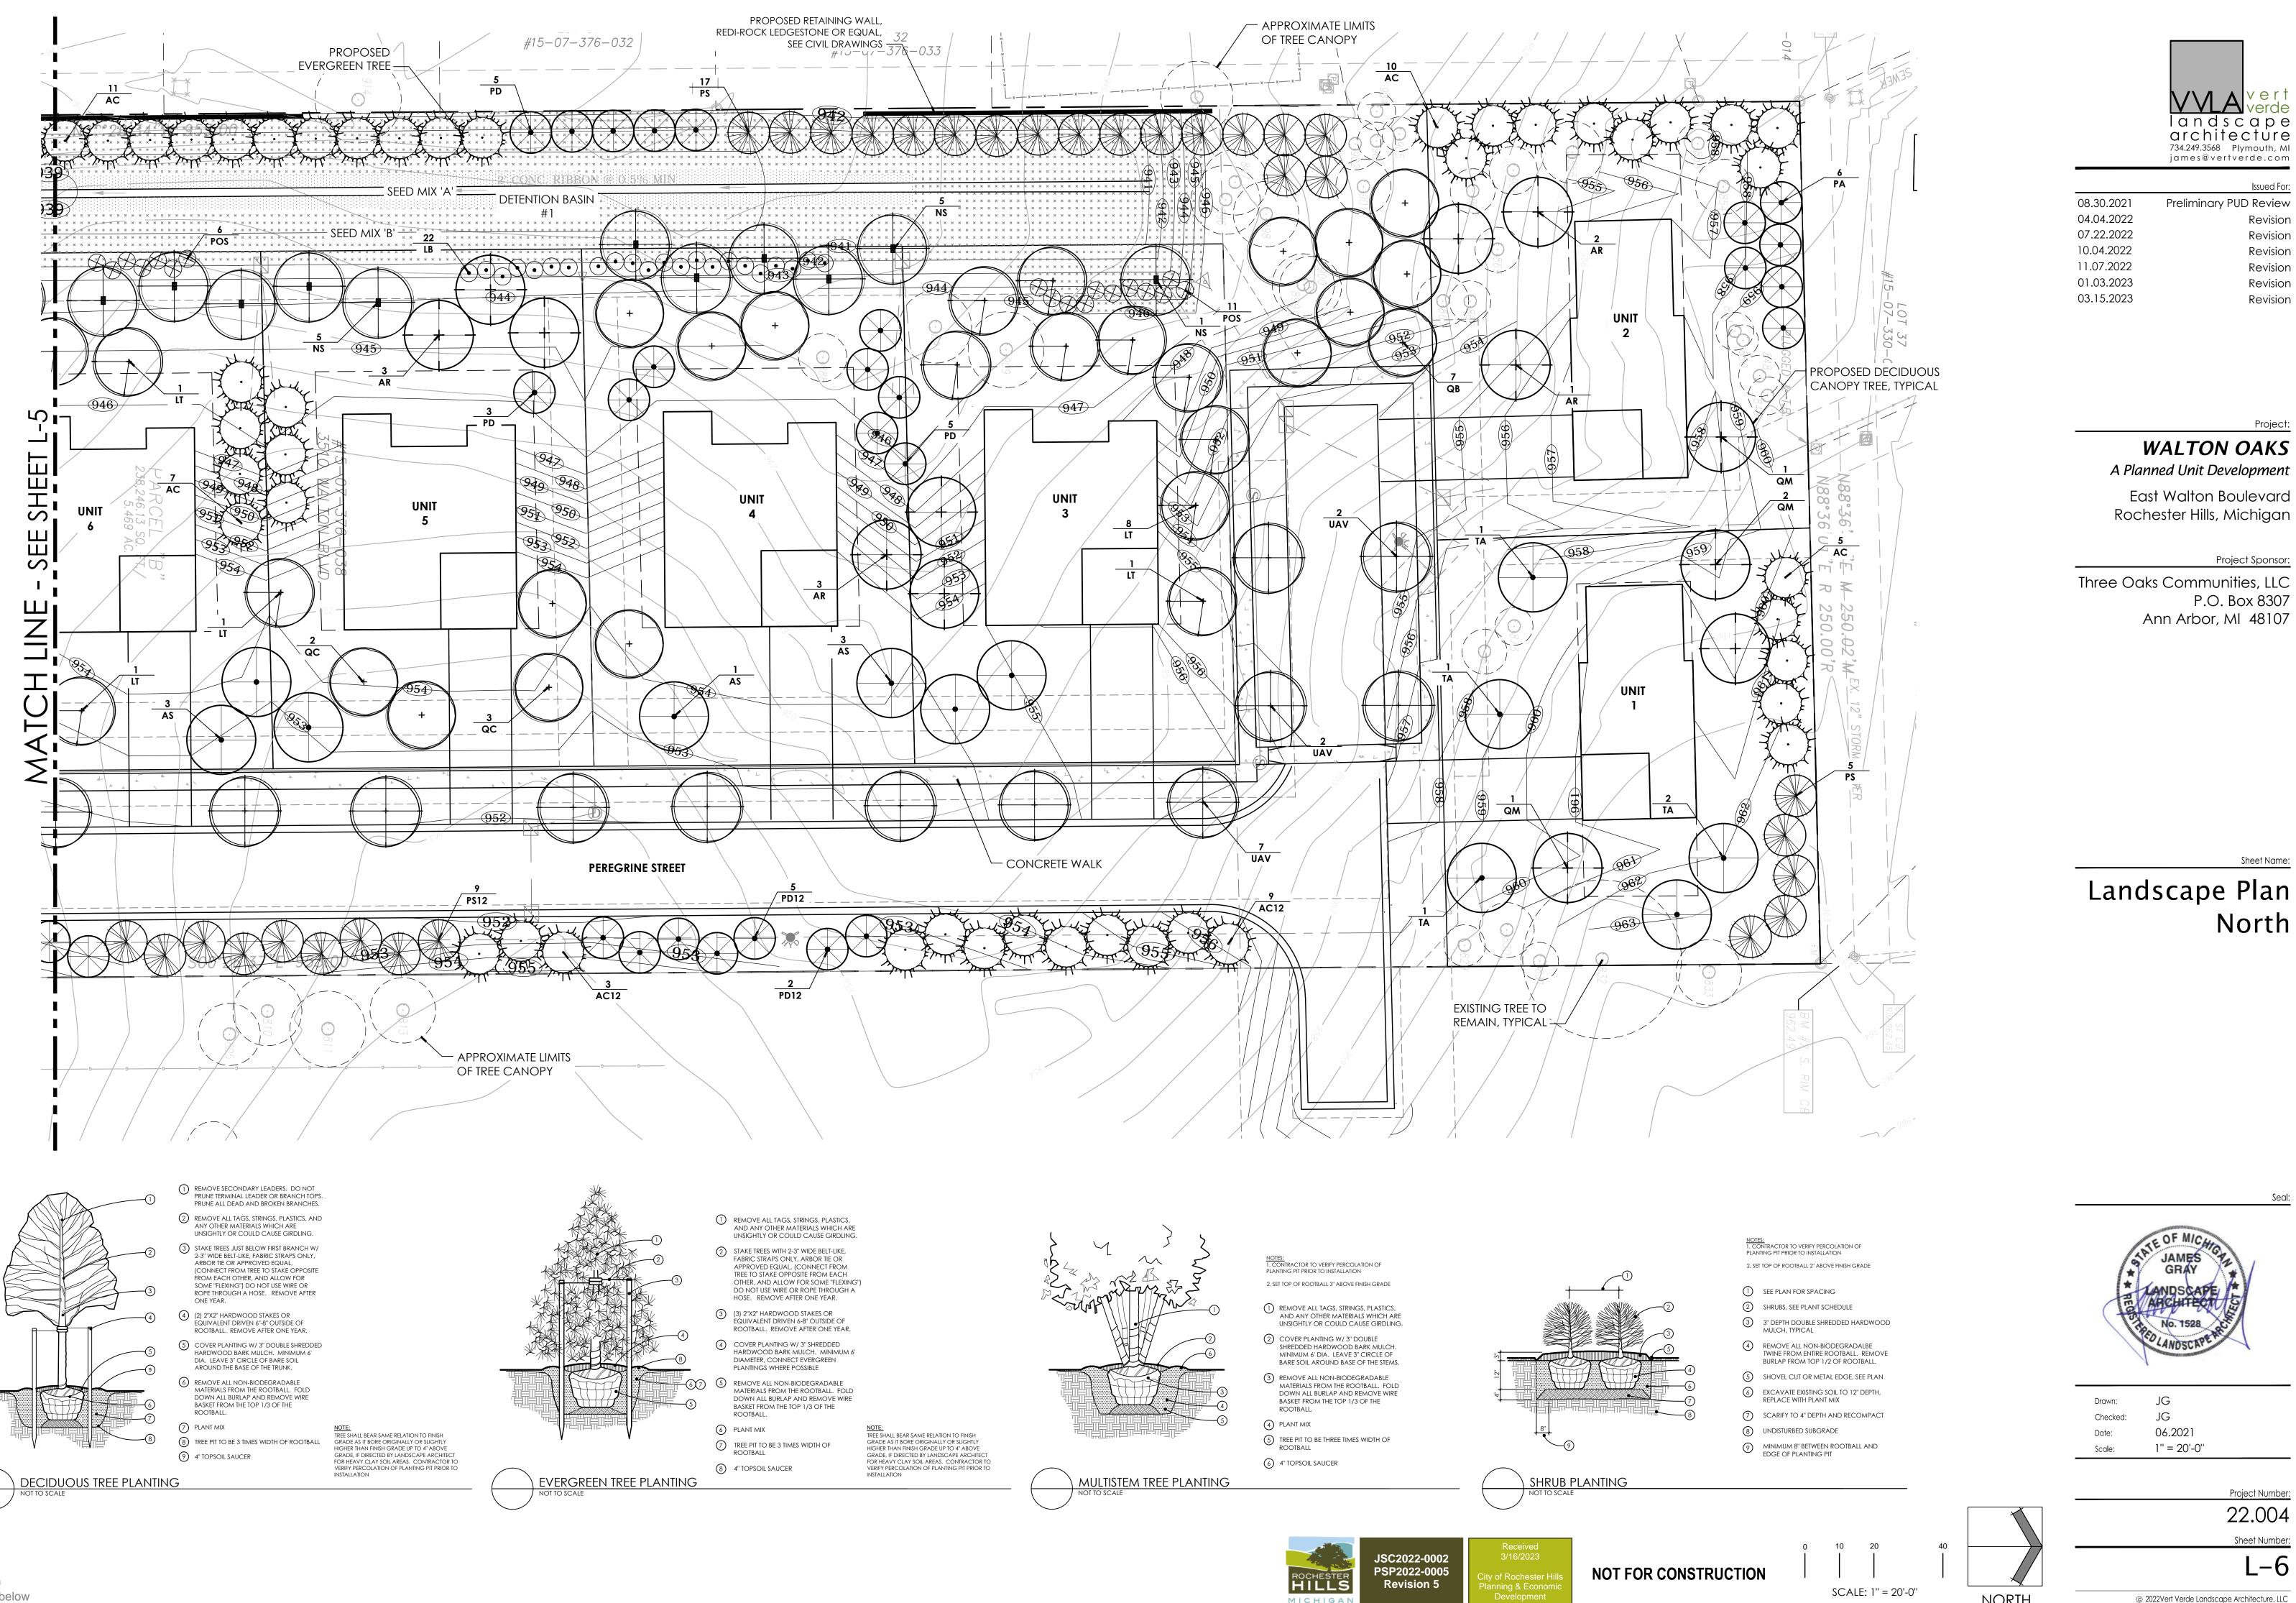

811 Know what's below Call before you dig MISS DIG System, Inc. www.missdig.net







NORTH









JSC2022-0002 PSP2022-0005 Revision 5 Received 3/16/2023

City of Rochester Hills Planning & Economic Development

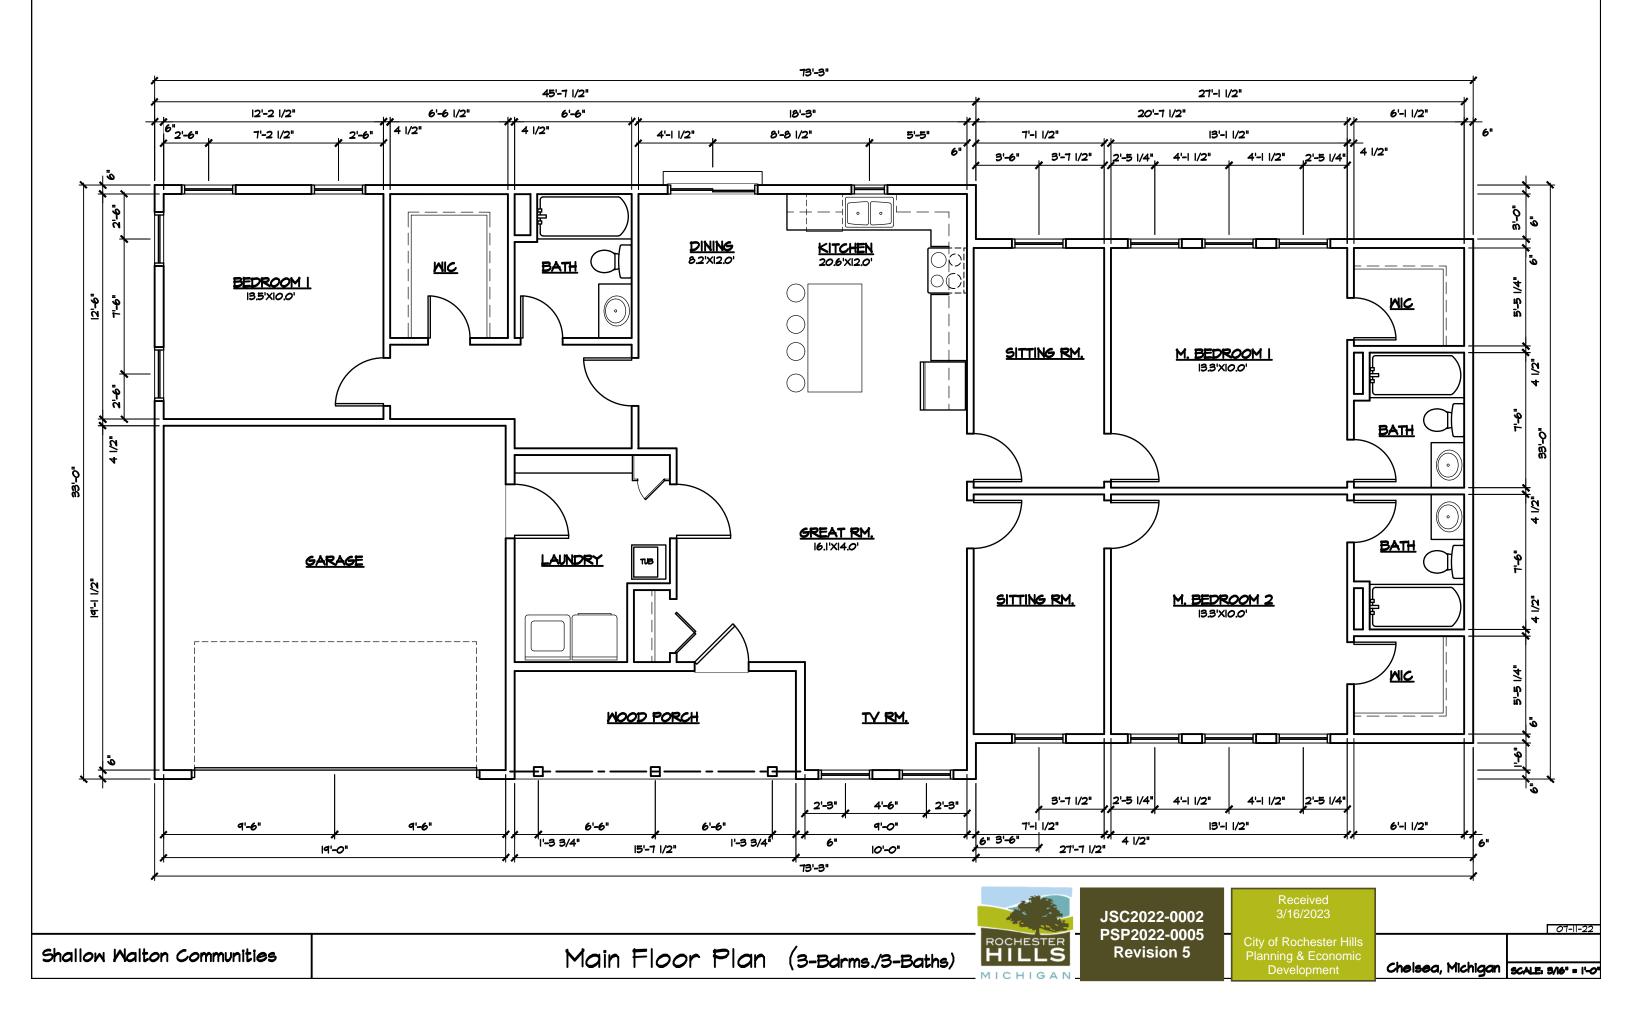

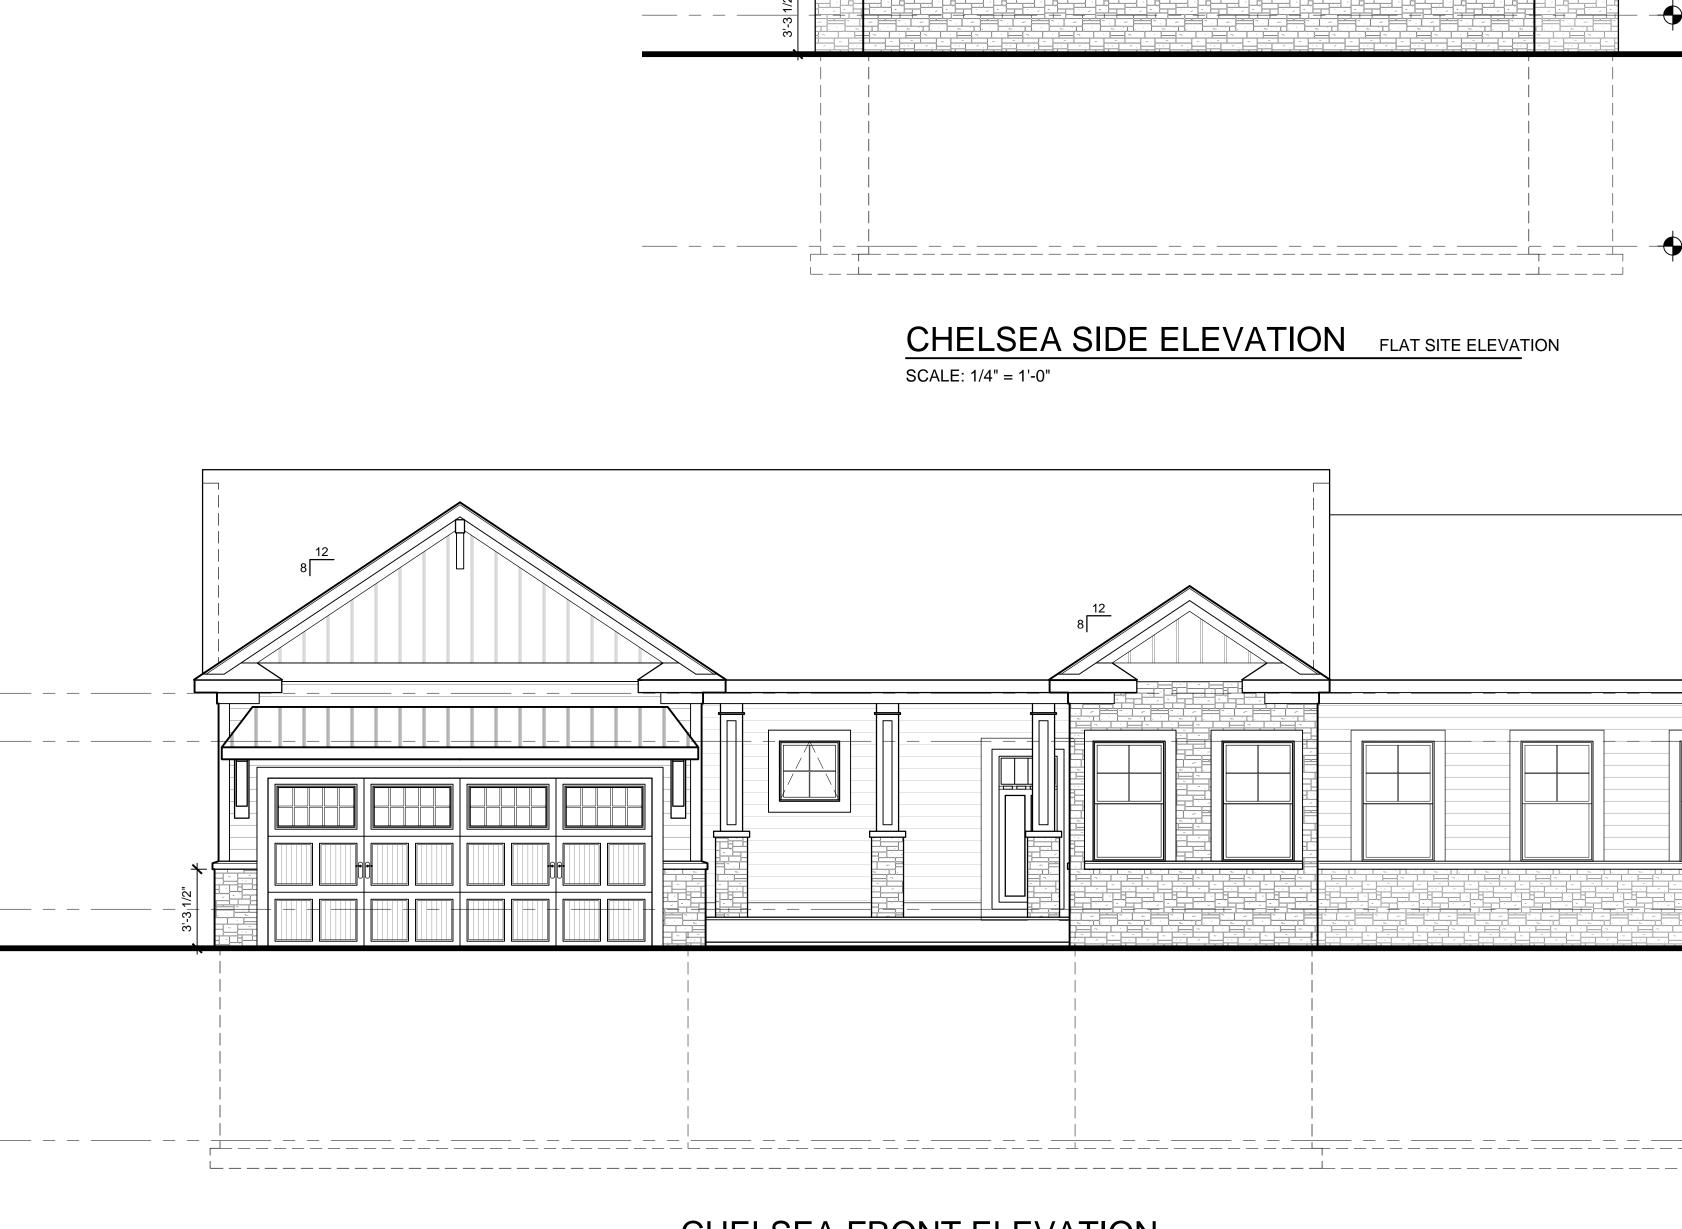




.

.

.

JSC2022-0002 PSP2022-0005 Revision 5

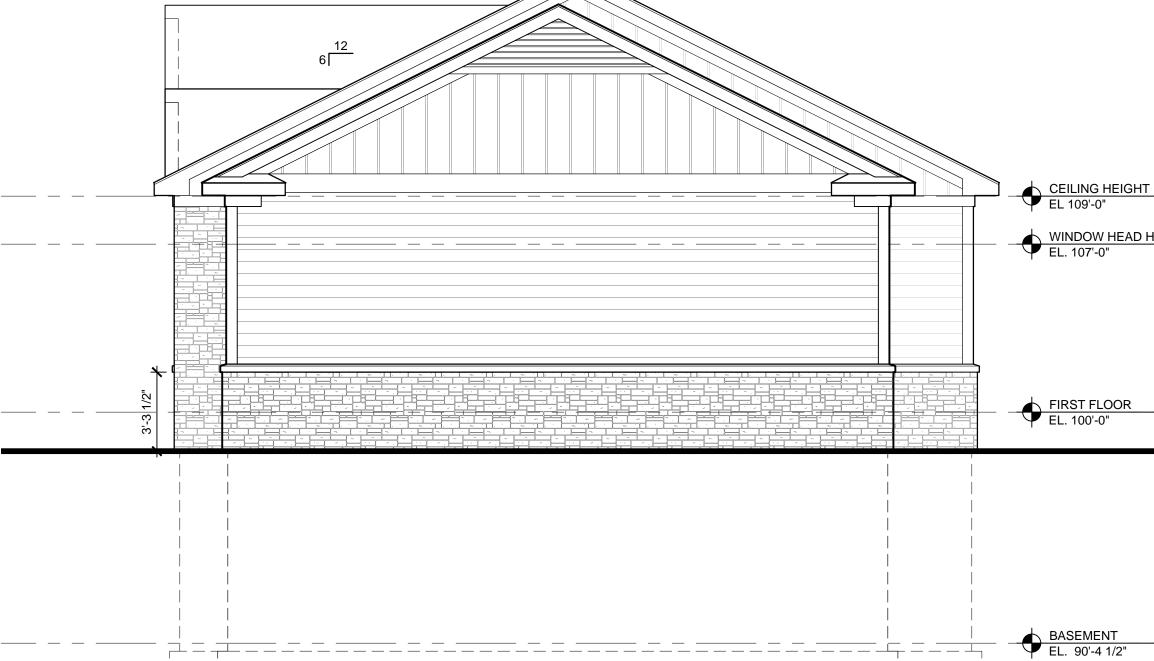

.

CHELSEA FRONT ELEVATION BASE ELEVATION SCALE: 1/4" = 1'-0" PRELIMINARY NOT FOR CONSTRUCTION

Received 3/16/2023 ity of Rochester Hil Planning & Economi Development

CEILING HEIGHT EL 109'-0"

FIRST FLOOR EL. 100'-0"

BASEMENT EL. 90'-4 1/2"


WINDOW HEAD HEIGHT EL. 107'-0"

JBMA Project No.		
221156		
©2023		
A2.1		

Е	levations

Review	12.12.22

KS Communities Shallow - Walton Oaks Elevatior Oaks The Chelsea S

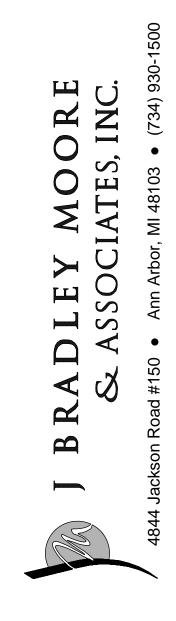

FIRST FLOOR EL. 100'-0"

WINDOW HEAD HEIGHT EL. 107'-0"

•